




Notes

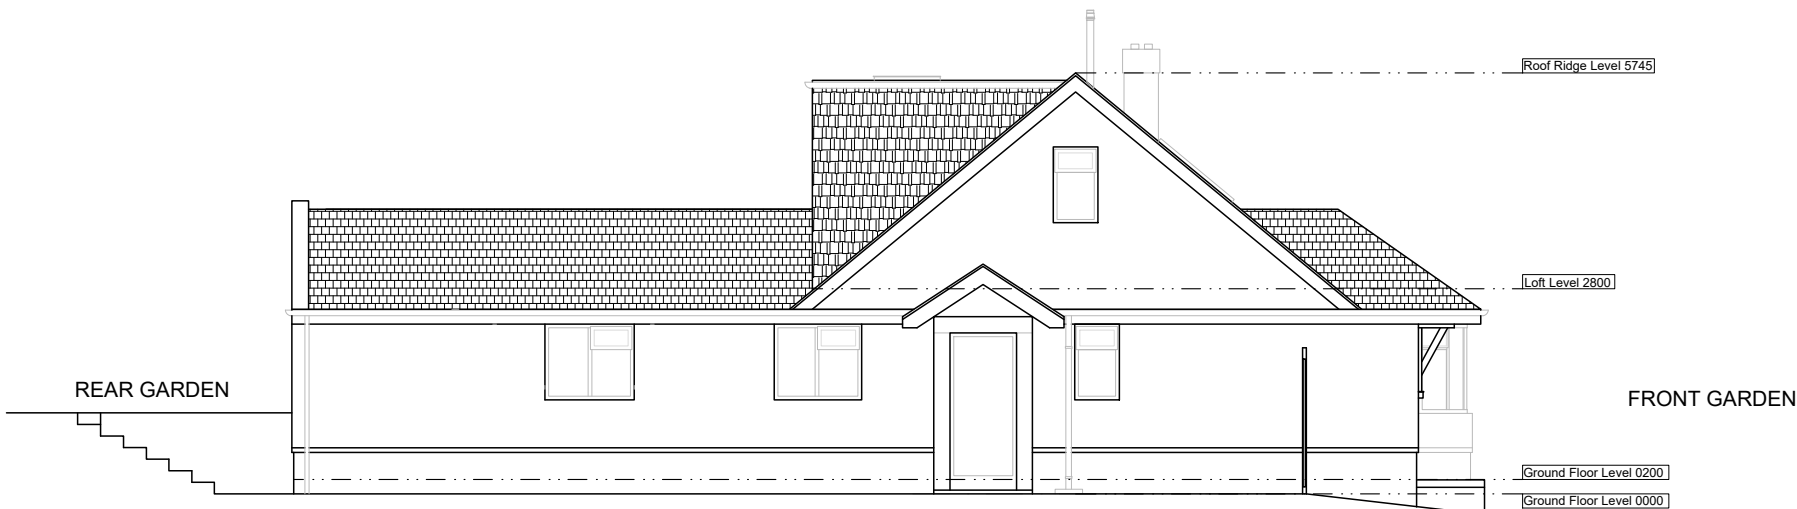

Proposed East Elevation

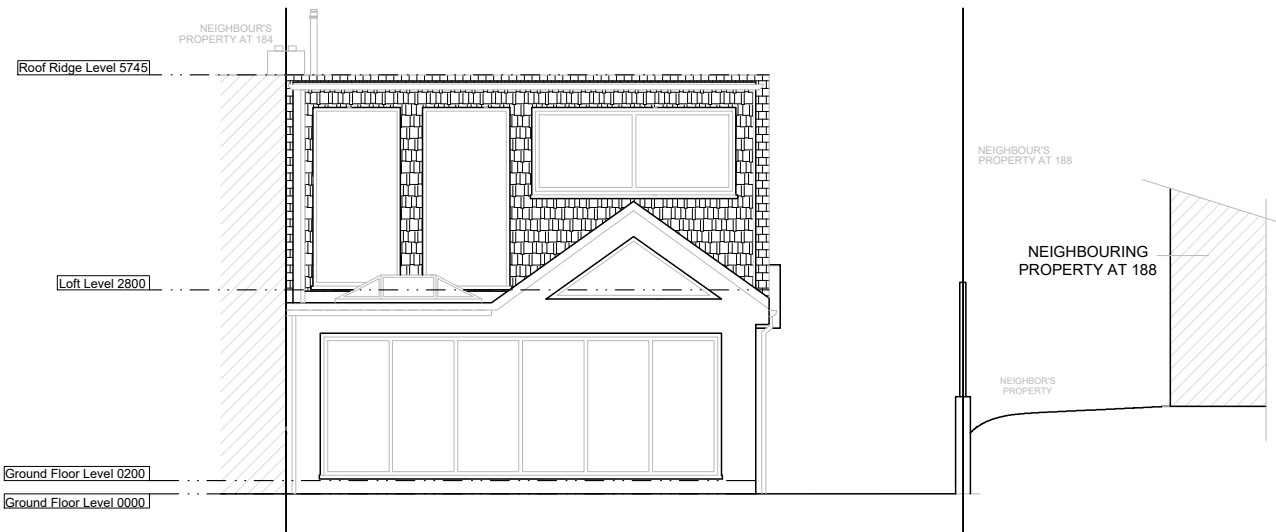

Proposed Rear Elevation

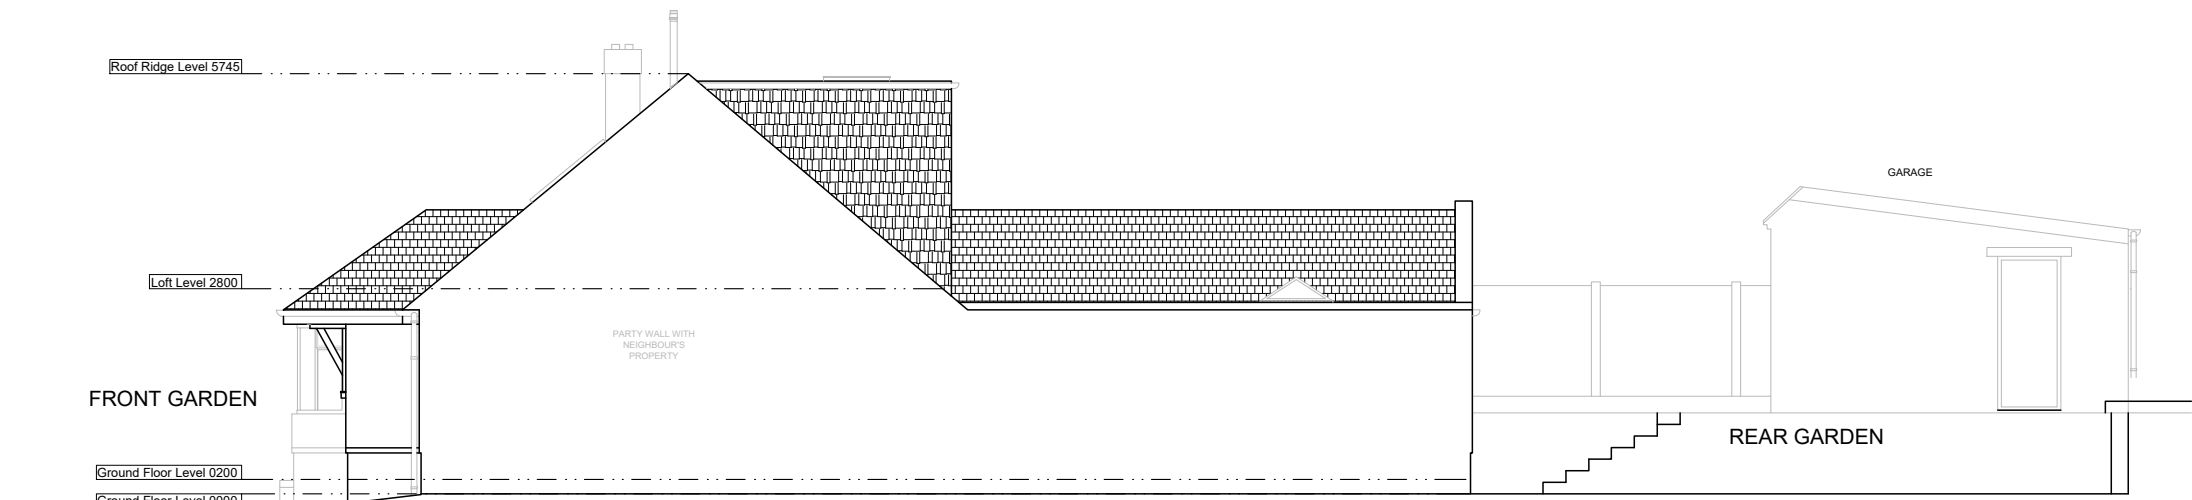

Proposed West Elevation

AS BUILT



Contact Info:
E: info@ubuntuheritage.com

Client:
Optimumcare4u
3 Amberley Court, Whitworth Rd,
County Oak, Crawley
RH11 7XL
T: +44 203 985 1400

Site:
186 Whitehill Road
Hertfordshire SG4 9HY

Title:
Proposed Elevations
Planning

Drawn by:
SS

Checked by:
SMS

Date:
01.04.2025

Drawing Ref.
OC2501-UHL-PL-ZZ-DR-0002_00

Scale: 1:100 @ A2



Disclaimer:
Drawing not intended for purposes of
construction. Do not scale off drawings except
for purposes of planning.