





SECTION A - A
SCALE 1:100




SECTION B - B
SCALE 1:100

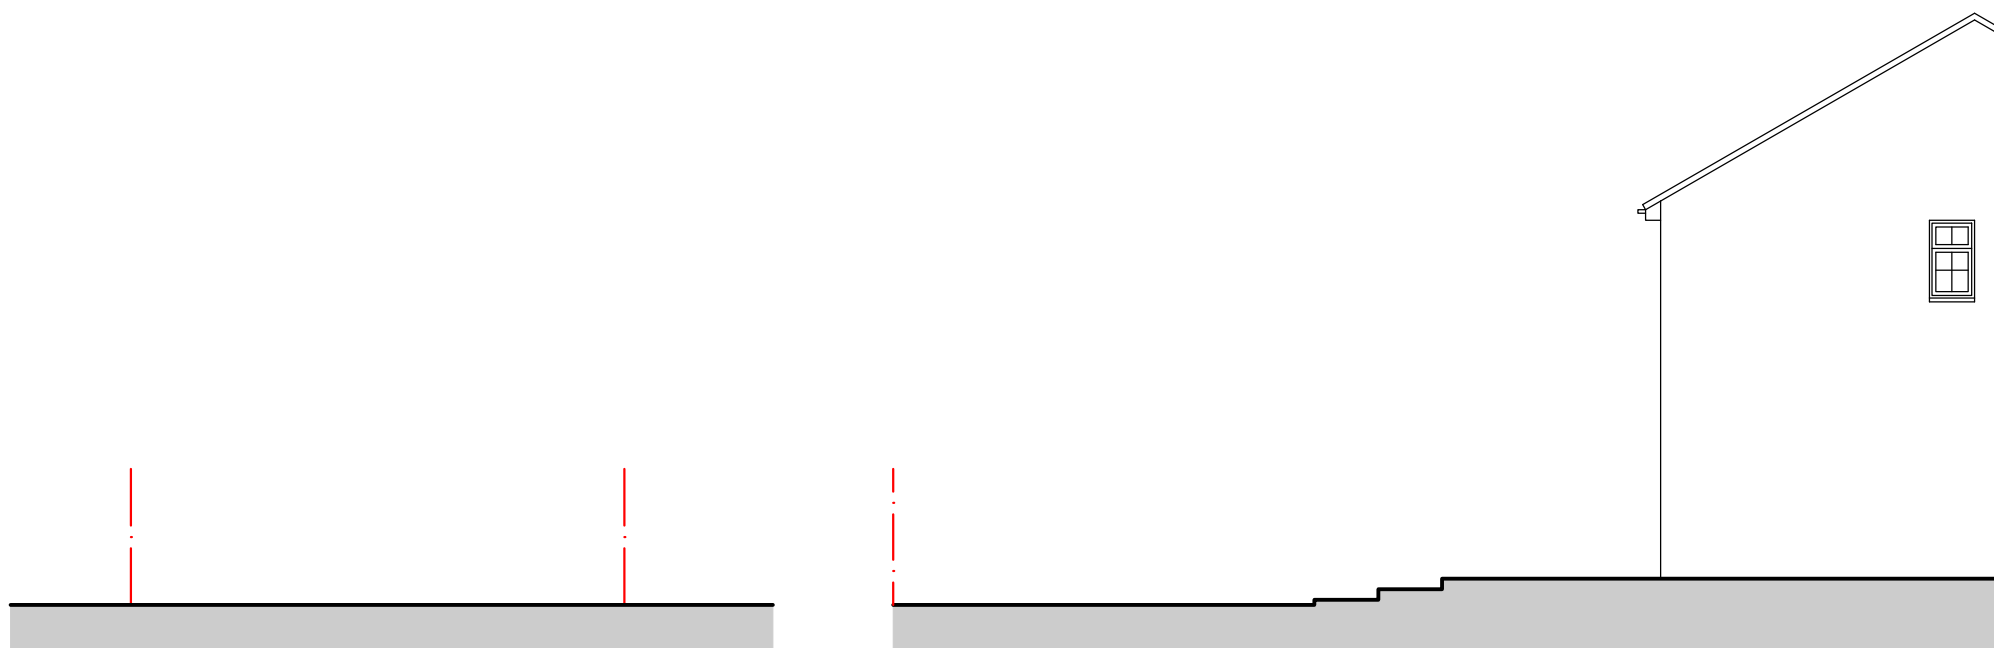

EXISTING OS MAP
SCALE 1:1250

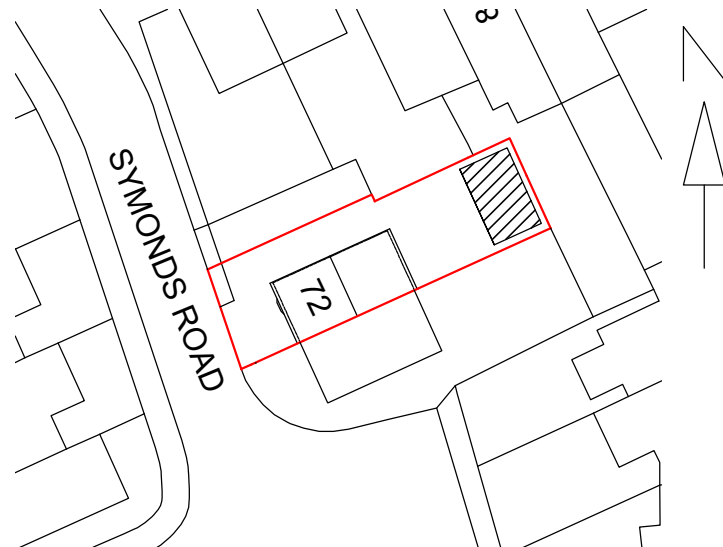


PROPOSED BLOCK PLAN
SCALE 1:500

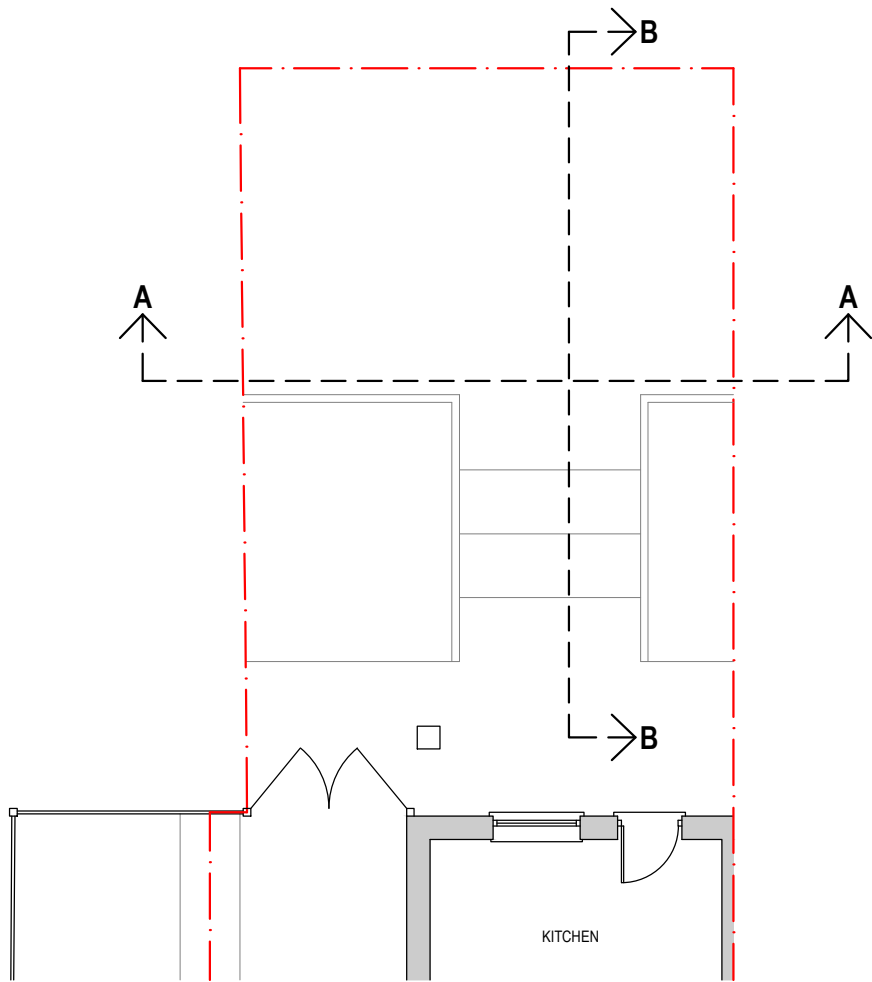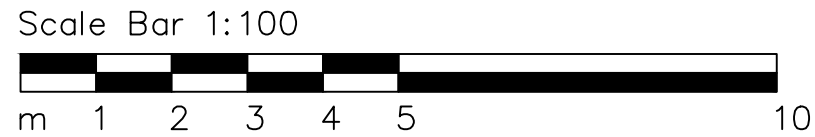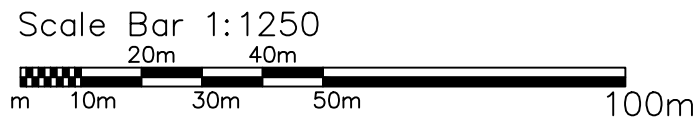


GROUND FLOOR PLAN
SCALE 1:100

EXISTING

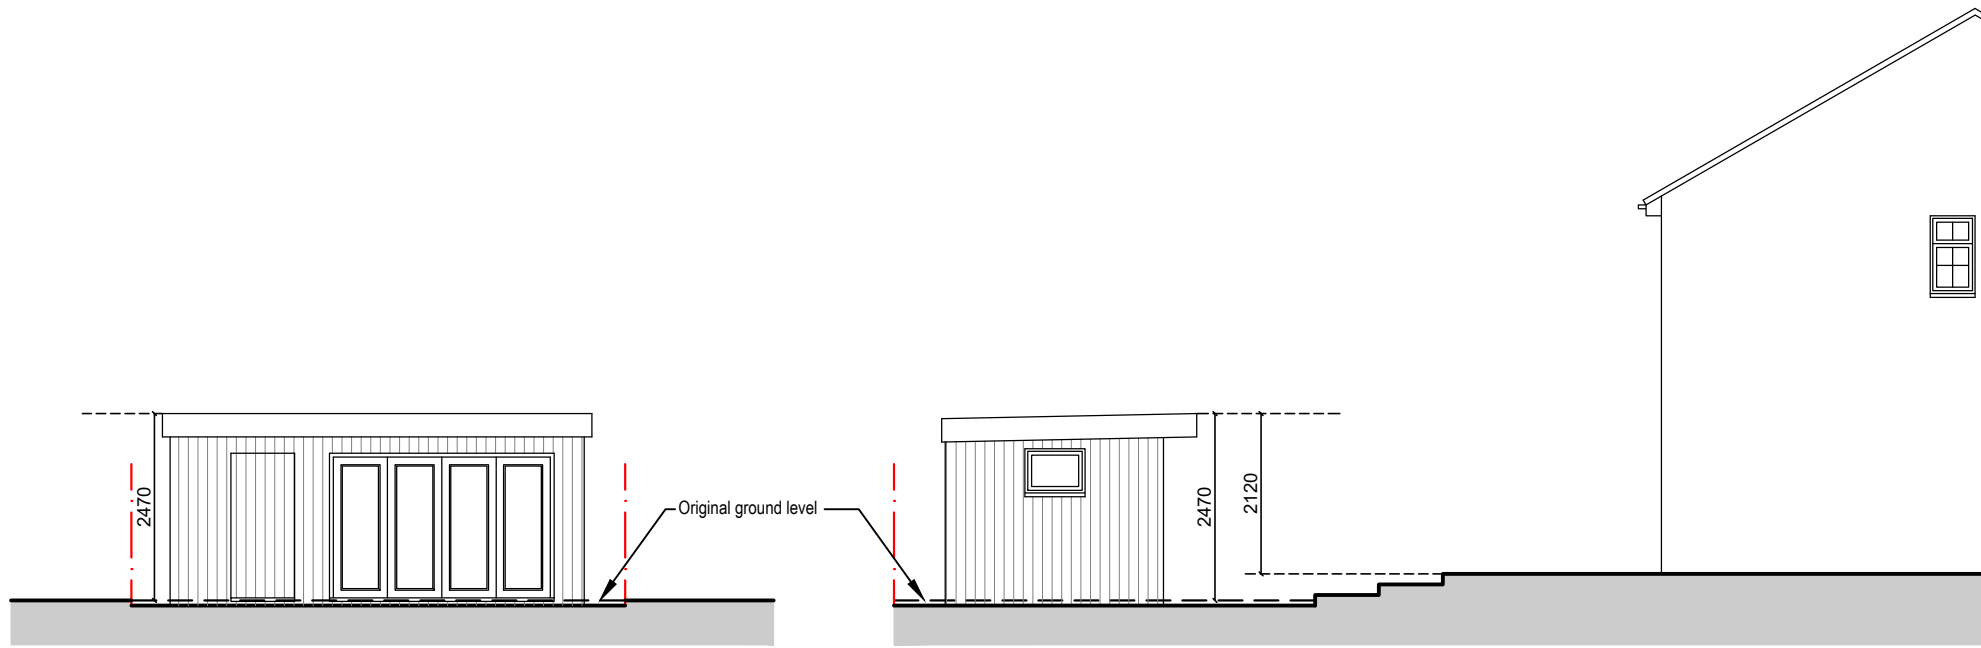


SECTION A - A
SCALE 1:100


SECTION B - B
SCALE 1:100

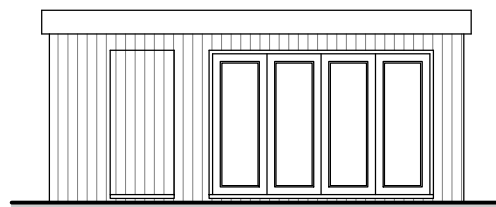


FRONT ELEVATION
SCALE 1:100

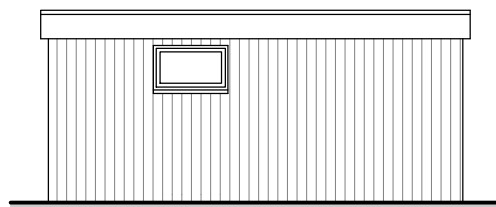


REAR ELEVATION
SCALE 1:100

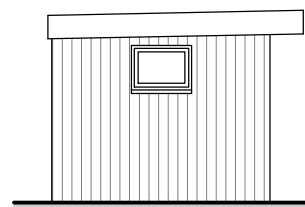

SIDE ELEVATION (1)
SCALE 1:100

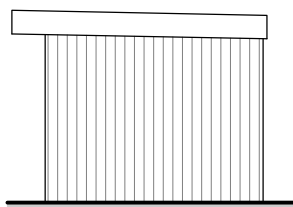


SIDE ELEVATION (2)
SCALE 1:100

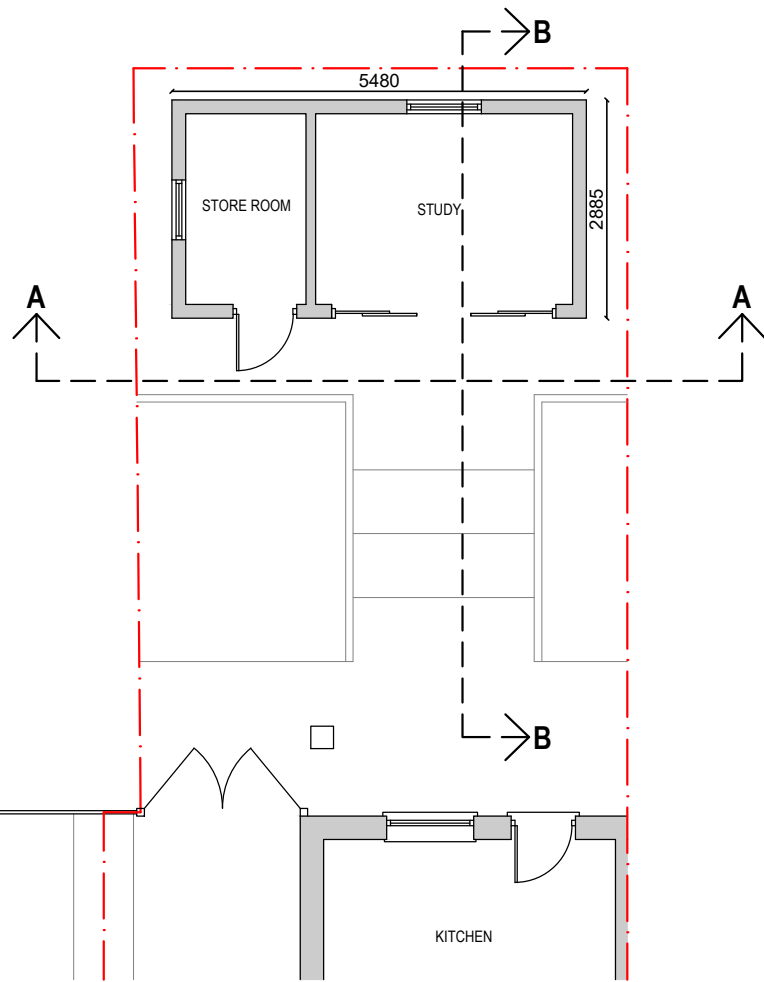

GROUND FLOOR PLAN
SCALE 1:100

AS BUILT

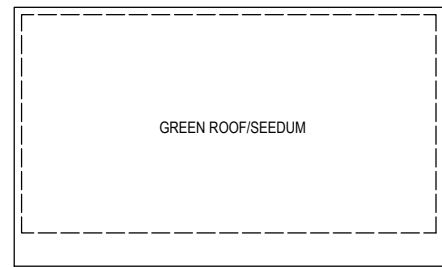

ROOF PLAN
SCALE 1:100

This drawing is copyright and can not be copied or reproduced or altered, no extracts or any elements of this drawing or supporting information unless written consent has been obtained first.

REV	DATE	DESCRIPTION
RTMDesign Architectural Services Planning & Building Regulation Drawings		
5 Prebendal Drive, Slip End, LU1 4JN M 07979 575 456 E enquiries@rtmdesign.co.uk		
CLIENT MR & MRS LUQUE		
ADDRESS 72 SYMONDS ROAD HITCHIN HERTFORDSHIRE SG5 2JL		
TITLE CERTIFICATE OF LAWFULNESS (EXISTING) EXISTING/AS BUILT PLANS AND ELEVATIONS WITH OS MAP AND BLOCK PLAN		
SCALE - AS SHOWN @ A2		DATE - AUG '25
JOB No. 799	DRAWING No. PL_01	REVISION A