




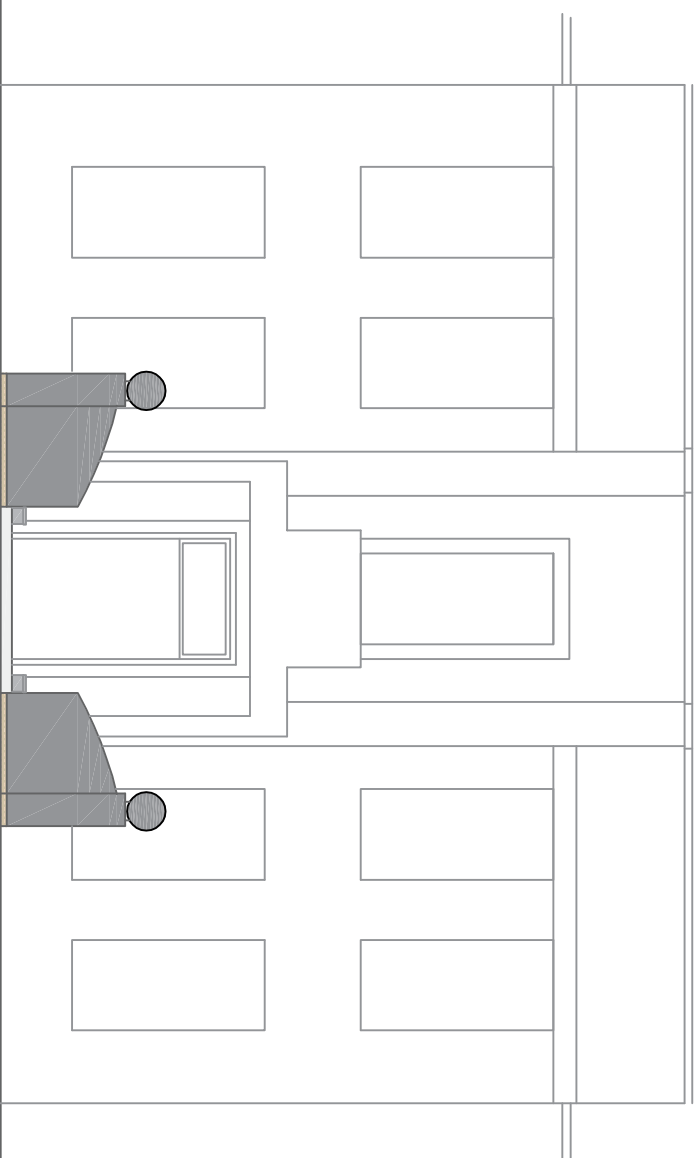

As-Built front elevation (1:100 scale)

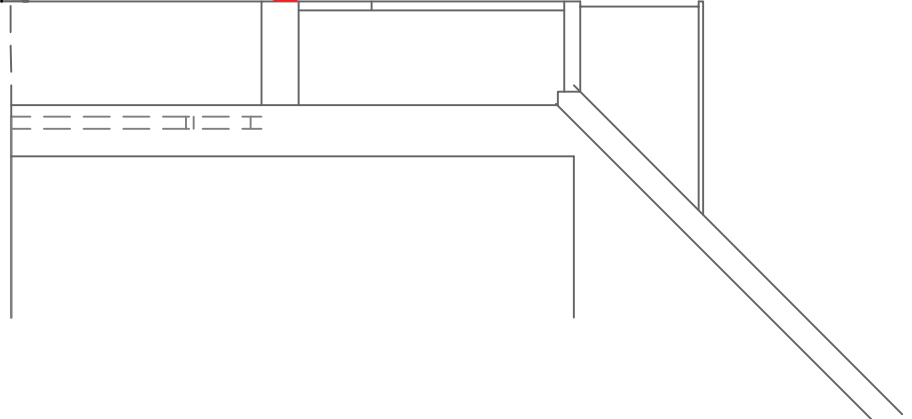

As-Built side elevation (1:100 scale)

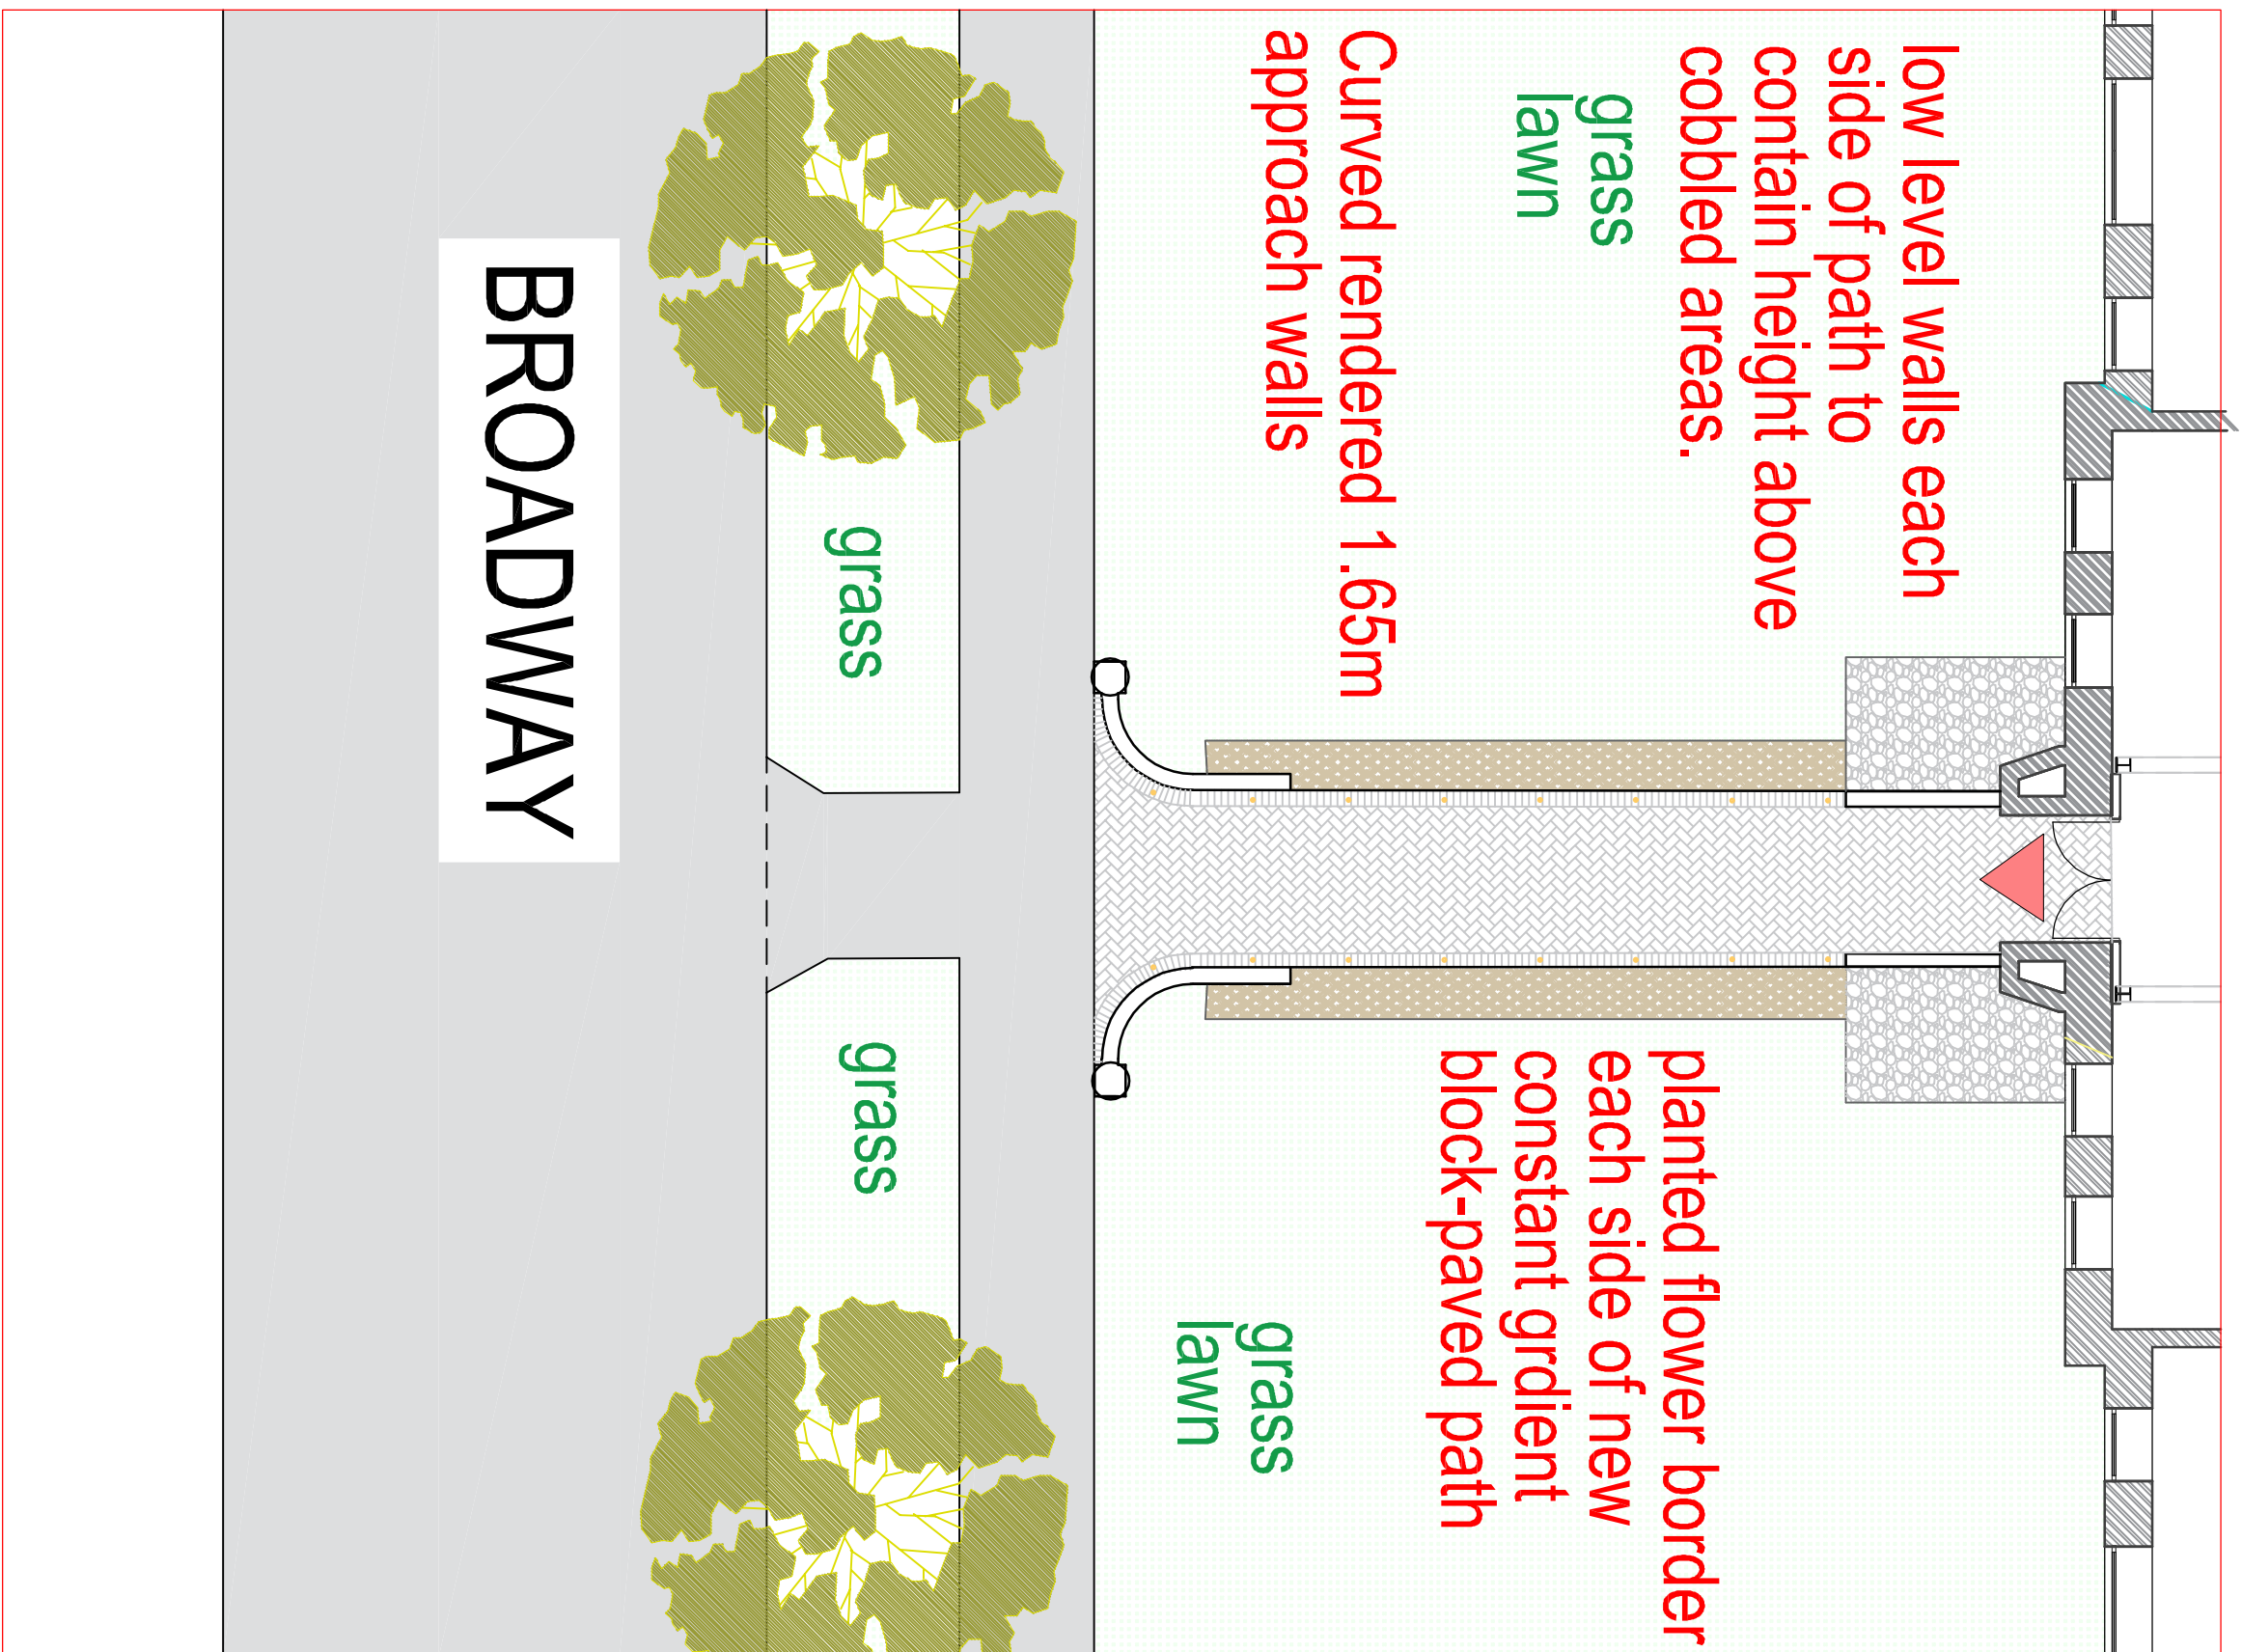

For location see drawing 101

As-Built plan (1:100 scale)

REVISION	DESCRIPTION	DATE
October 2024	CLIENT PROJECT	
1:250 1:500, 1:1250	Emil-Dale School of Performing Arts Ltd. Old Grammar School, Letchworth.	
DRAWING STATUS	DRAWING TITLE	
NO UNAUTHORISED PERFORMING OR REPRODUCTION ALLOWED © COPYRIGHT 2024	New walls and path to front entrance.	
 Burton & Associates Ltd. 65 Sharnford Road Clutton Beds. SG4 3BQ Tel. / Fax. 01455 550000 Ref:6796-1 102A		