



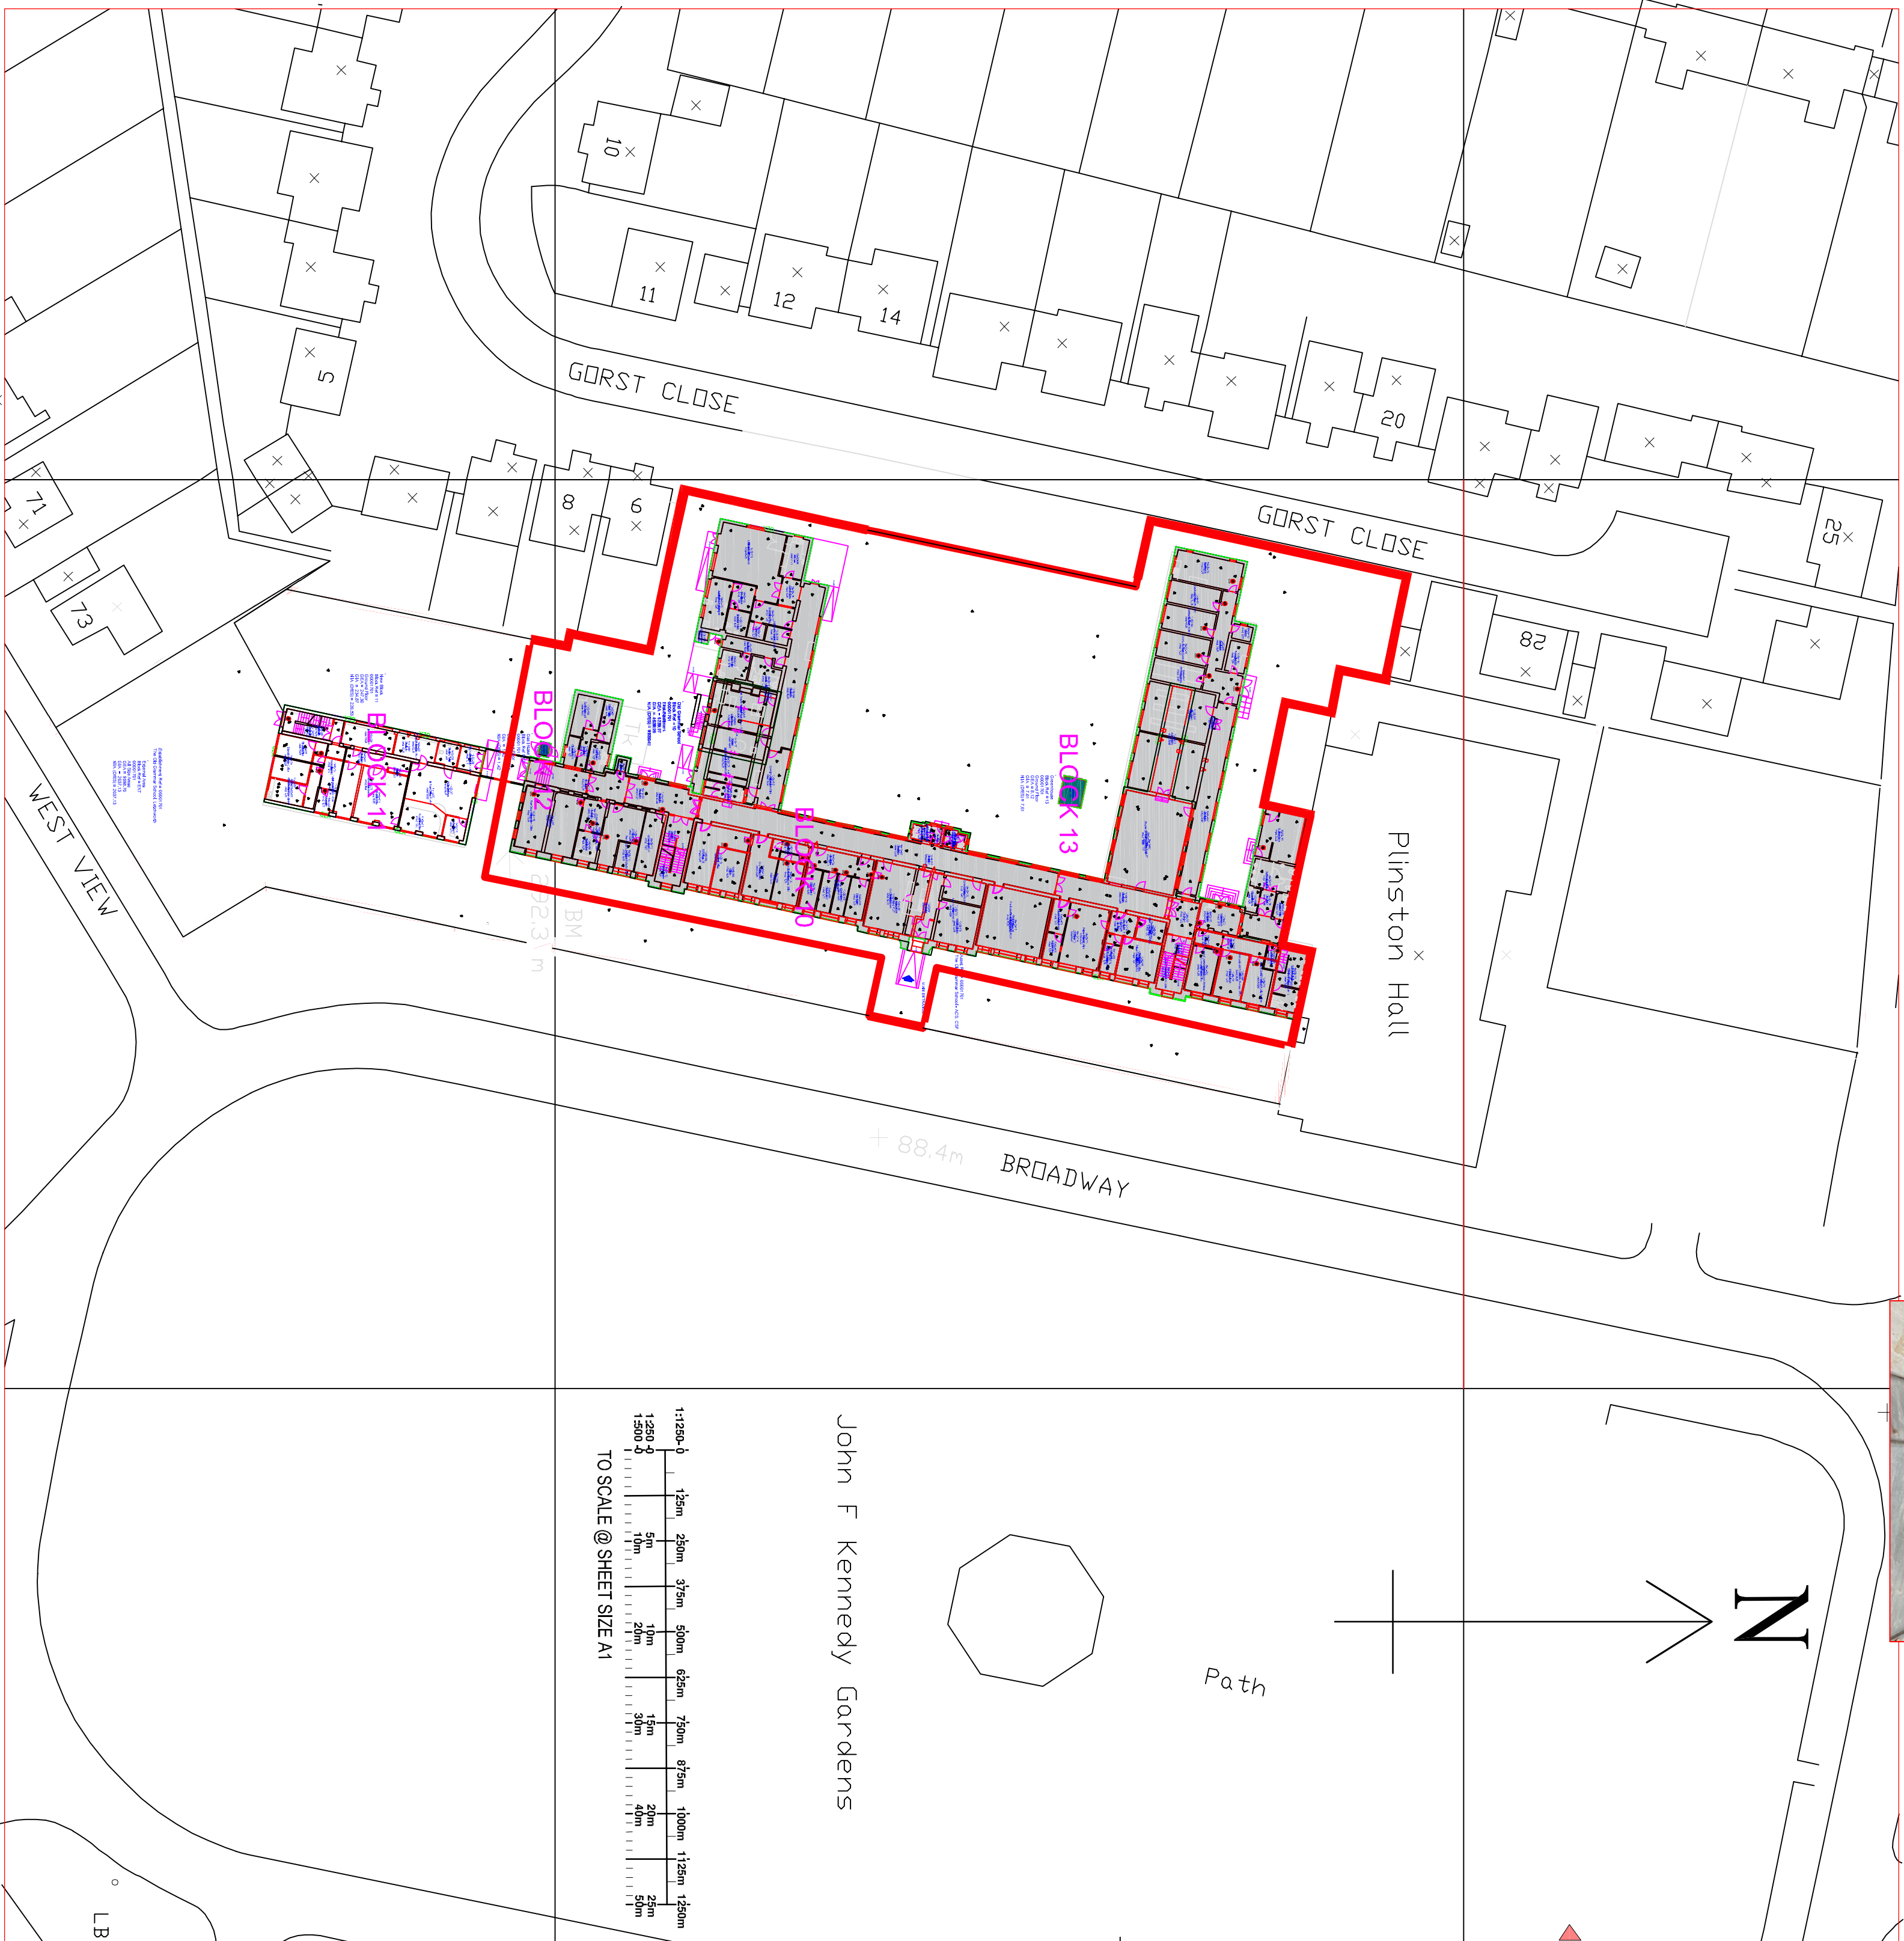

Site plan (1:500 scale)

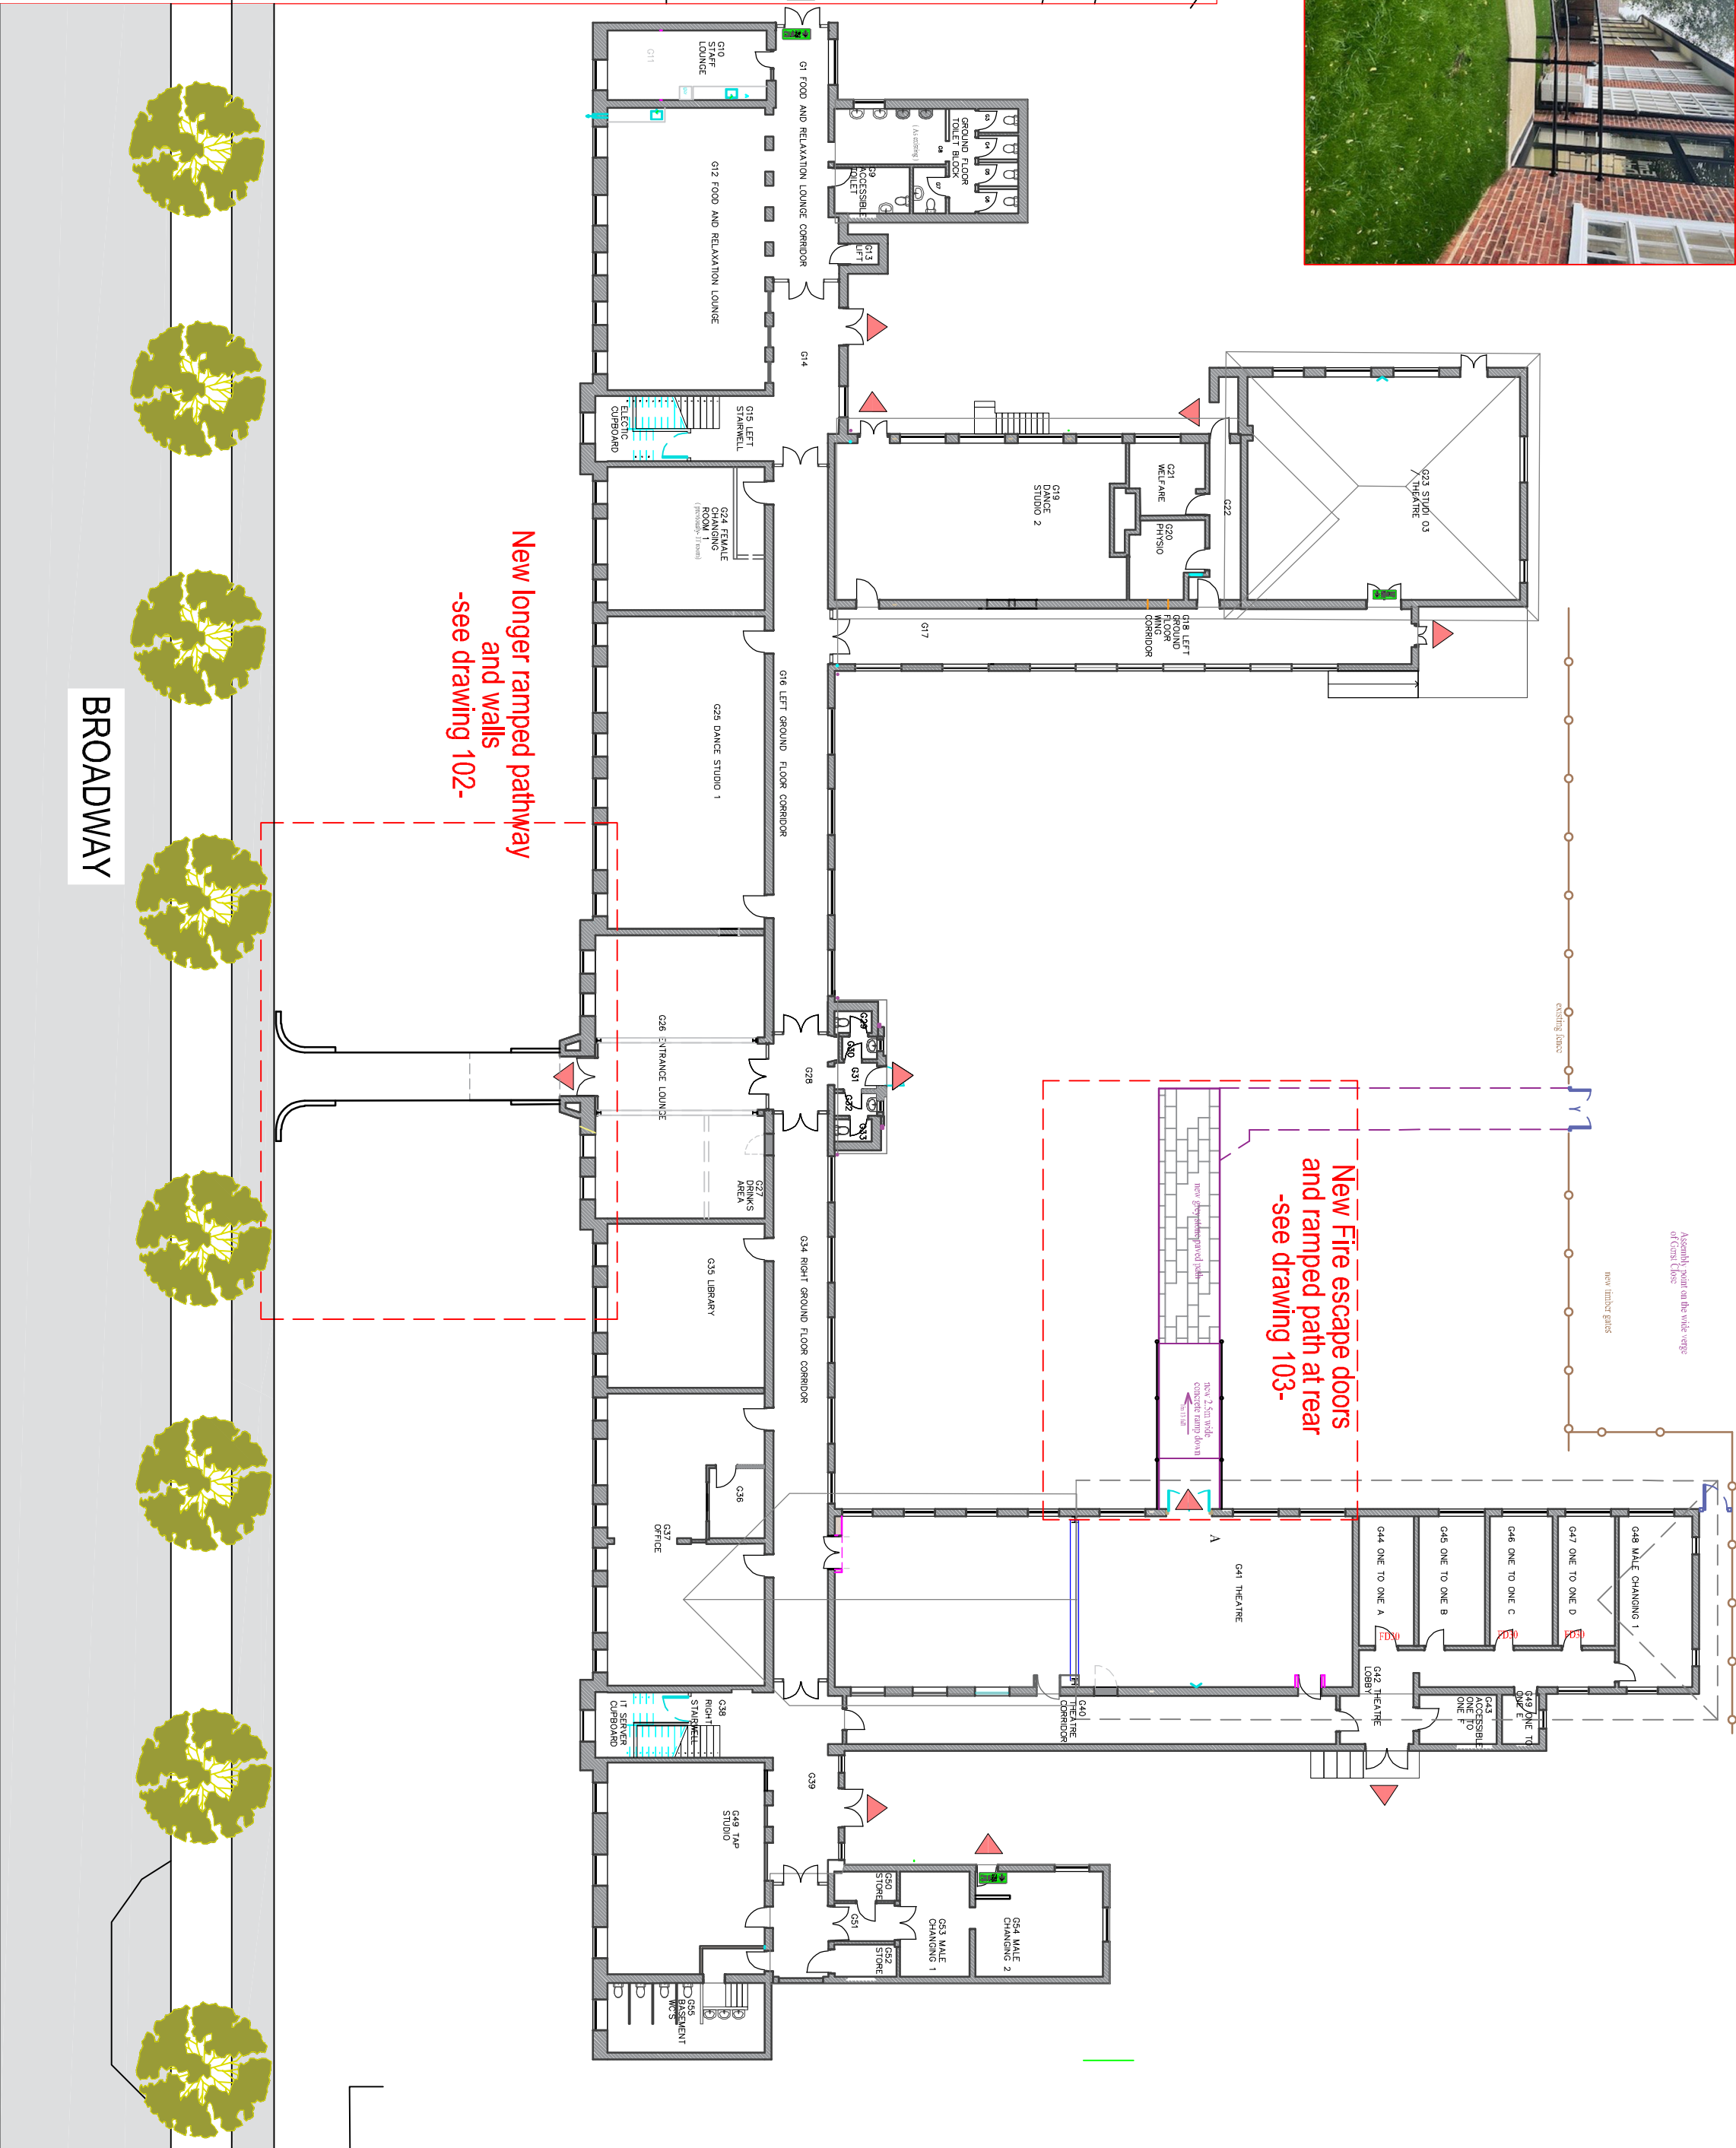

Key plan of works (1:250 scale)



Location plan (1:1250 scale)



As-Built photographs



REVISION	DESCRIPTION	DATE
October 2024	CLIENT/PROJECT	Emil-Dale School of Performing Arts Ltd.
1:500, 1:1250	DRAWING STATUS	As-Built/Respective applications
	DRAWING TITLE	New walls and path to front entrance and New fire exit and path at rear
		65 Sherford Road Clifton Beds. SG17 5BQ Tel. / Fax. 01462 650000
		Ref:6796-1 101A