



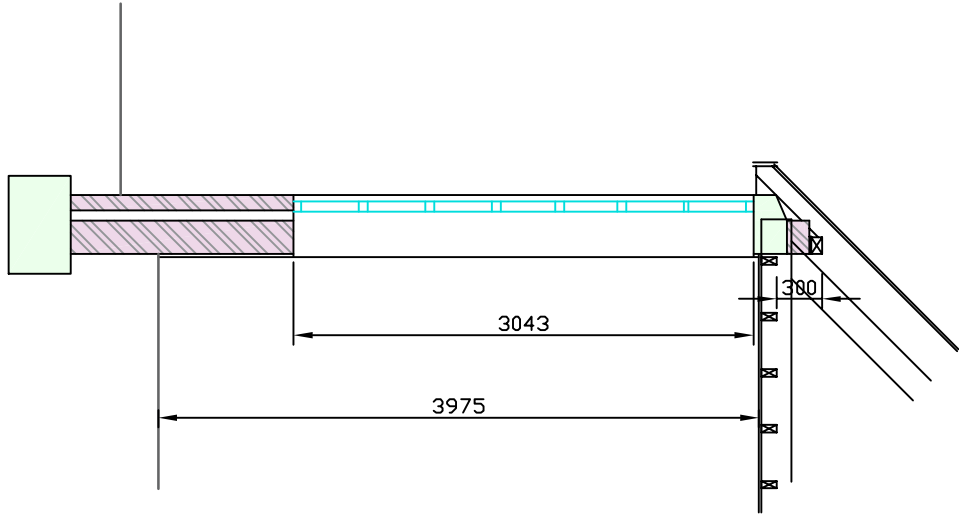


Pre-existing sectional elevation
(1:50 scale)

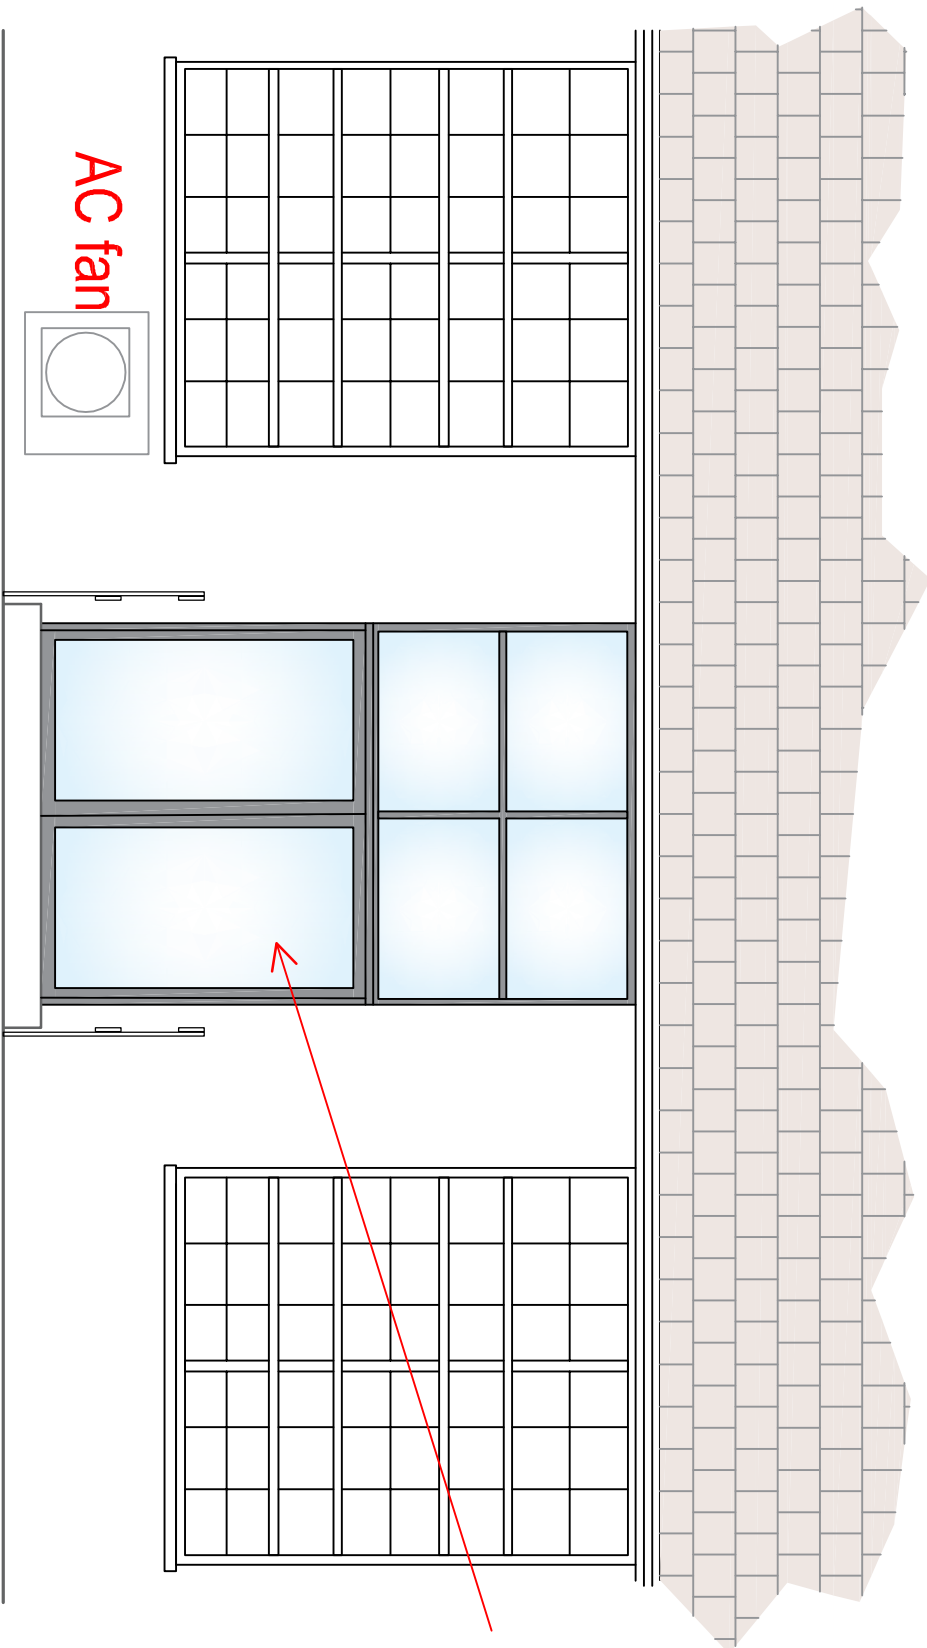


black painted pair of aluminium
fire escape doors with matching
fixed pane fire resistant glass
panel above.

As-Built elevation
(1:50 scale)

black painted handrails
1100mm high each side

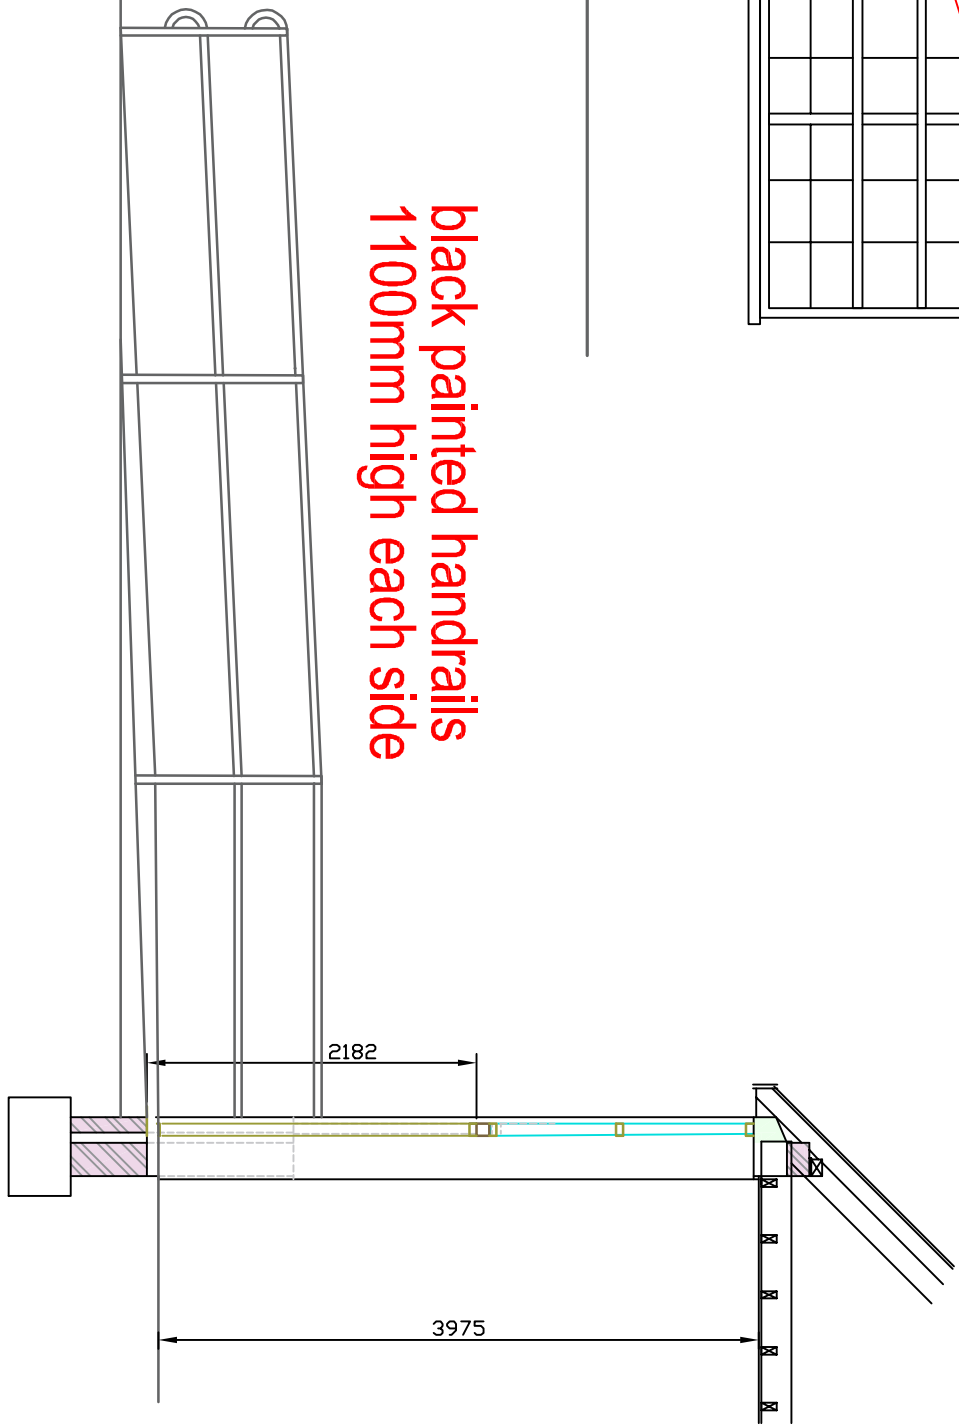


wheelchair accessible level threshold
and 'level' platform in front of doors
at top of ramp

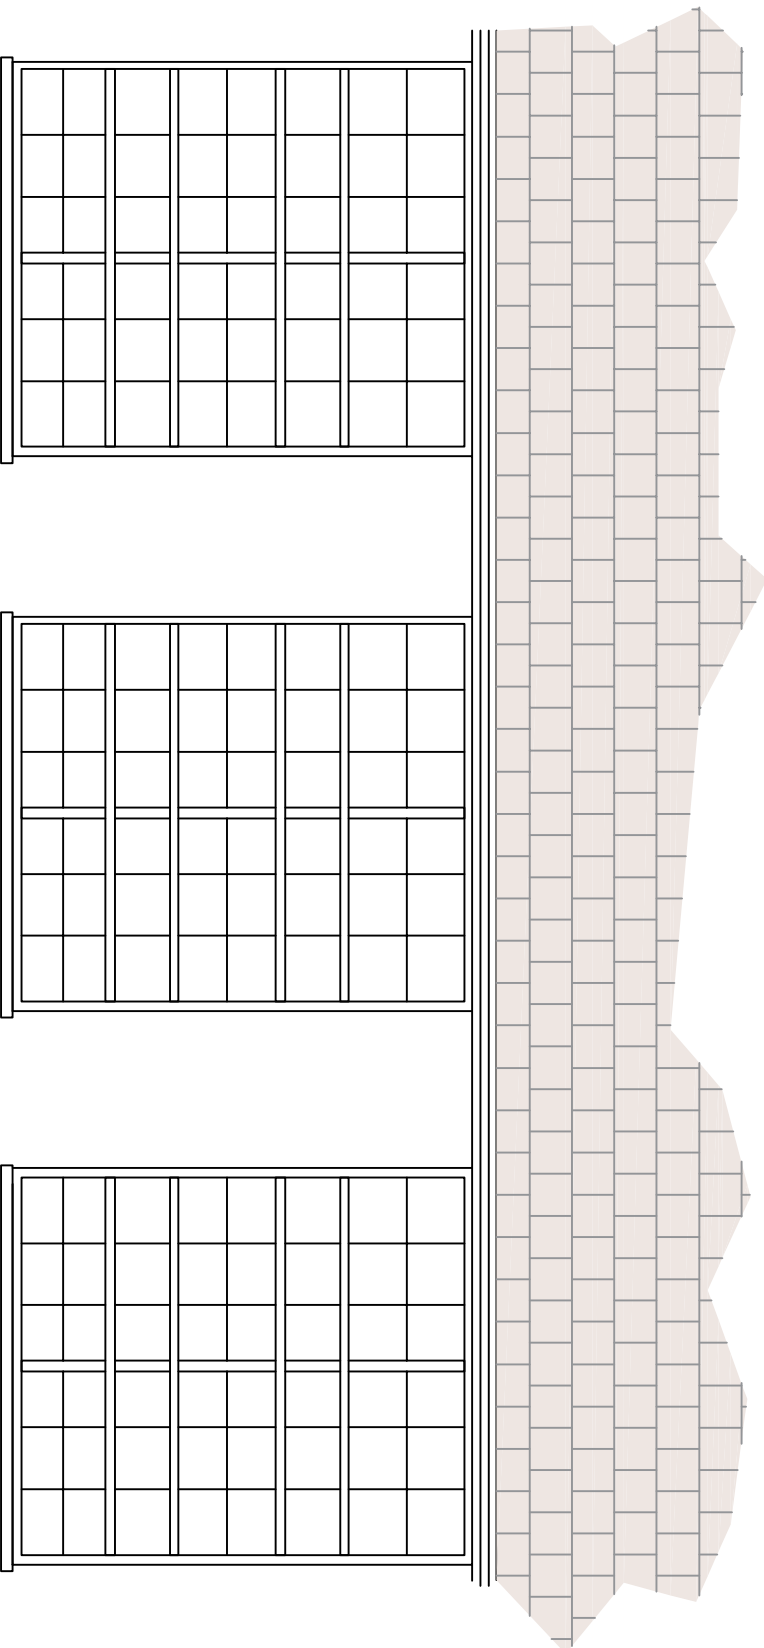


Pre-existing elevation
(1:50 scale)


Pre-existing
window

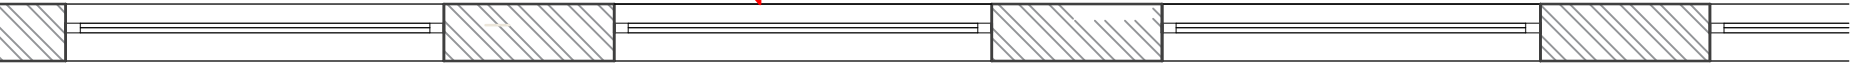

Pre-existing plan
(1:50 scale)

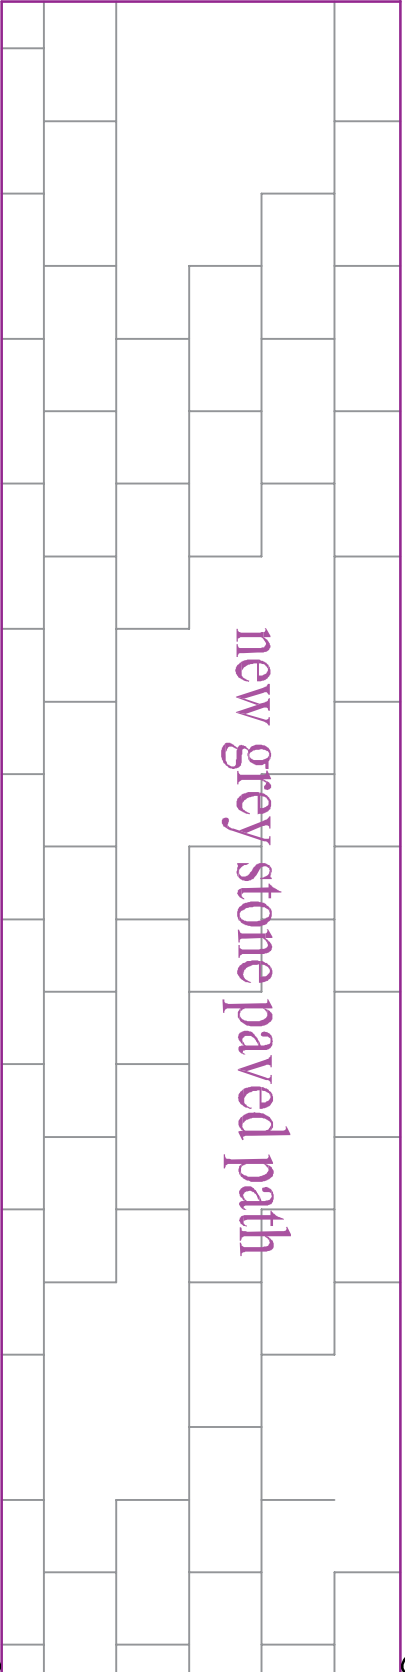

new 2.5m wide
concrete ramp down
1 in 13 fall

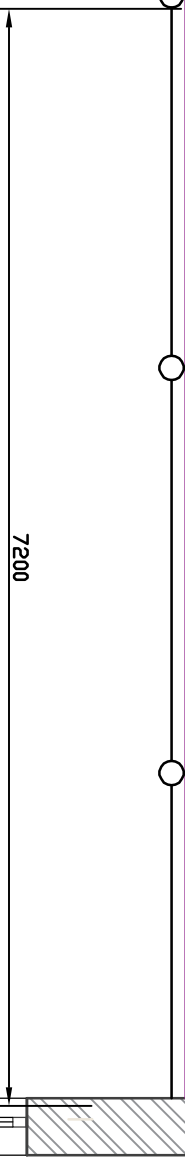

For location see drawing 101

As-Built plan (1:50 scale)

REVISION	DESCRIPTION	DATE	
October 2024	CLIENT/PROJECT	Emil-Date School of Performing Arts Ltd.	
1:100	DRAWING STATUS	Old Grammar School, Letchworth.	
	DRAWING STATUS	Pair of New Fire Exit doors and ramped path at rear	
	DRAWING STATUS	NO UNAUTHORISED PRINTING OR DIGITAL SCANNING ALLOWED - COPYRIGHT 2024	
	DRAWING STATUS	65 Sherford Road, Clifton Beds, SG17 5BQ Tel. / Fax: 01462 650060	
	DRAWING STATUS	Burton & Associates Ltd.	
	DRAWING STATUS	Ref:6796-1	103A