


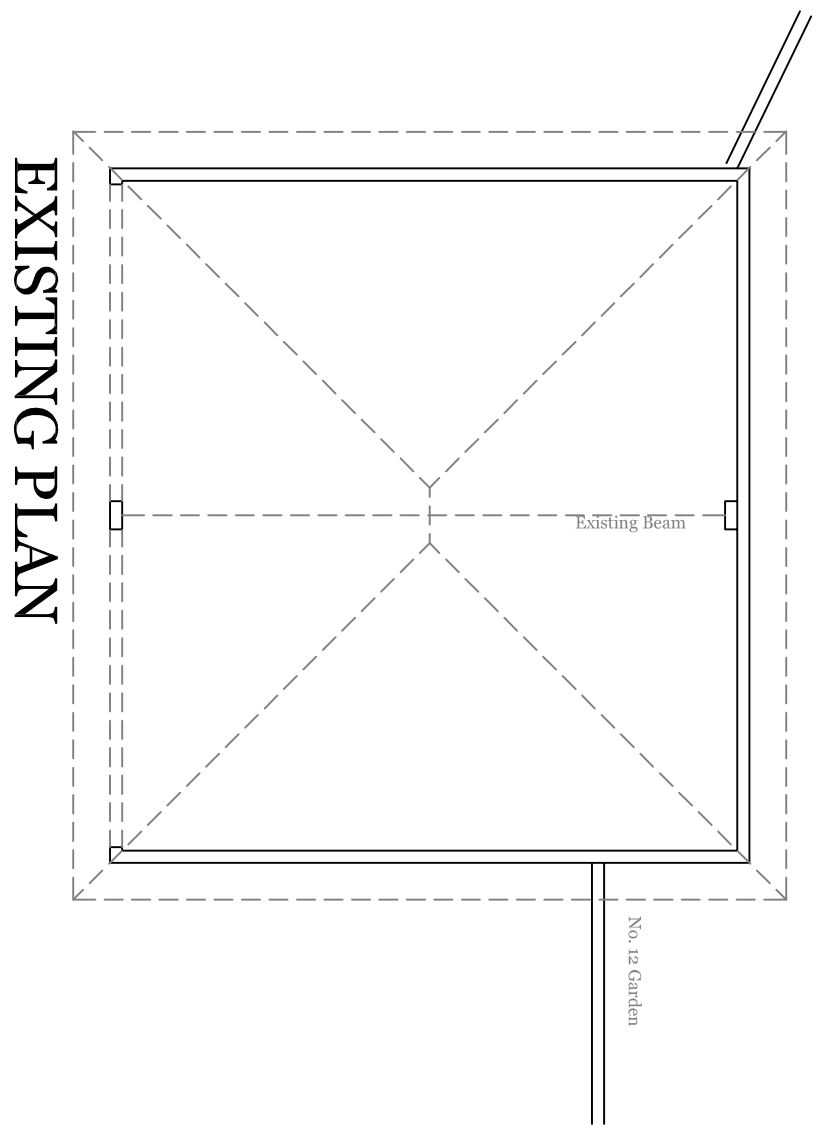


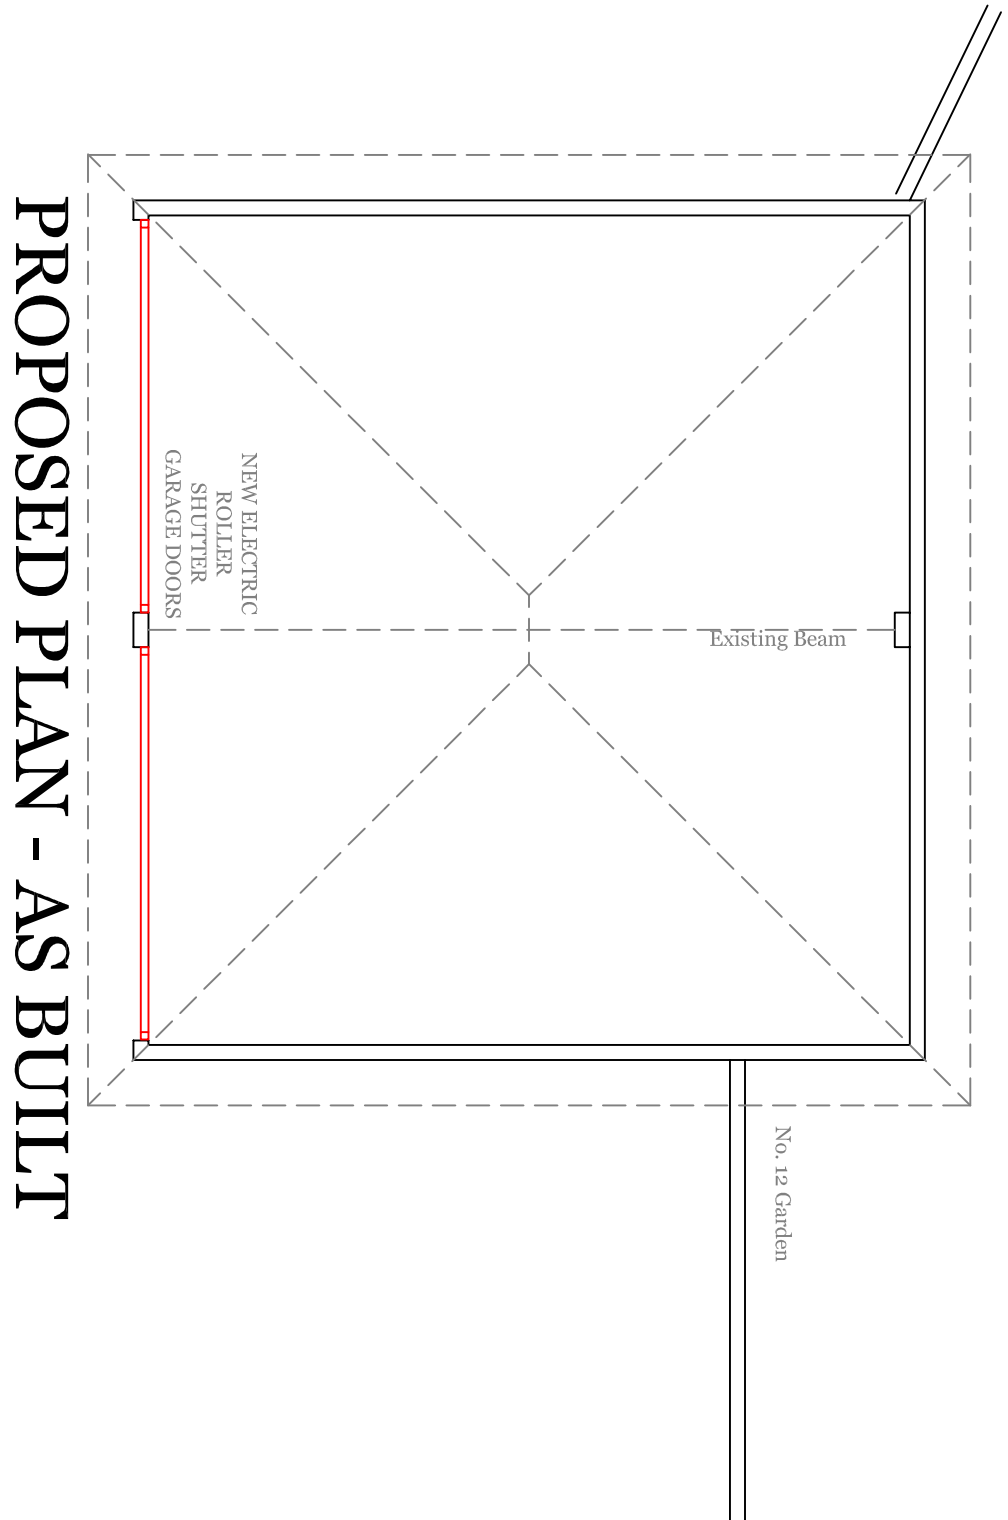


EXISTING PLAN

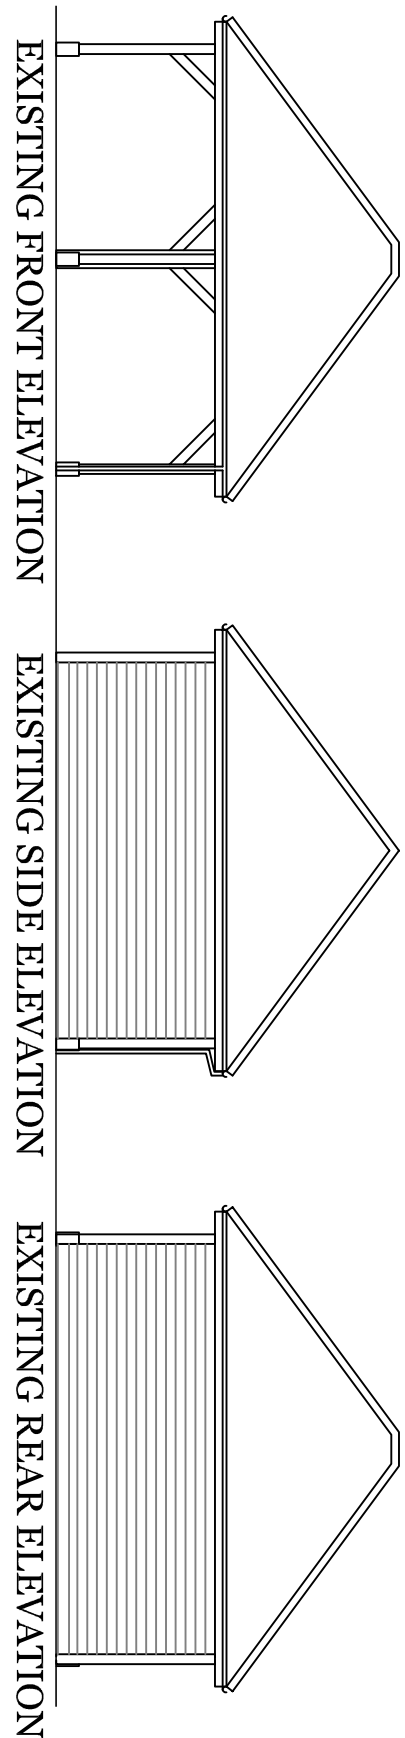


PROPOSED PLAN - AS BUILT

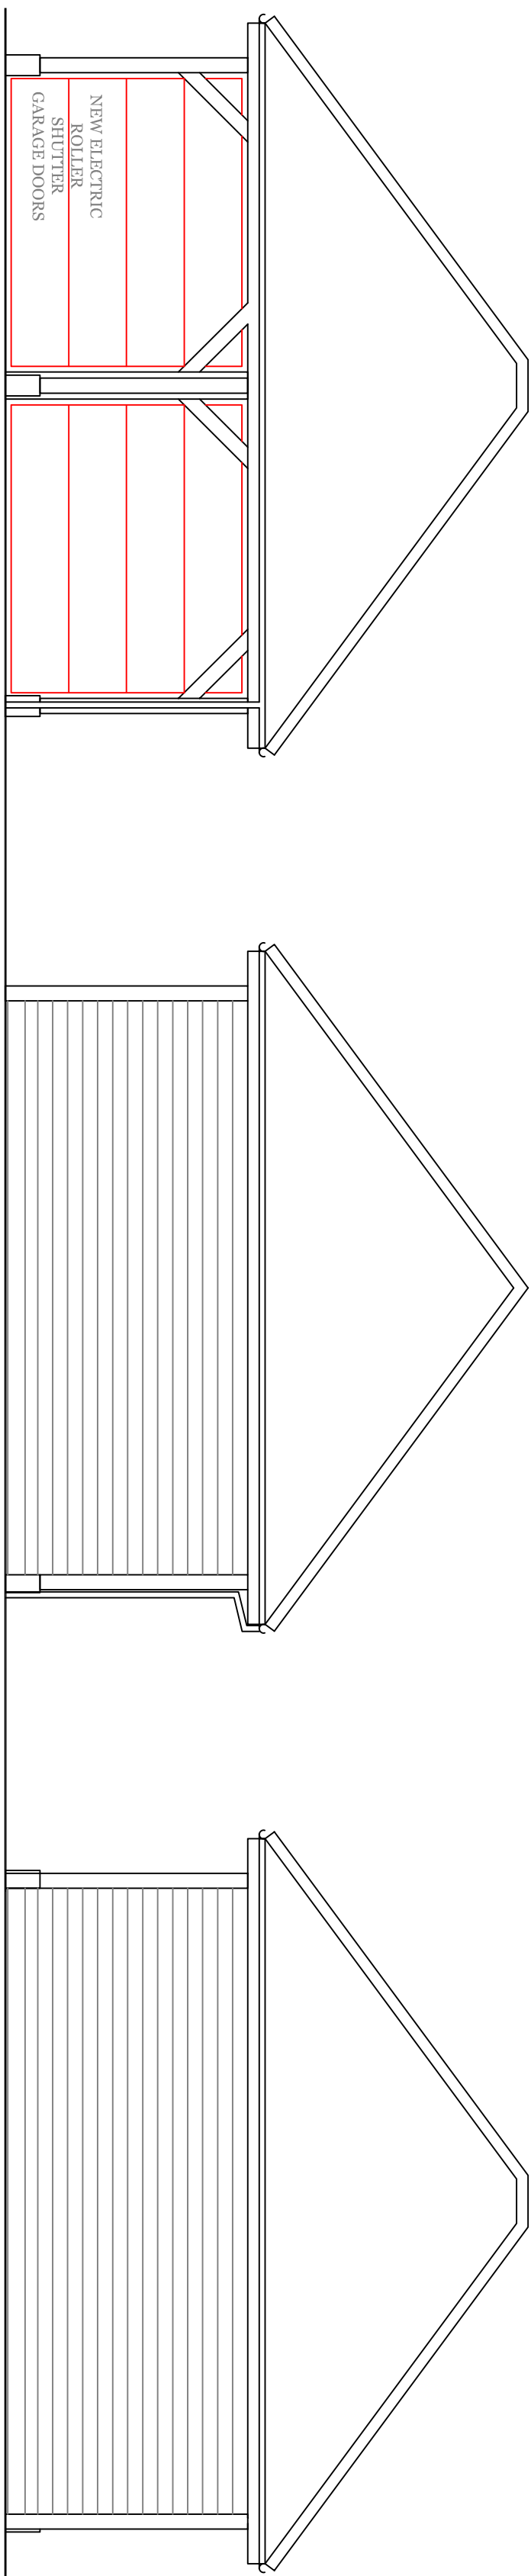

PROPOSED FRONT ELEVATION - AS BUILT
PROPOSED SIDE ELEVATION - AS BUILT
PROPOSED REAR ELEVATION - AS BUILT

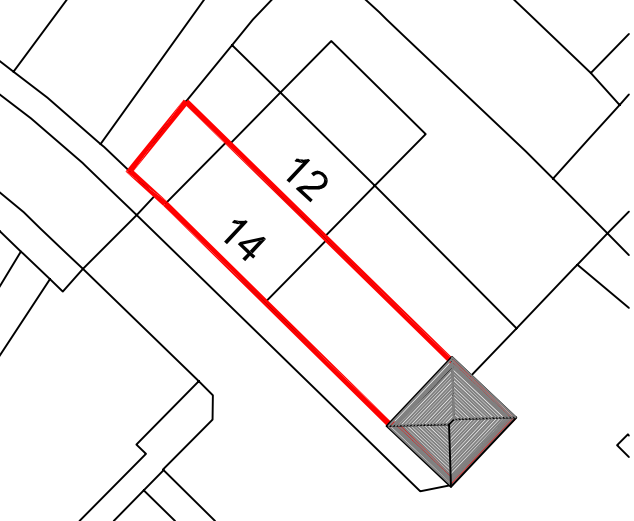

BLOCK PLAN 1:500

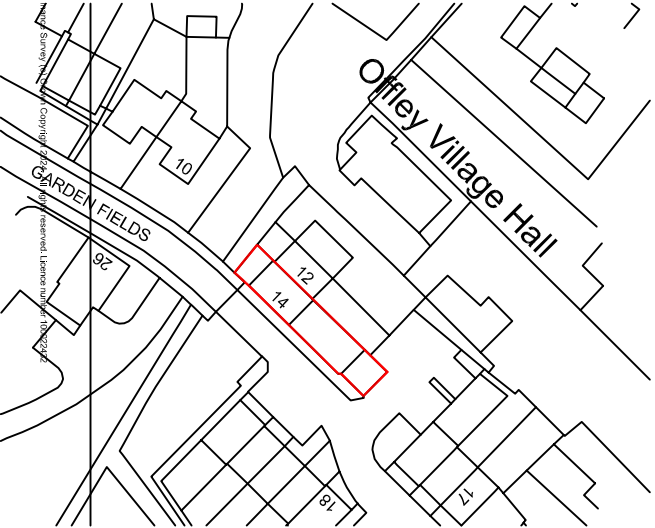

LOCATION PLAN 1:1250




PHOTOS - AS BUILT



Key Plan
Site Boundary

Materials
Walls: Existing Weatherboard Timber Cladding
Roof: Existing Plain Tile
Windows: N/A
Doors: Proposed Dark Grey Electric Roller Shutter Garage Doors
Boundary: N/A

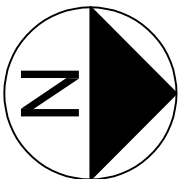

M 1:100
0 1 2 3 4 5 6 7 8 9 10 [m]

M 1:50
0 0.5 1.0 1.5 2.0 2.5 3.0 3.5 4.0 4.5 5.0 [m]

Client: Catherine Noden			
Site Address: 14 Garden Fields, Offley, SG5 3DF			
Drawing Title: Electric Garage Doors to Existing Car Port.			
Scale at A1: 1:100 - 1:50	Date: 01.07.2024	Drawn by: GLH	
Project No.: 2305	Dwg No.: 01	Rev:	