




CAN BE SCALED FOR PLANNING PURPOSES ONLY
All dimensions to be verified on site

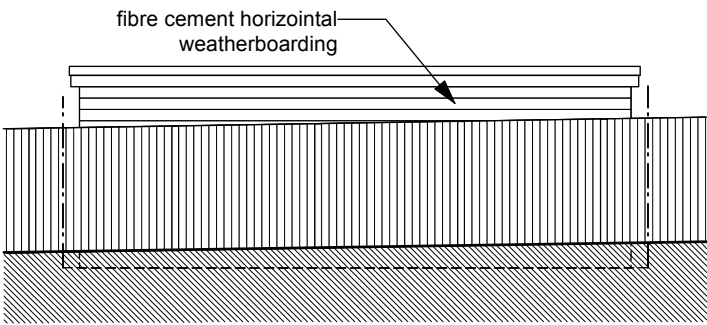


Proposed Garden South Elevation

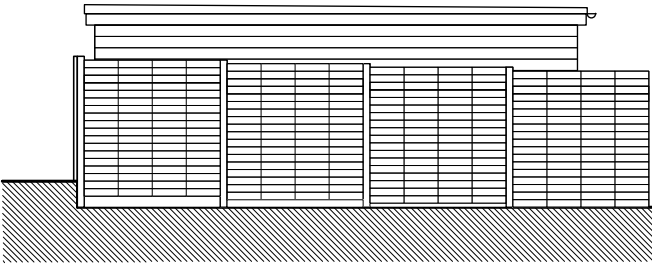


Proposed Garden East Elevation

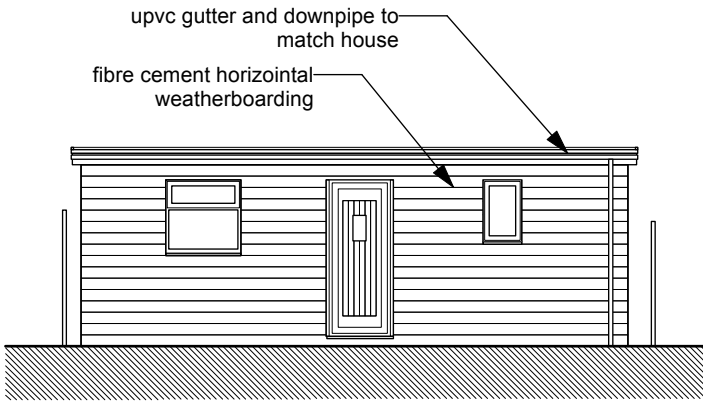


Proposed Garden North Elevation

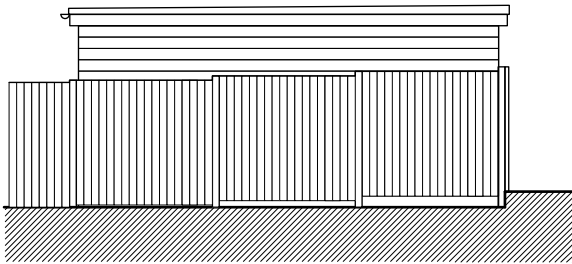


Proposed Garden West Elevation

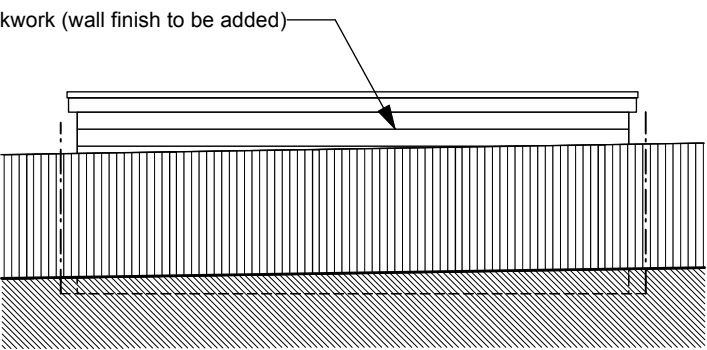


As-Built Garden South Elevation

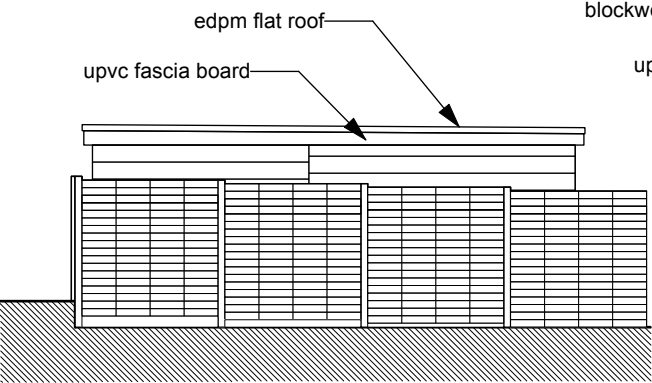


As-Built Garden East Elevation

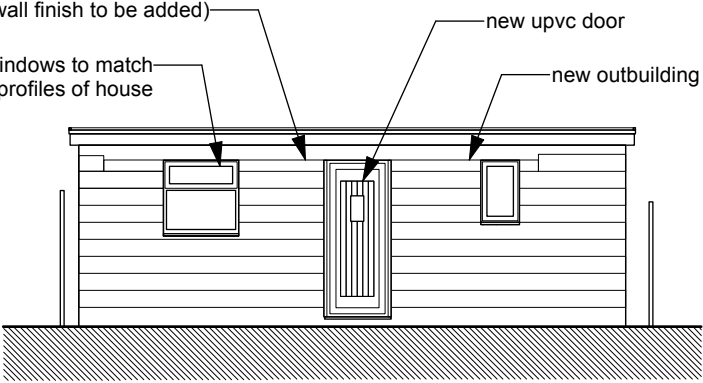


As-Built Garden North Elevation

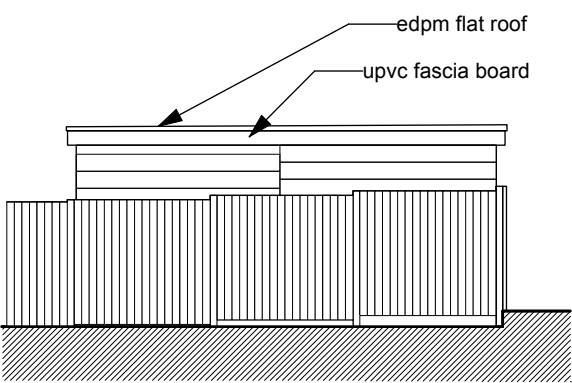


As-Built Garden West Elevation

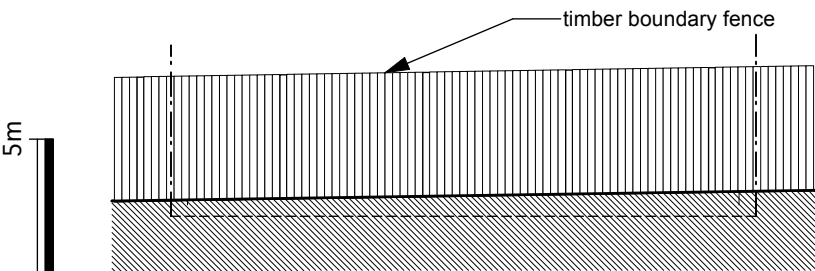


Pre-Existing Garden South Elevation

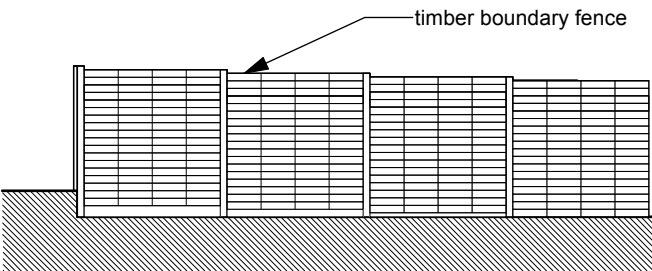


Pre-Existing Garden East Elevation

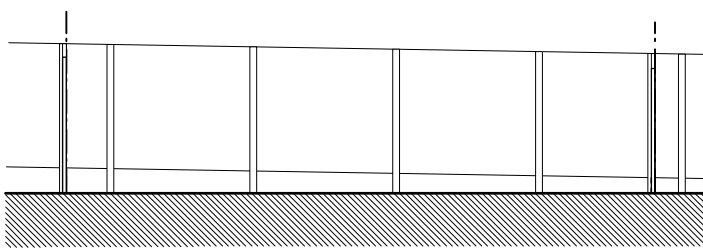

Pre-Existing Garden North Elevation

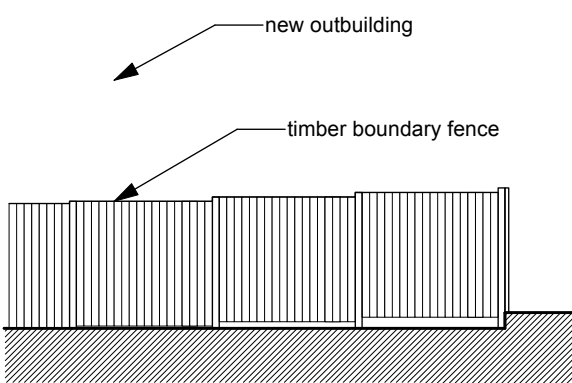

Pre-Existing Garden West Elevation

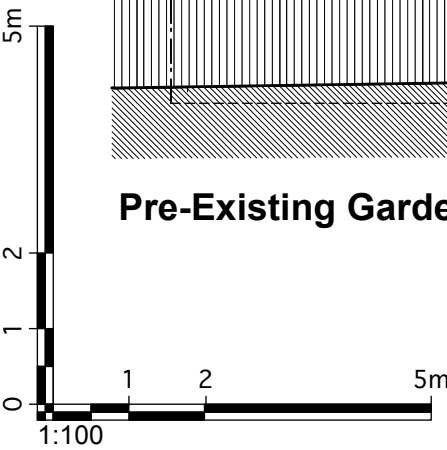

FOR PLANNING APPLICATION PURPOSES ONLY
This drawing has been produced for the applicant for the project/site named below and is submitted as part of a planning/permitted development application relating to this site name only and is not intended for use by any other person or organisation or for any other purpose.

revision	description	date	project	104 Woodland Way, Baldock	title	Pre.Ex., As-Built & Prop. Elevations
			job no.	382	dwg. no./rev/status	PL004
			scale	1:100 @ A3	date	June 2025
			Nigel Cox Architects			
			© Nigel Cox Architects nigelcoxarchitects@gmail.com			