
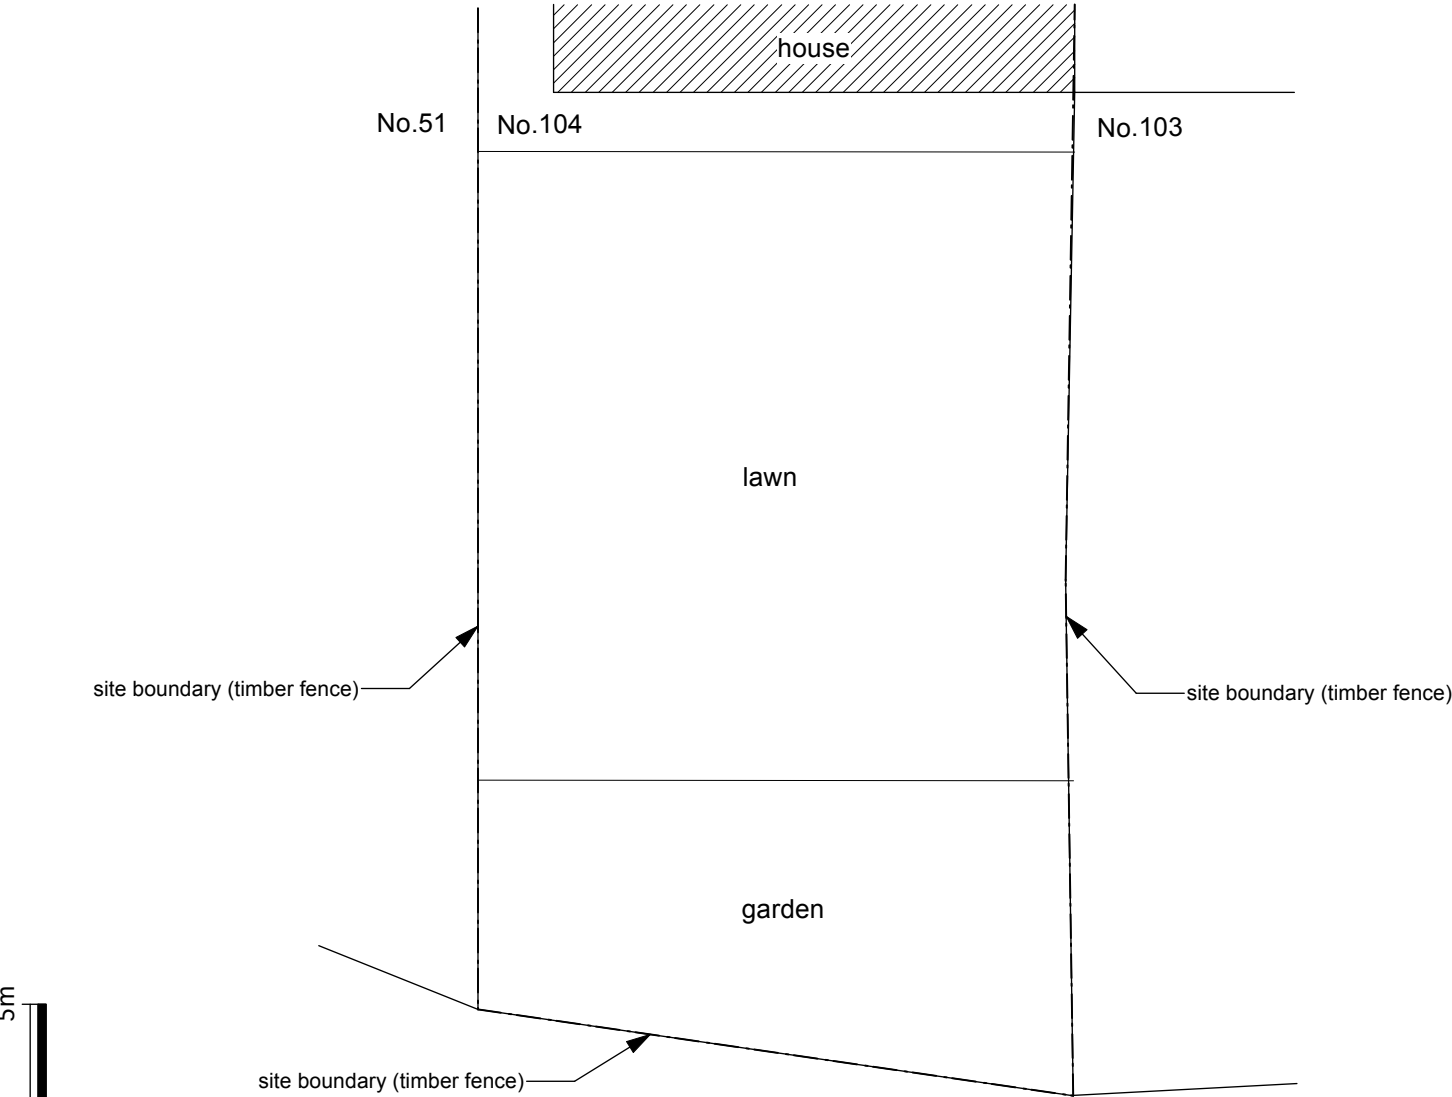




CAN BE SCALED FOR PLANNING PURPOSES ONLY

All dimensions to be verified on site

All survey information provided is visible or accessible, further investigation may be required to ascertain hidden or inaccessible information. Information on adjoining properties is from O.S. plan and observation only.

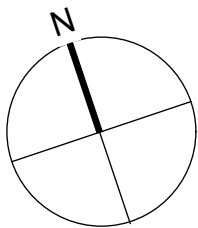

Pre-Existing Ground Floor Plan (1:100)

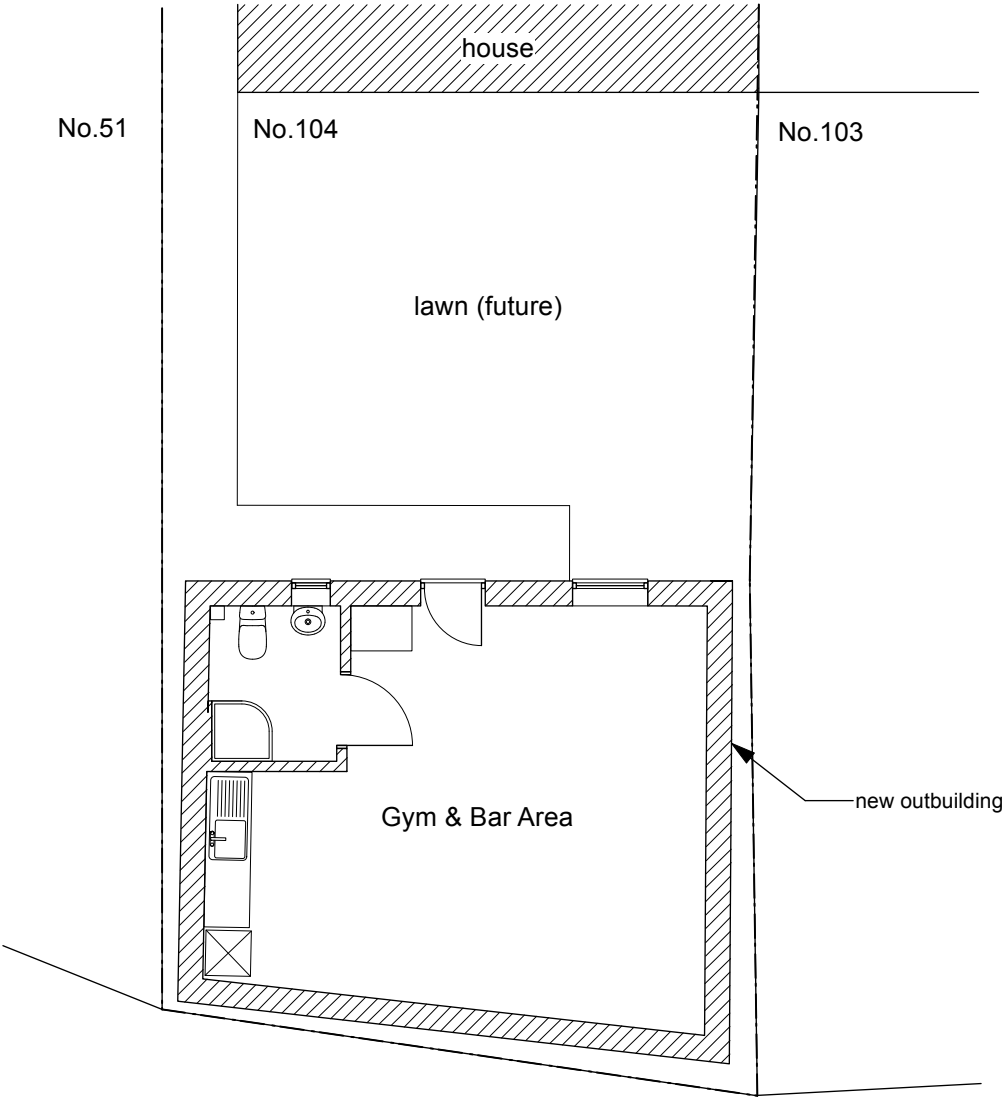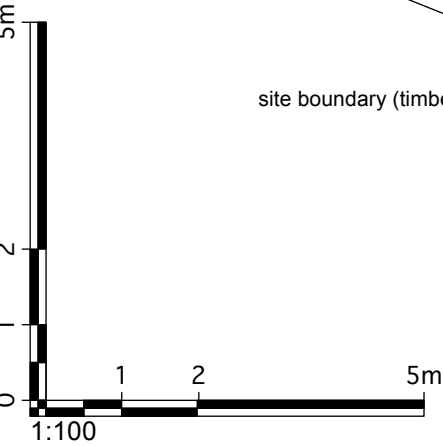

As-Built Ground Floor Plan (1:100)

FOR PLANNING APPLICATION PURPOSES ONLY

This drawing has been produced for the applicant for the project/site named below and is submitted as part of a planning/permitted development application relating to this site name only and is not intended for use by any other person or organisation or for any other purpose.

revision	description	date
----------	-------------	------

project	104 Woodland Way, Baldock	title	Pre.Ex. & As-Built Gnd. Fr. Plans
job no.	382	dwg. no./rev/status	PL003
scale	1:100 @ A3	date	June 2025