
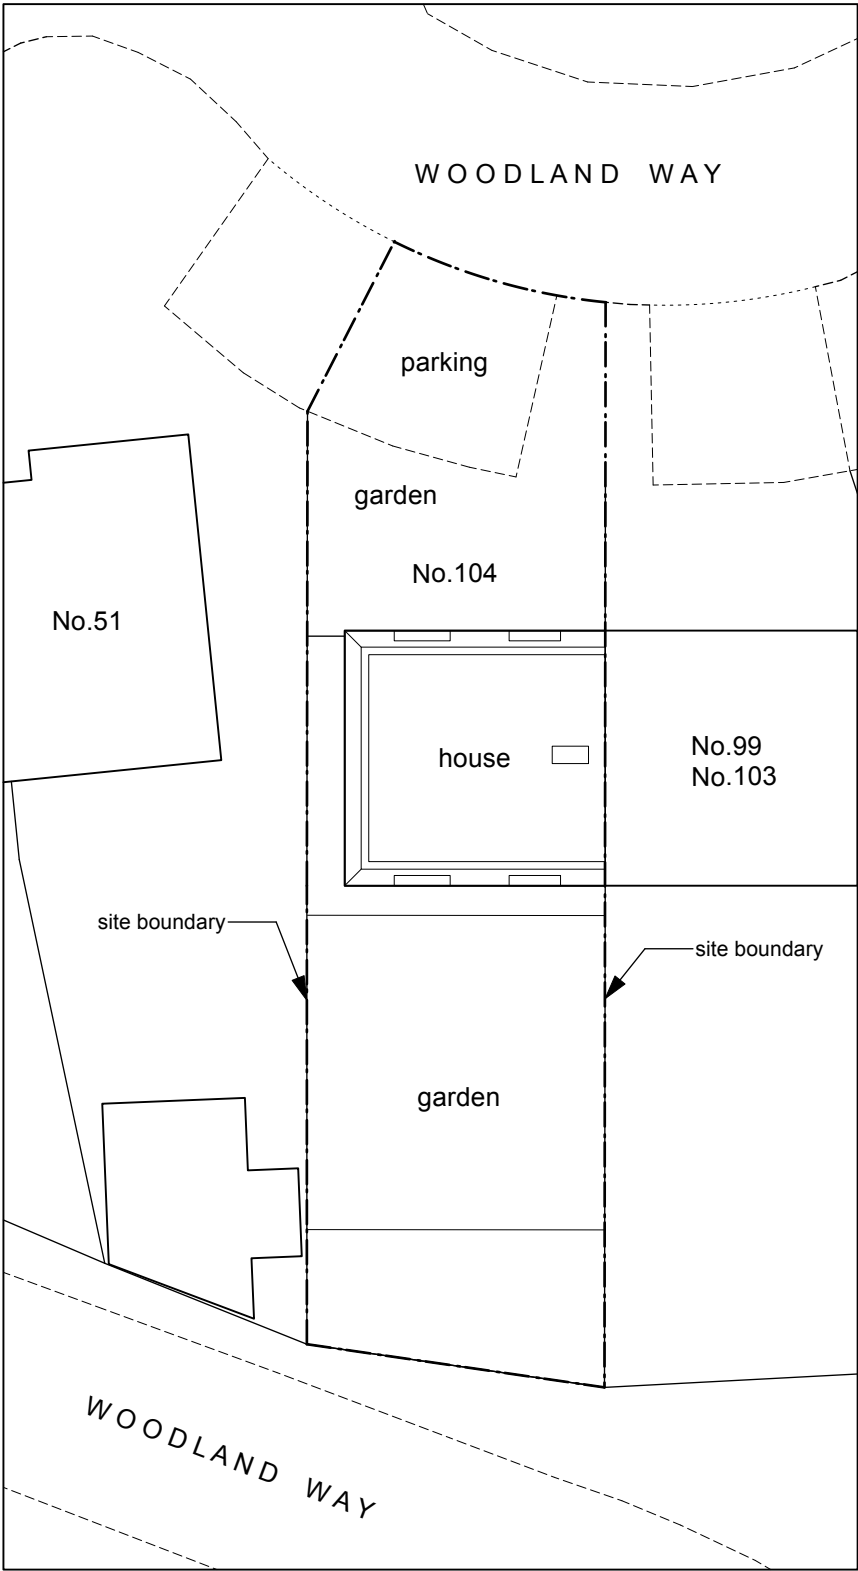



CAN BE SCALED FOR PLANNING PURPOSES ONLY

All dimensions to be verified on site


All survey information provided is visible or accessible, further investigation may be required to ascertain hidden or inaccessible information. Information on adjoining properties is from O.S. plan and observation only.

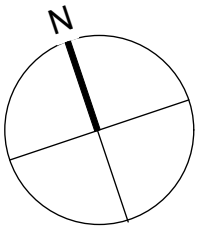

Site Plan (pre-existing) (1:200)

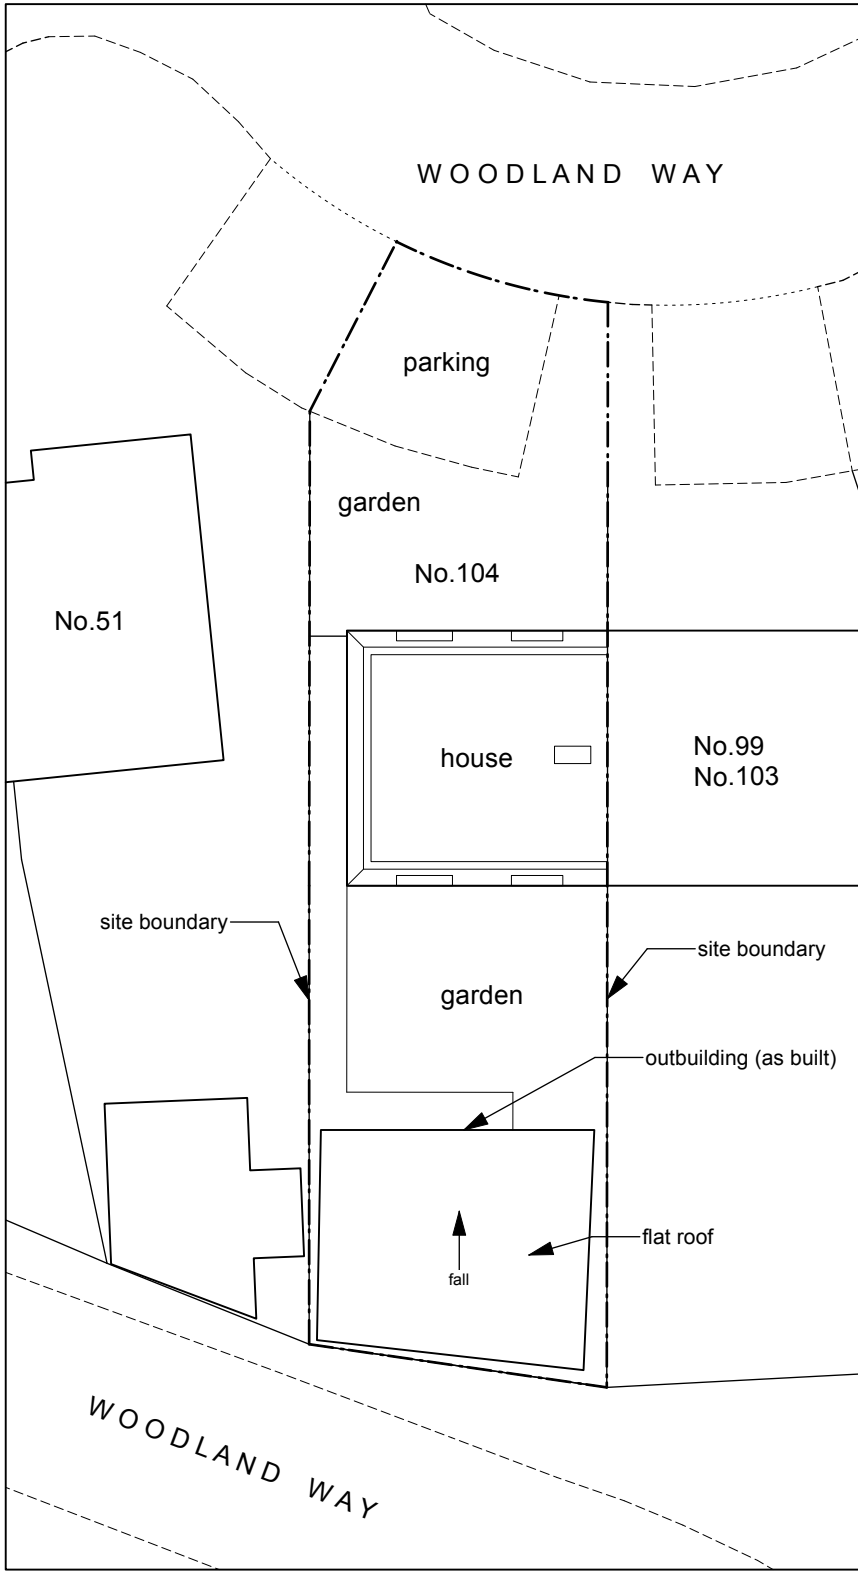

As-Built Site and Roof Plan (1:200)

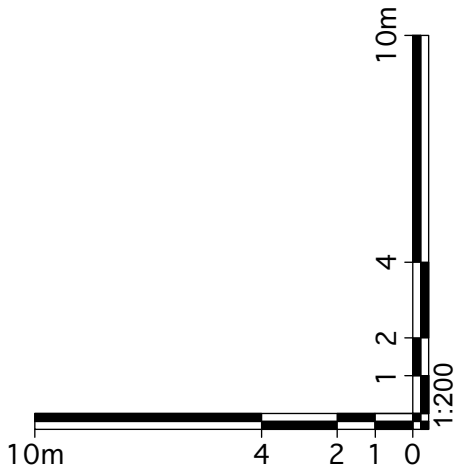

FOR PLANNING APPLICATION PURPOSES ONLY

This drawing has been produced for the applicant for the project/site named below and is submitted as part of a planning/permitted development application relating to this site name only and shall not be be copied, reproduced, retained or disclosed to any unauthorised person, wholly or in part without the written consent of NCA. This drawing is the property of and copyright is reserved by NCA.

revision	description	date
----------	-------------	------

project	104 Woodland Way, Baldock	title	Pre.Ex. & As-Built Roof & Site Plans
job no.	382	dwg. no./rev/status	PL002
scale	1:200 @ A3	date	June 2025