



CAN BE SCALED FOR PLANNING PURPOSES ONLY
All dimensions to be verified on site


All survey information provided is visible or accessible, further investigation may be required to ascertain hidden or inaccessible information. Information on adjoining properties is from O.S. plan and observation only.

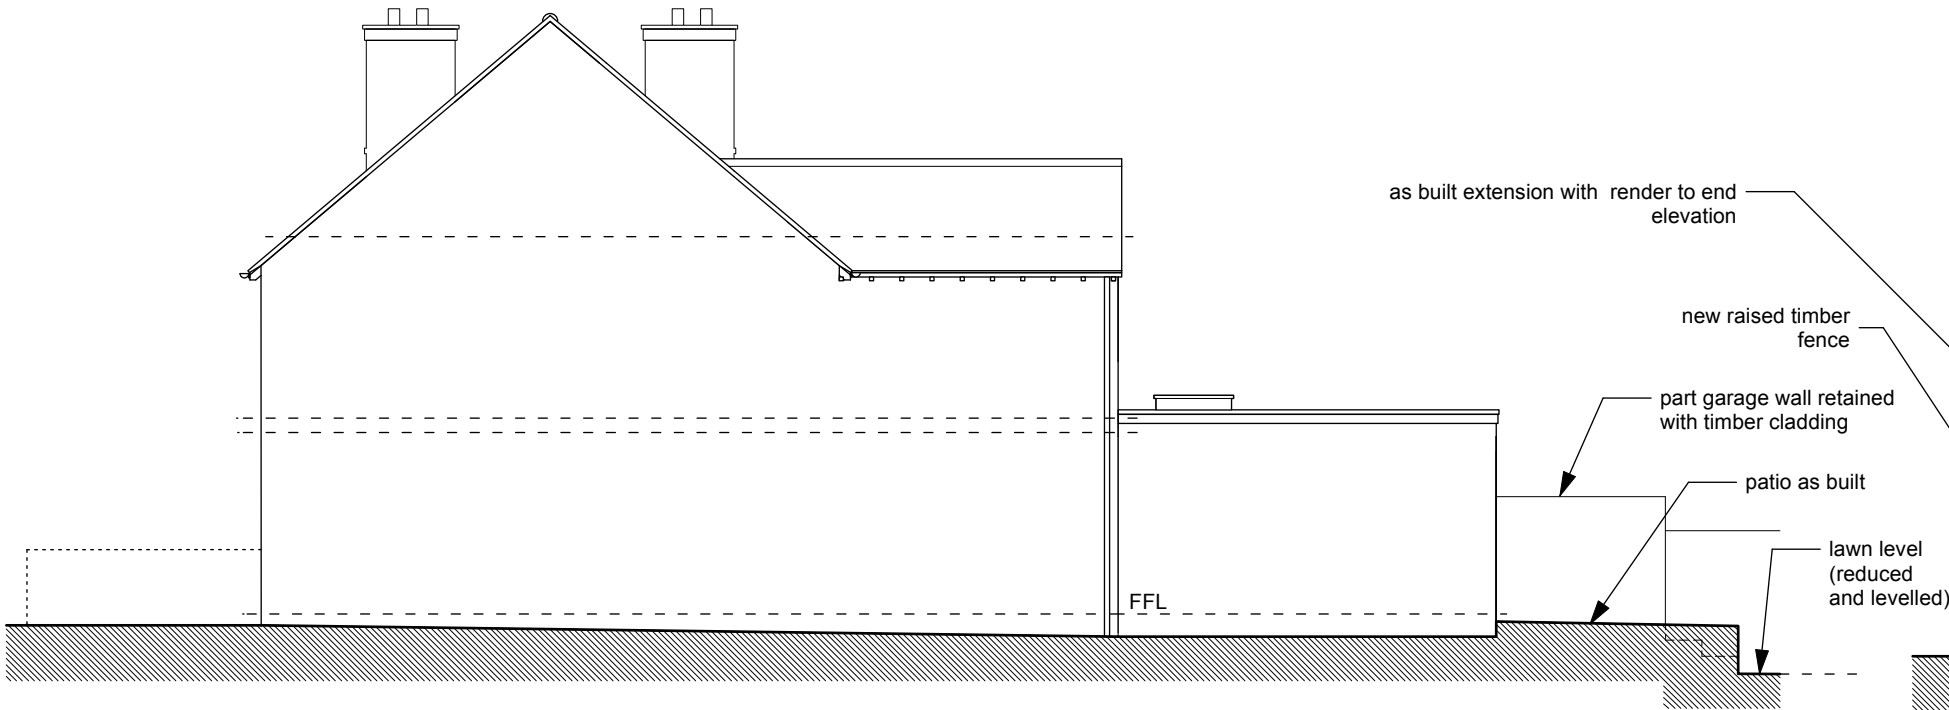


As Built Amended Side (East) Elevation (1:100)

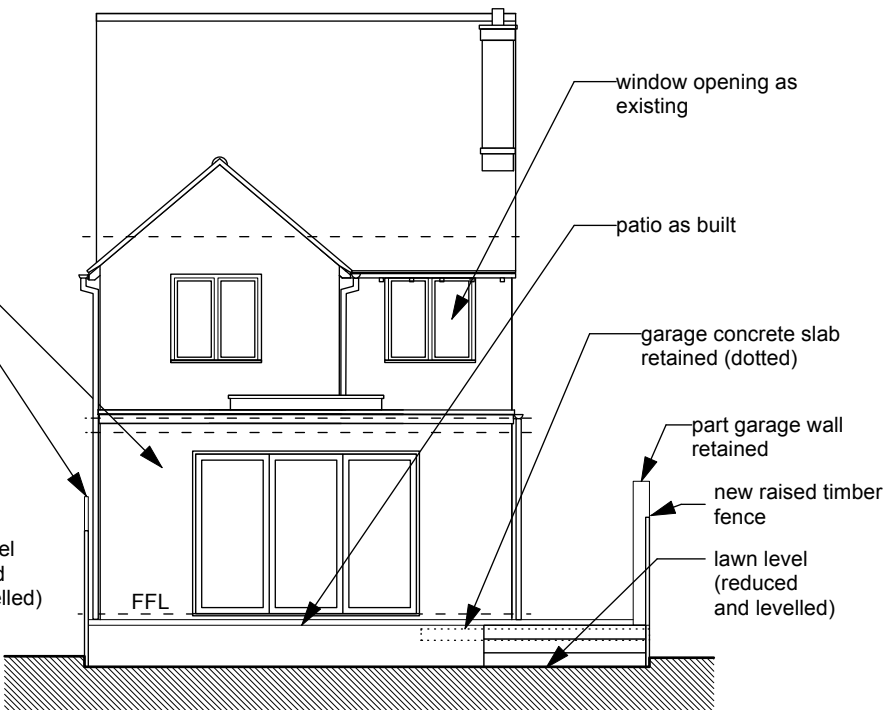

As Built Amended Rear Elevation (1:100)

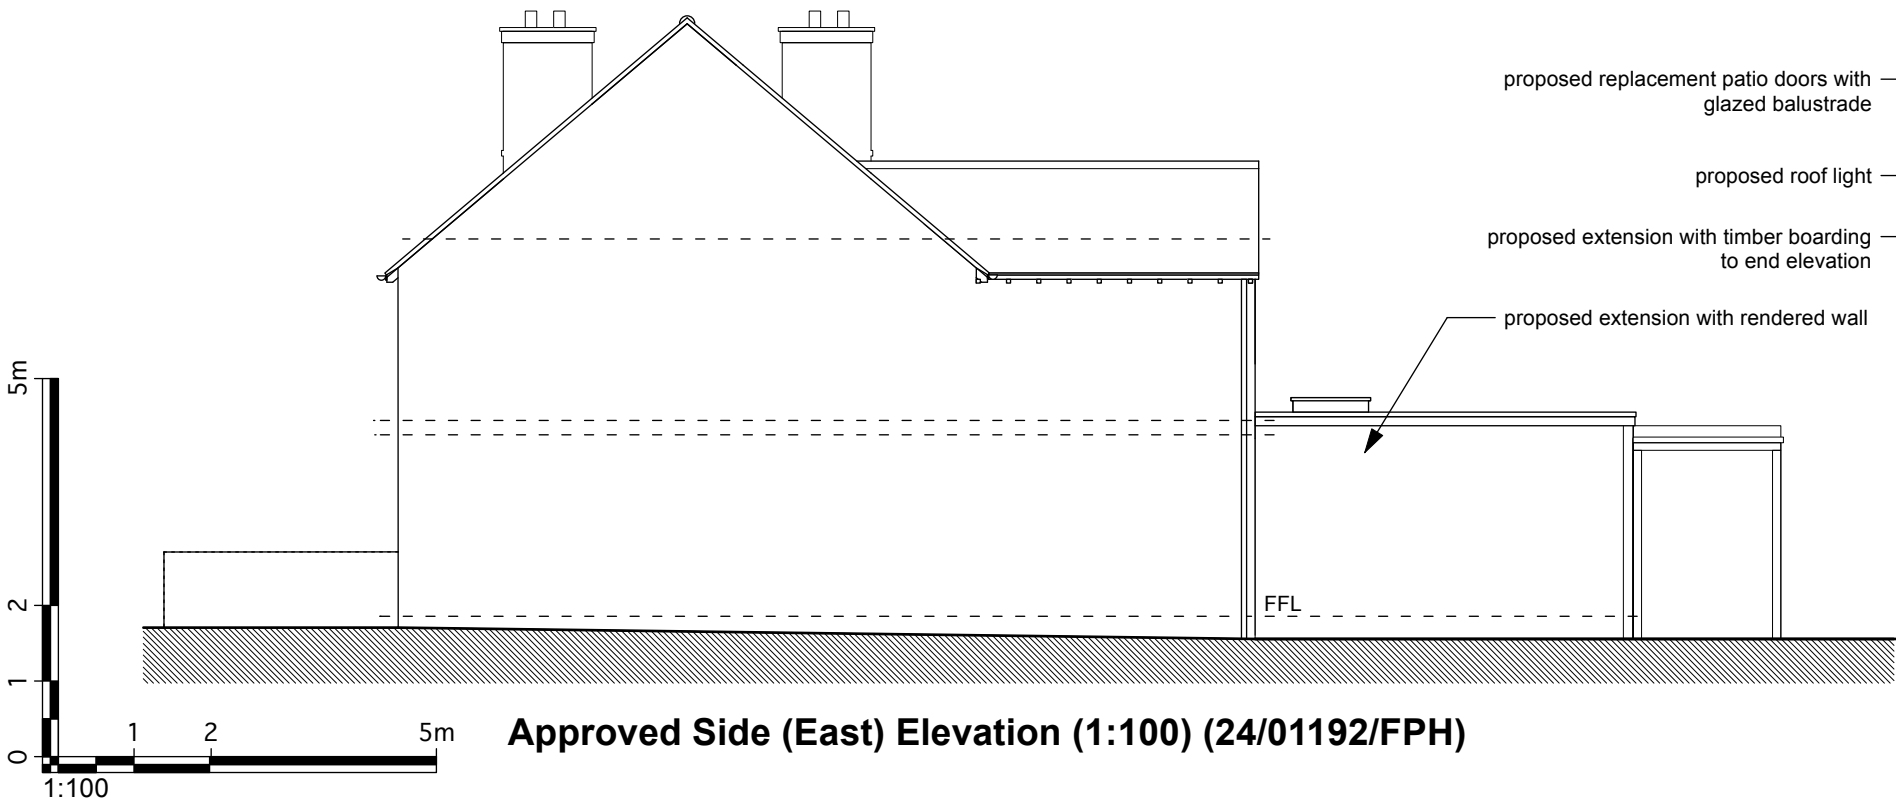

Approved Side (East) Elevation (1:100) (24/01192/FPH)

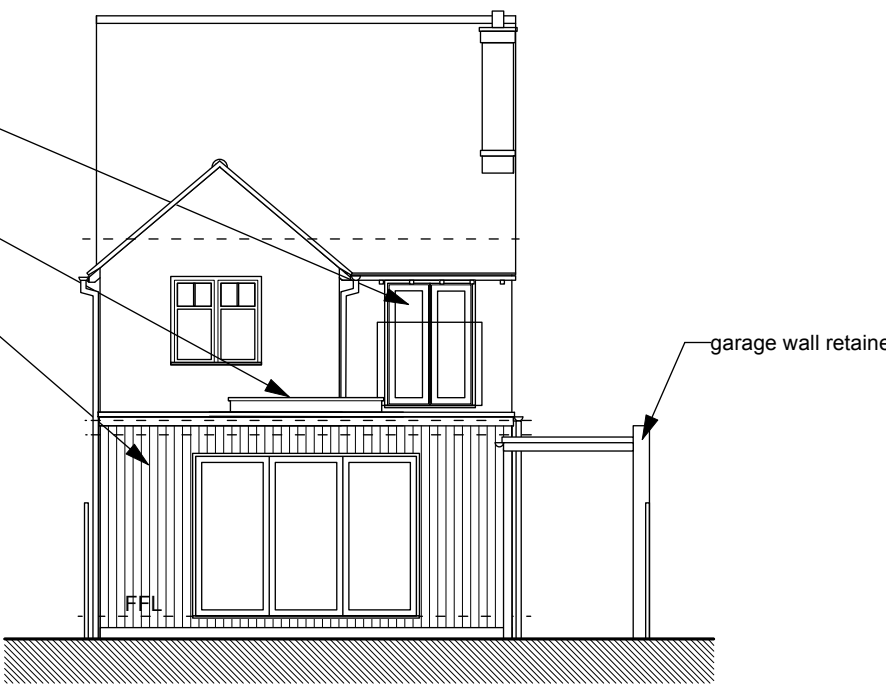

Approved Rear Elevation (1:100)

FOR PLANNING APPLICATION PURPOSES ONLY

This drawing has been produced for the applicant for the project/site named below and is submitted as part of a planning/permited development application relating to this site name only and is not intended for use by any other person or organisation or for any other purpose.

revision	description	date	project	title
			4 Alexandra Road, Hitchin	Approved & Amended Elevations 1
			job no. 368	dwg. no./rev/status PL017
			scale 1:100 @ A3	date May 2025
Nigel Cox Architects				
© Nigel Cox Architects 13 Mornington Welwyn Herts AL6 0AJ 07849 886755 nigelcoxarchitects@gmail.com				