

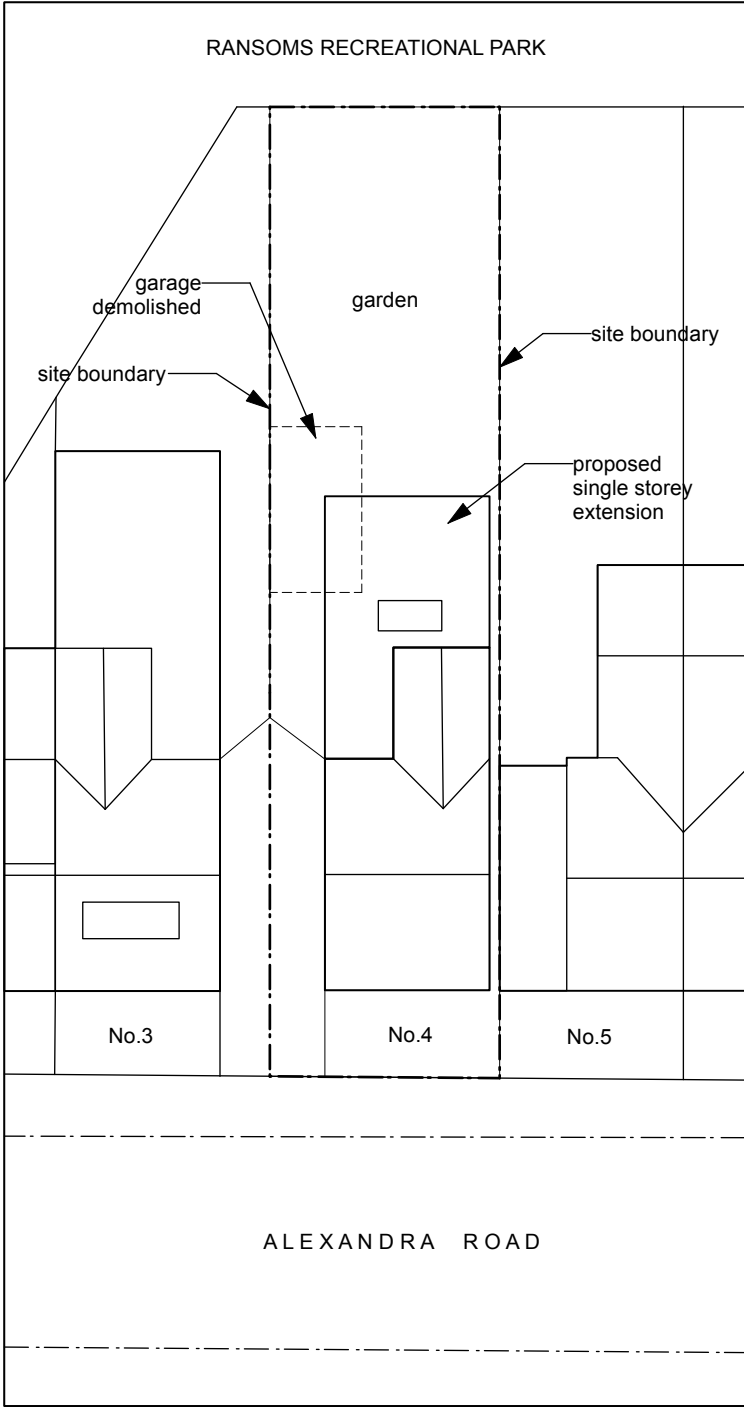


CAN BE SCALED FOR PLANNING PURPOSES ONLY
All dimensions to be verified on site


All survey information provided is visible or accessible, further investigation may be required to ascertain hidden or inaccessible information. Information on adjoining properties is from O.S. plan and observation only.

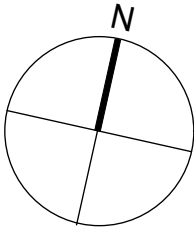

Approved Site Plan (1:250) (24/01192/FPH)

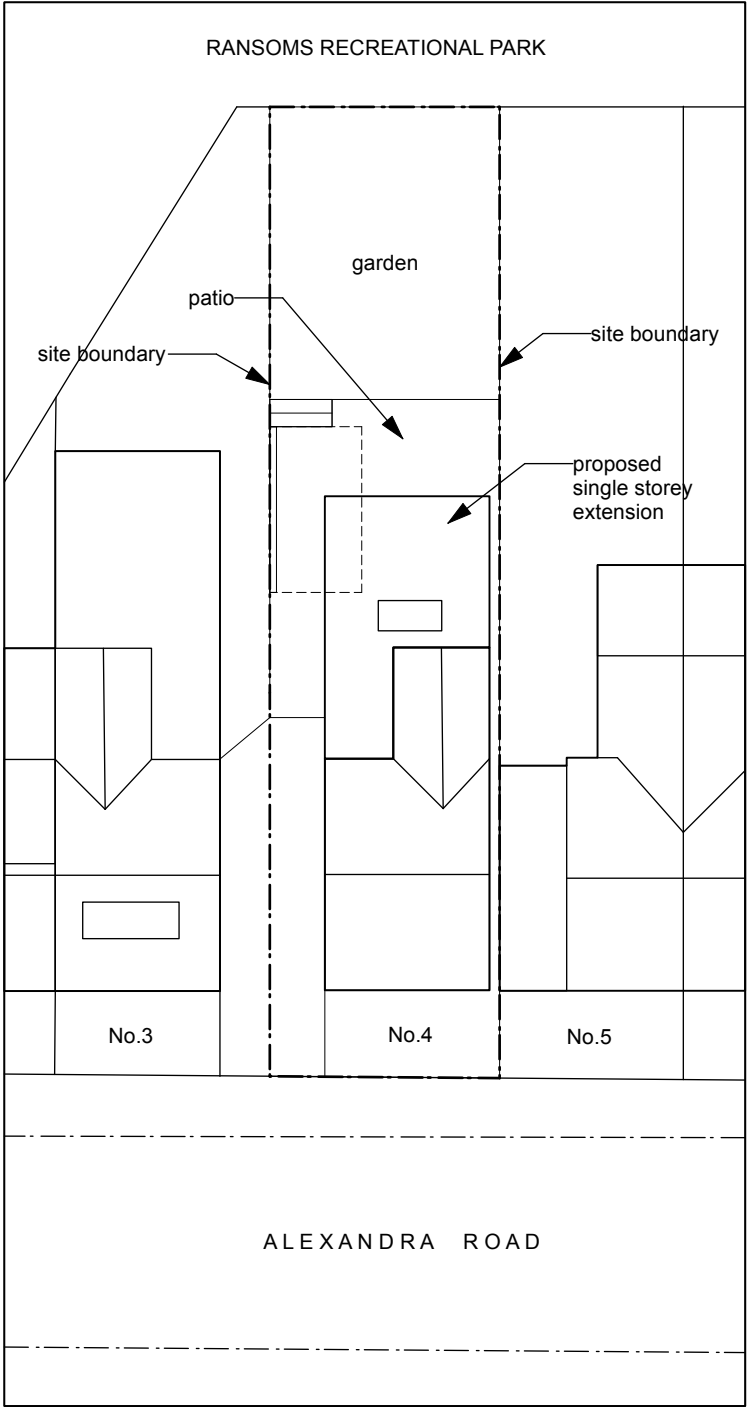

As Built Amended Site Plan (1:250)

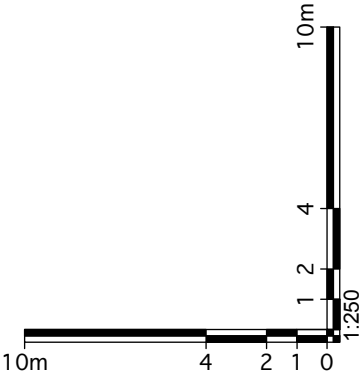

FOR PLANNING APPLICATION PURPOSES ONLY

This drawing has been produced for the applicant for the project/site named below and is submitted as part of a planning/permitted development application relating to this site name only and is not intended for use by any other person or organisation or for any other purpose.

revision	description	date	project	title
A	House numbering amended	8.7.2024	4 Alexandra Road, Hitchin	Approved and Amended Site & Roof Plans
			job no. 368	dwg. no./rev/status PL015
			scale 1:250 @ A3	date May 2025
Nigel Cox Architects				
© Nigel Cox Architects 13 Morningson Welwyn Herts AL6 0AJ 07849 886755 nigelcoxarchitects@gmail.com				