

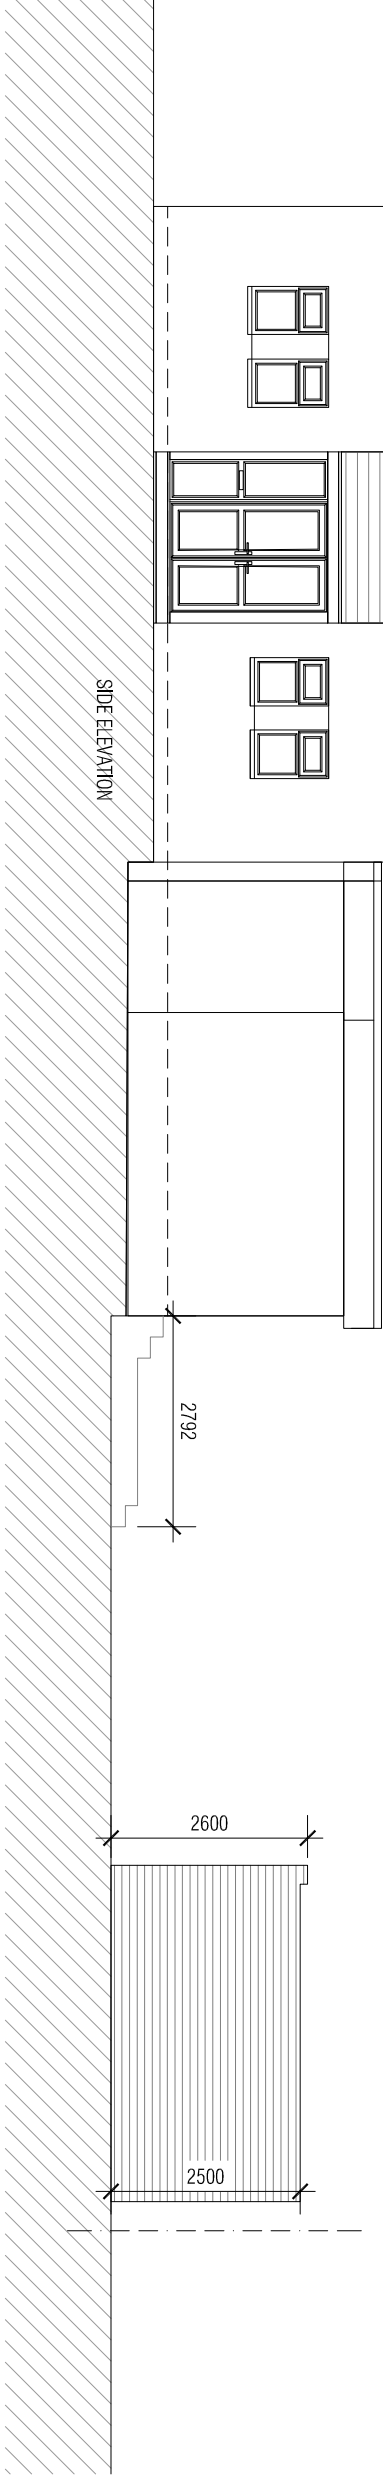
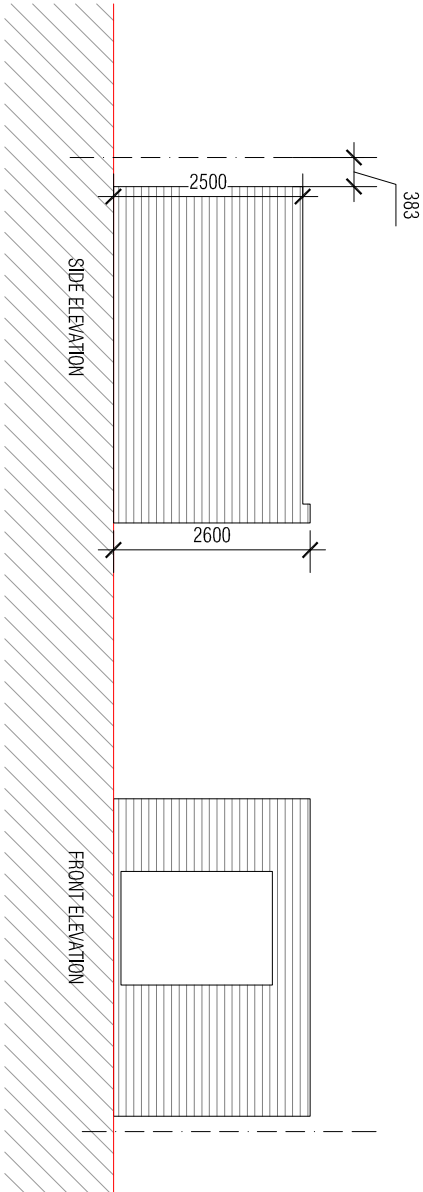
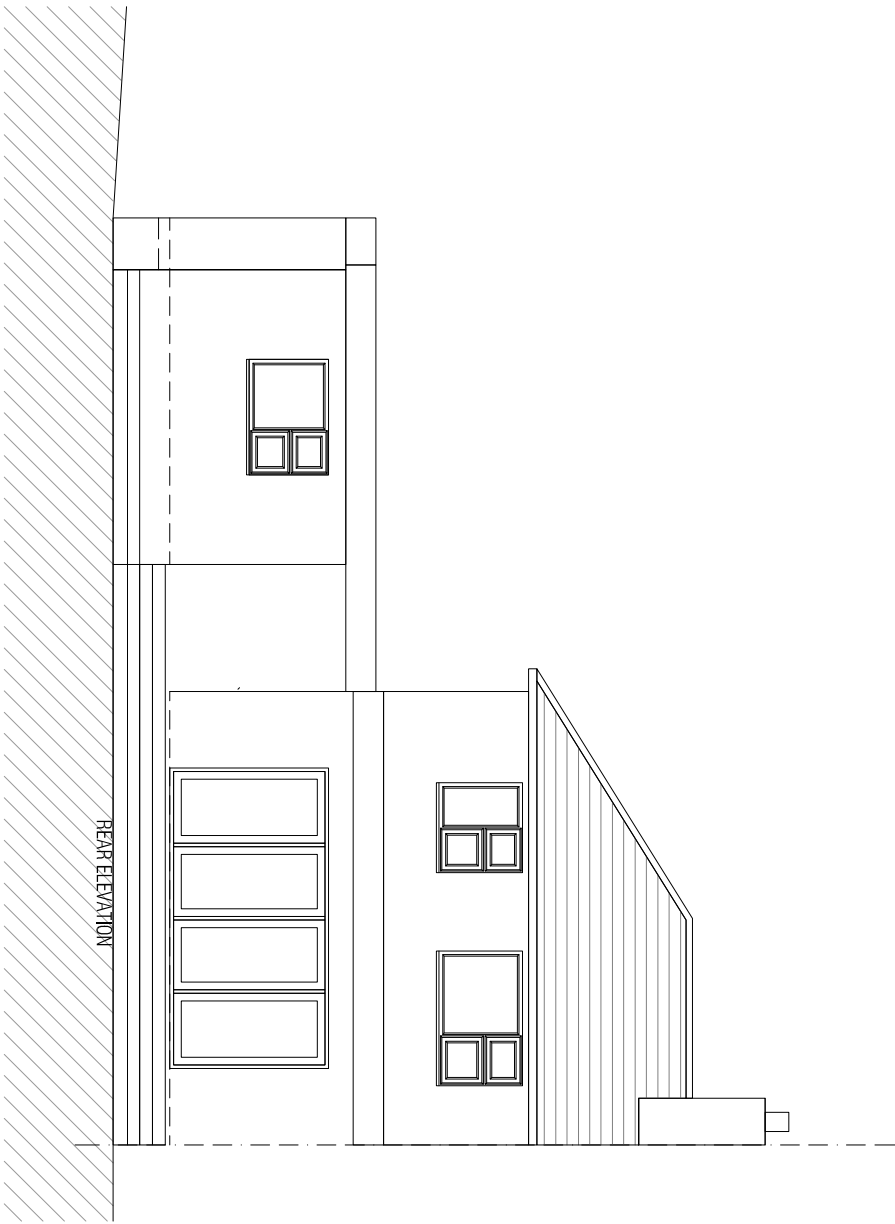


NO DIMENSIONS ARE TO BE SCALED FROM THIS DRAWING. ALL DIMENSIONS STATED MUST BE RECHECKED ON SITE. THE DRAWING IS NOT TO BE USED FOR CONSTRUCTION PRIOR TO ANY ITEM OF WORK BEING PUT IN HAND. THIS DRAWING MUST BE READ TOGETHER WITH THE SPECIFICATION, BILL OF QUANTITIES AND ALL OTHER RELATED DRAWINGS.

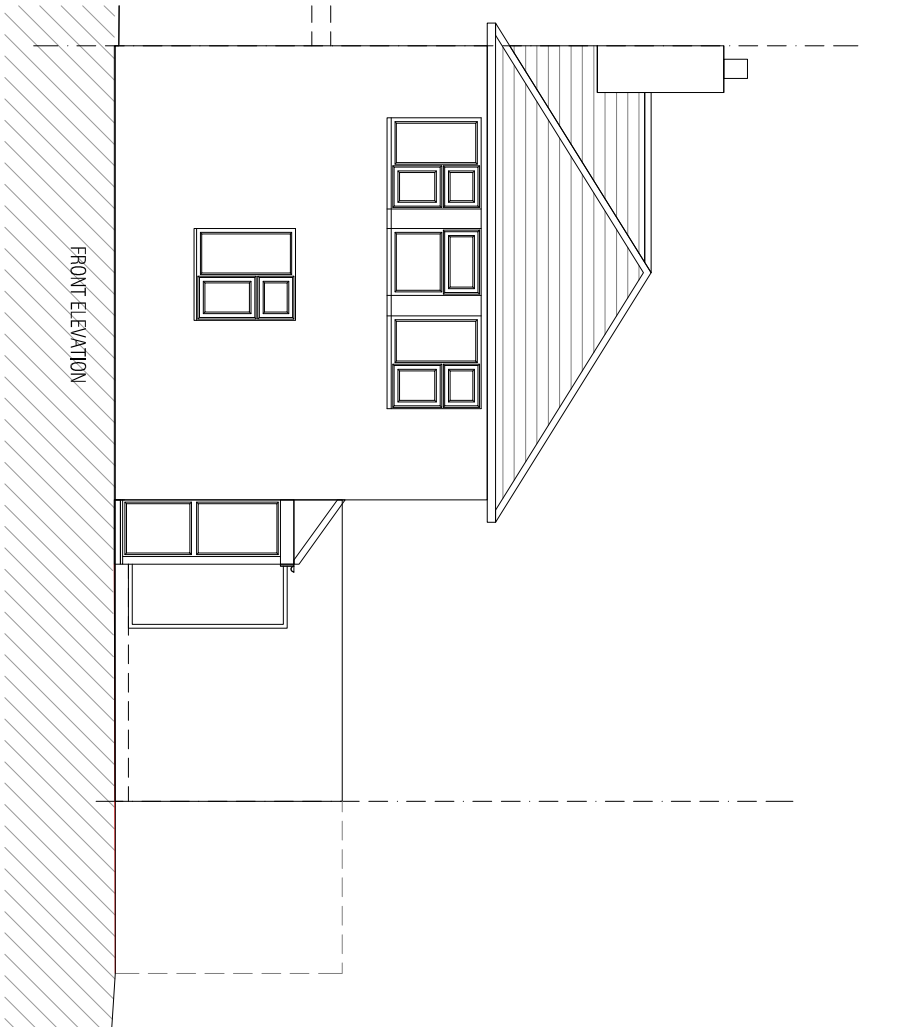

Scale 1:100 0 1 2.5 5 10m

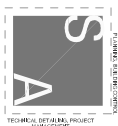

REV A STEPS UPDATED AS BUILT ON SITE 15-04-2025

Project:
31 THATCHERS END
HITCHIN SG4 0PD

Client:

Drawing Title:
PROPOSED ELEVATIONS

Scale: 1:100 @A3
Date: AUGUST 2024
Project No: 24052
Drawing No: A 203
Revision: A