
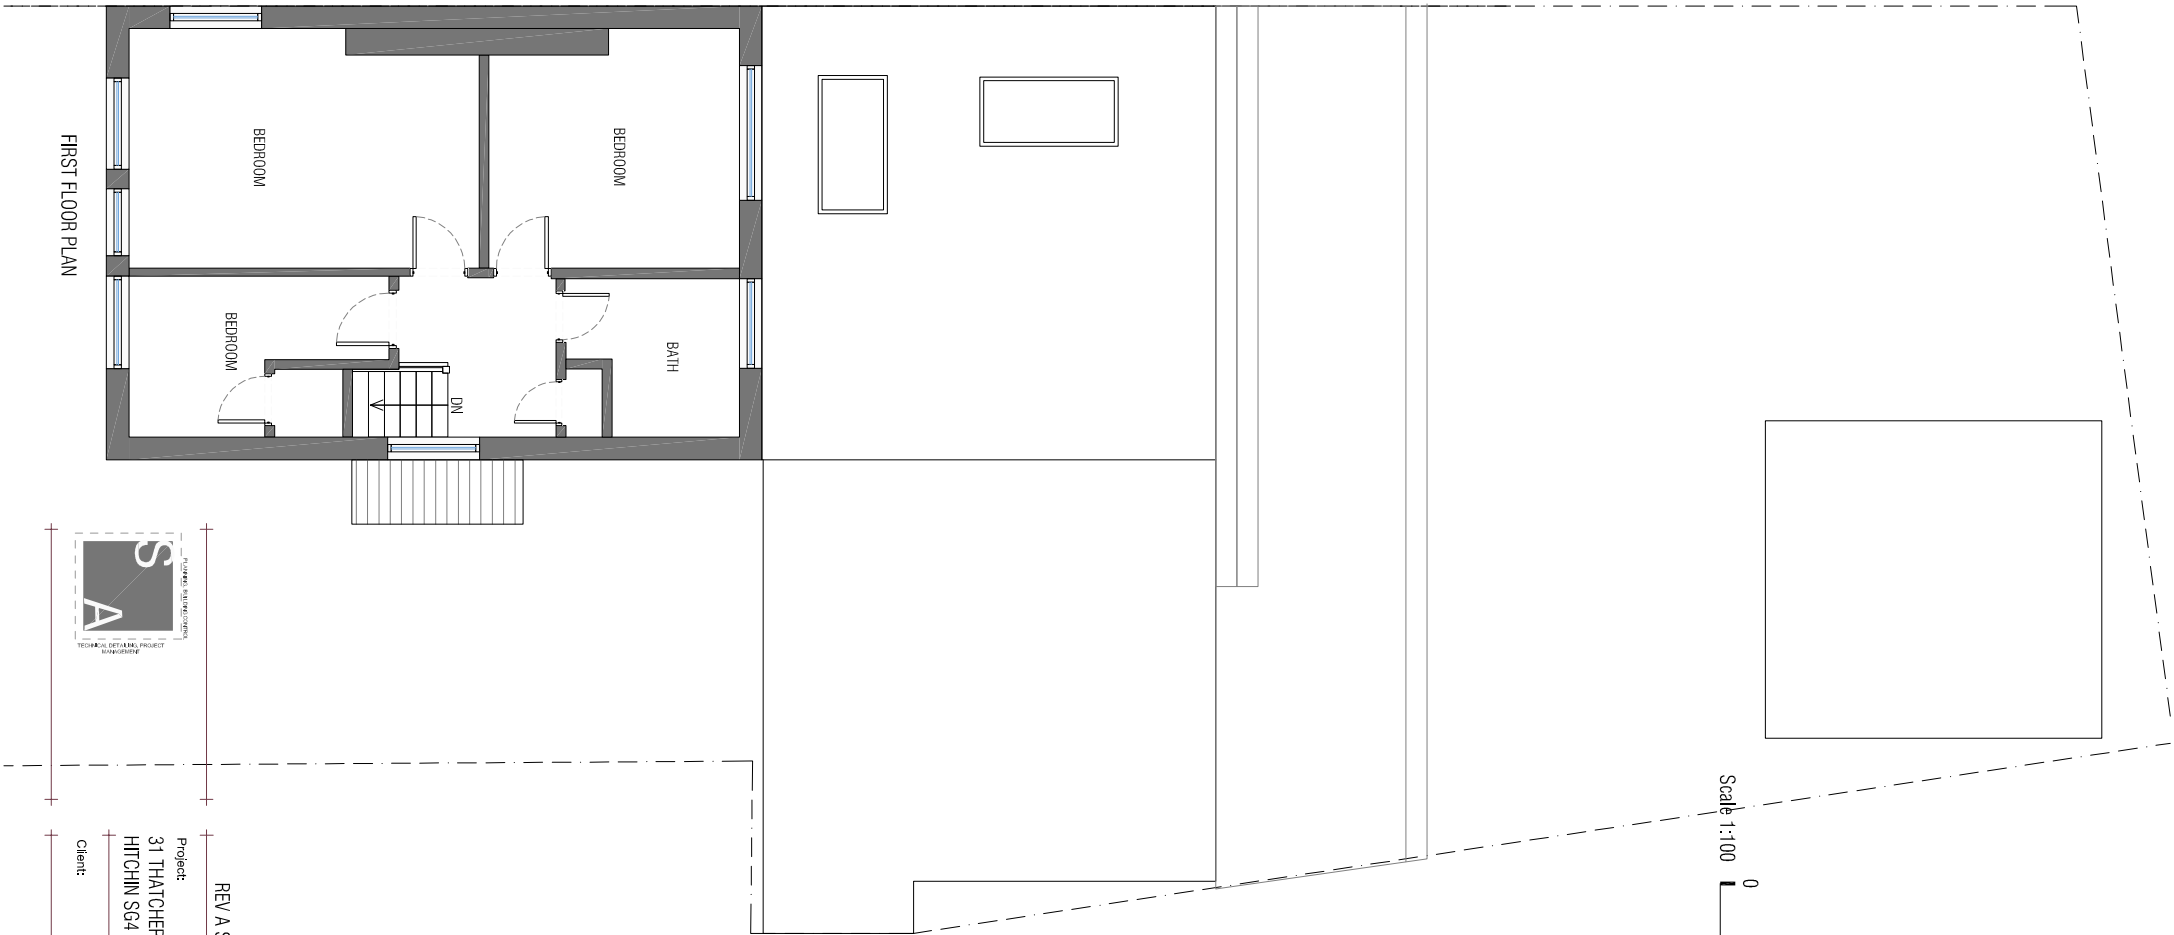


NO DIMENSIONS ARE TO BE SCALED FROM THIS DRAWING. ALL DIMENSIONS STATED MUST BE VERIFIED ON SITE. THE CONSULTANT MUST BE ADVISED OF ANY DISCREPANCIES PRIOR TO CONSTRUCTION. THIS DRAWING MUST BE READ TOGETHER WITH THE SPECIFICATION, BILL OF QUANTITIES AND ALL OTHER RELATED DRAWINGS.

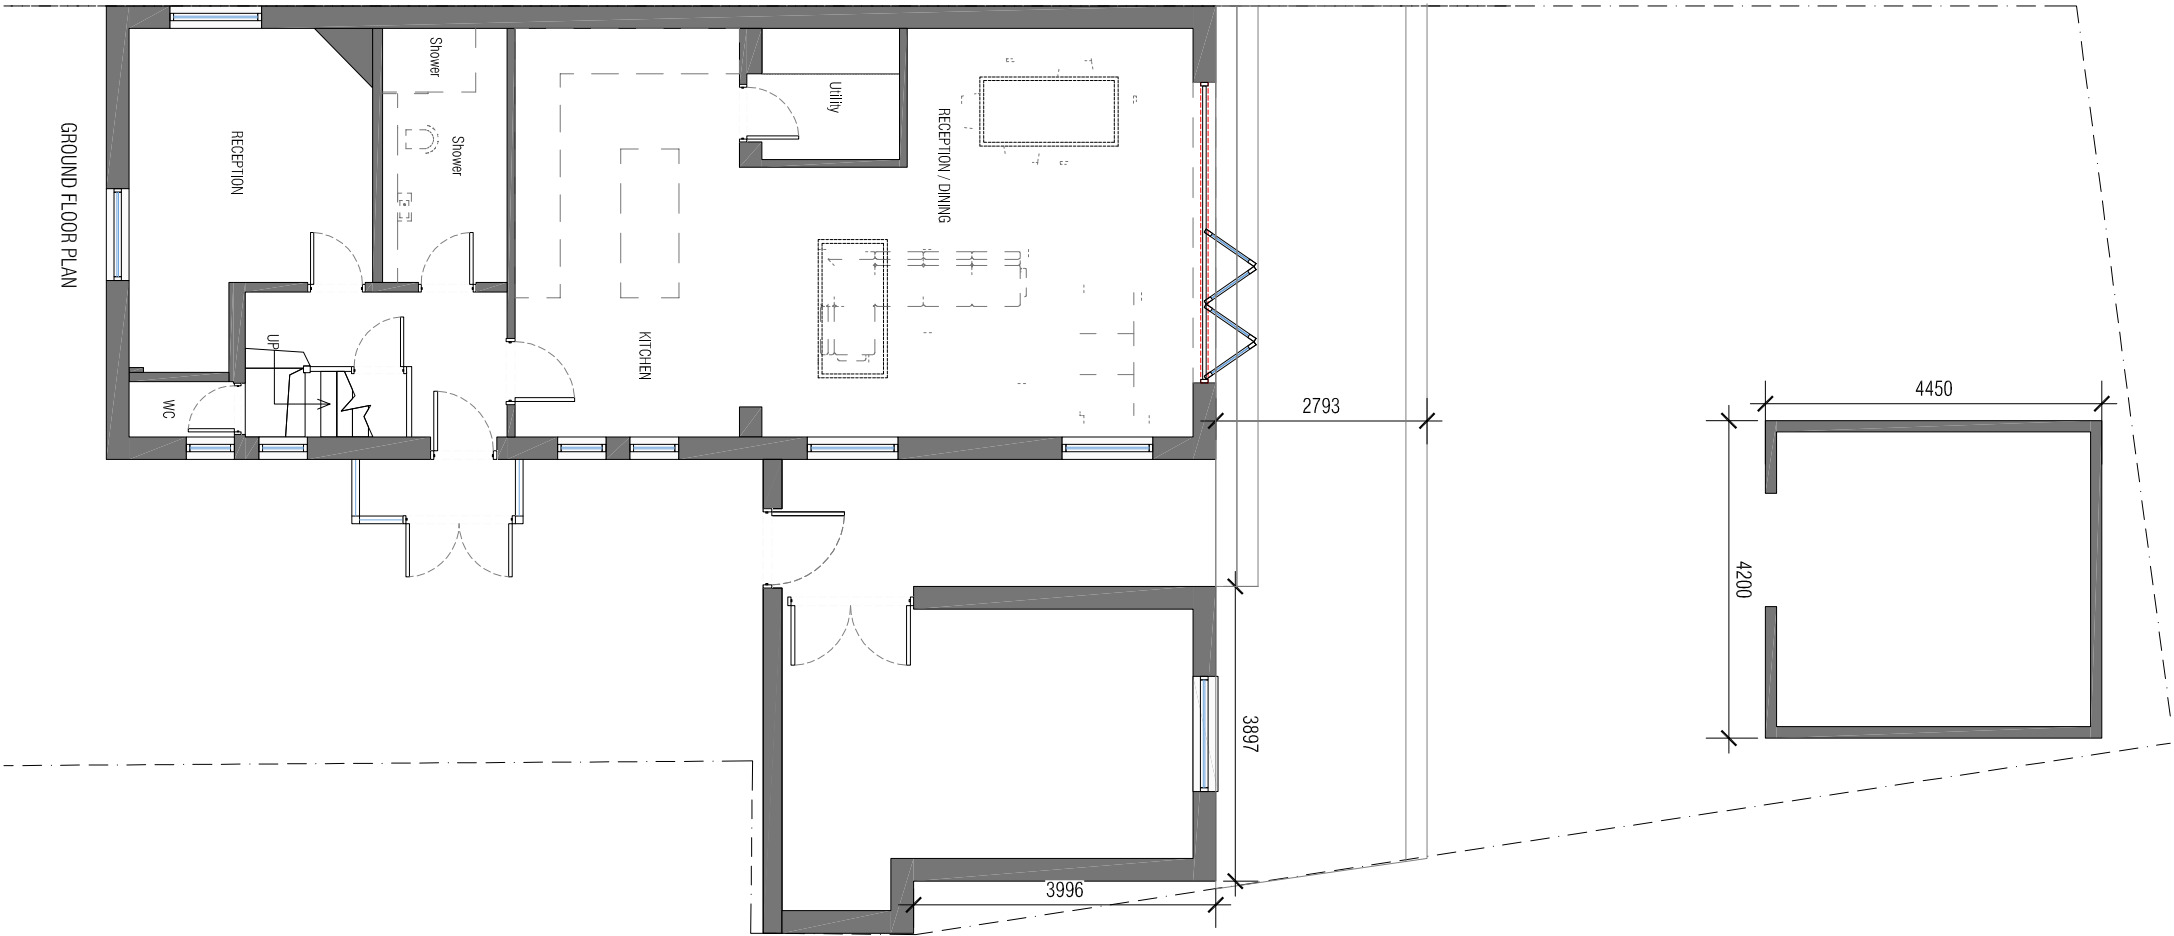

REVA STEPS UPDATED AS BUILT ON SITE 15-04-2025

Project:
31 THATCHERS END
HITCHIN SG4 0PD

Client:

Drawing Title:

PROPOSED FLOOR PLANS

Scale:	Date:	Drawn:	Checked:
1:100 @A3	AUGUST 2024	ZU	SA
Project No:	Drawing No:	Revised:	
24052	A 103	A	