



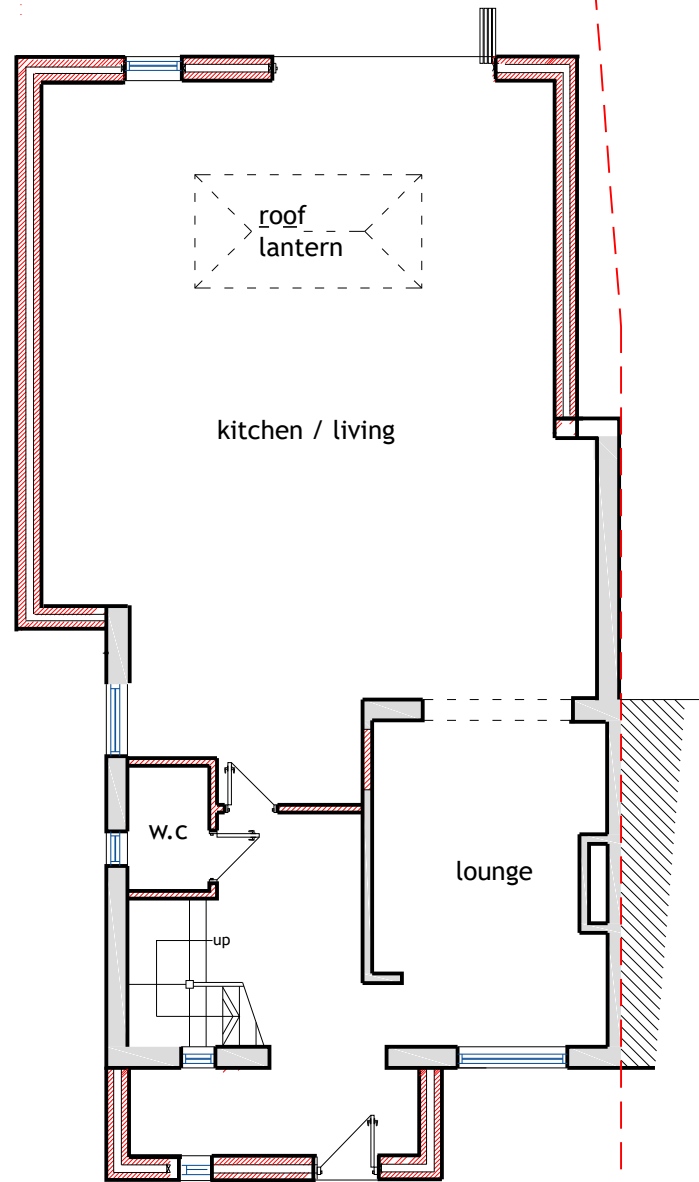

Commenced/ As
built g.f plan

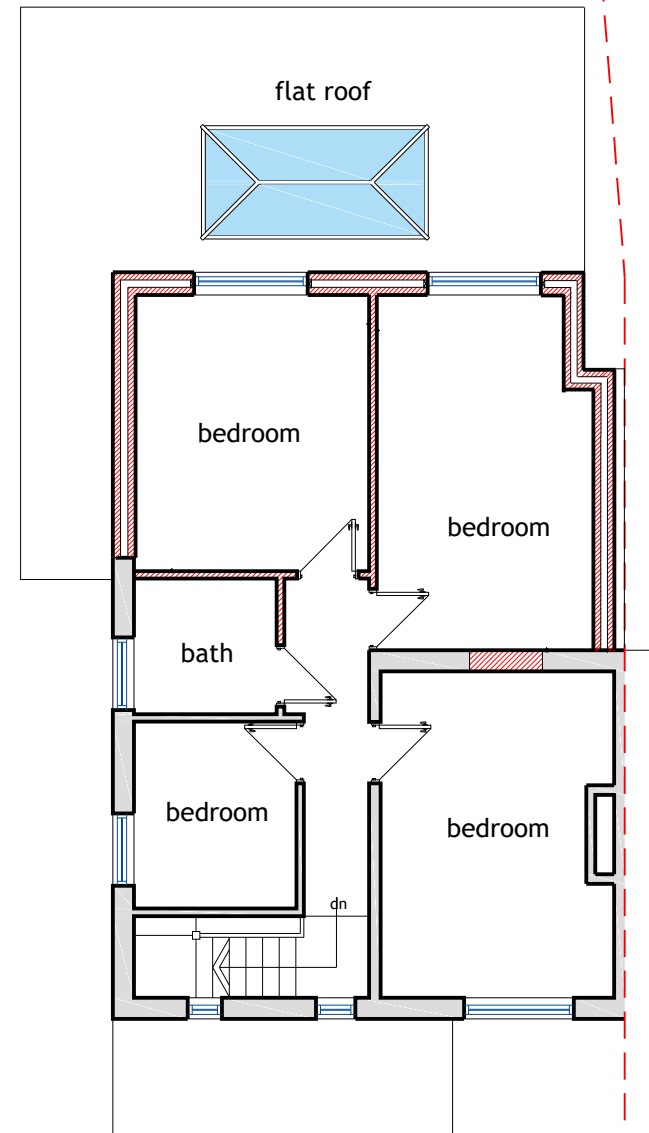

Commenced/As
built f.f plan



general notes

ALL EXTERNAL FINISHING MATERIALS TO MATCH EXISTING.

ALL DIMENSIONS TO BE CHECKED ON SITE PRIOR TO COMMENCEMENT OF WORK.

CONTRACTOR/BUILDER MUST ENSURE ALL NEW GUTTERING, FASCIA, ETC. OF THE NEW ROOF ARE WITHIN BOUNDARY LINE AND MUST NOT PROJECT OVER THE BOUNDARY LINE.

CLIENT AND CONTRACTOR TO ENSURE SAFETY OF ALL ON SITE WHILE DEVELOPMENT IS CARRIED OUT, CDM 2015.

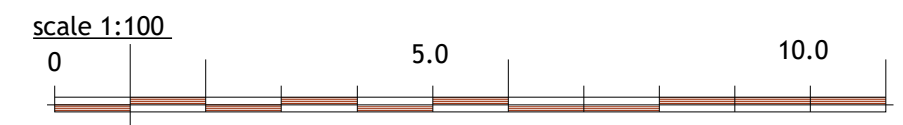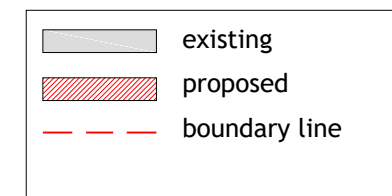

ADDRESS: 28 COMMON RISE, HITCHIN ,SG4 0HN

TITLE: COMMENCED PLANS / AS BUILT

PROJECT: TWO STOREY REAR EXTENSION

DATE 09/12/2025 DWG NO. 28CMN/11

DRAWN BY SCALE 1:100

A3