


A	21.03.25	Updates to suit survey outputs	DC	GW
REV	DATE	DESCRIPTION	DC	GW

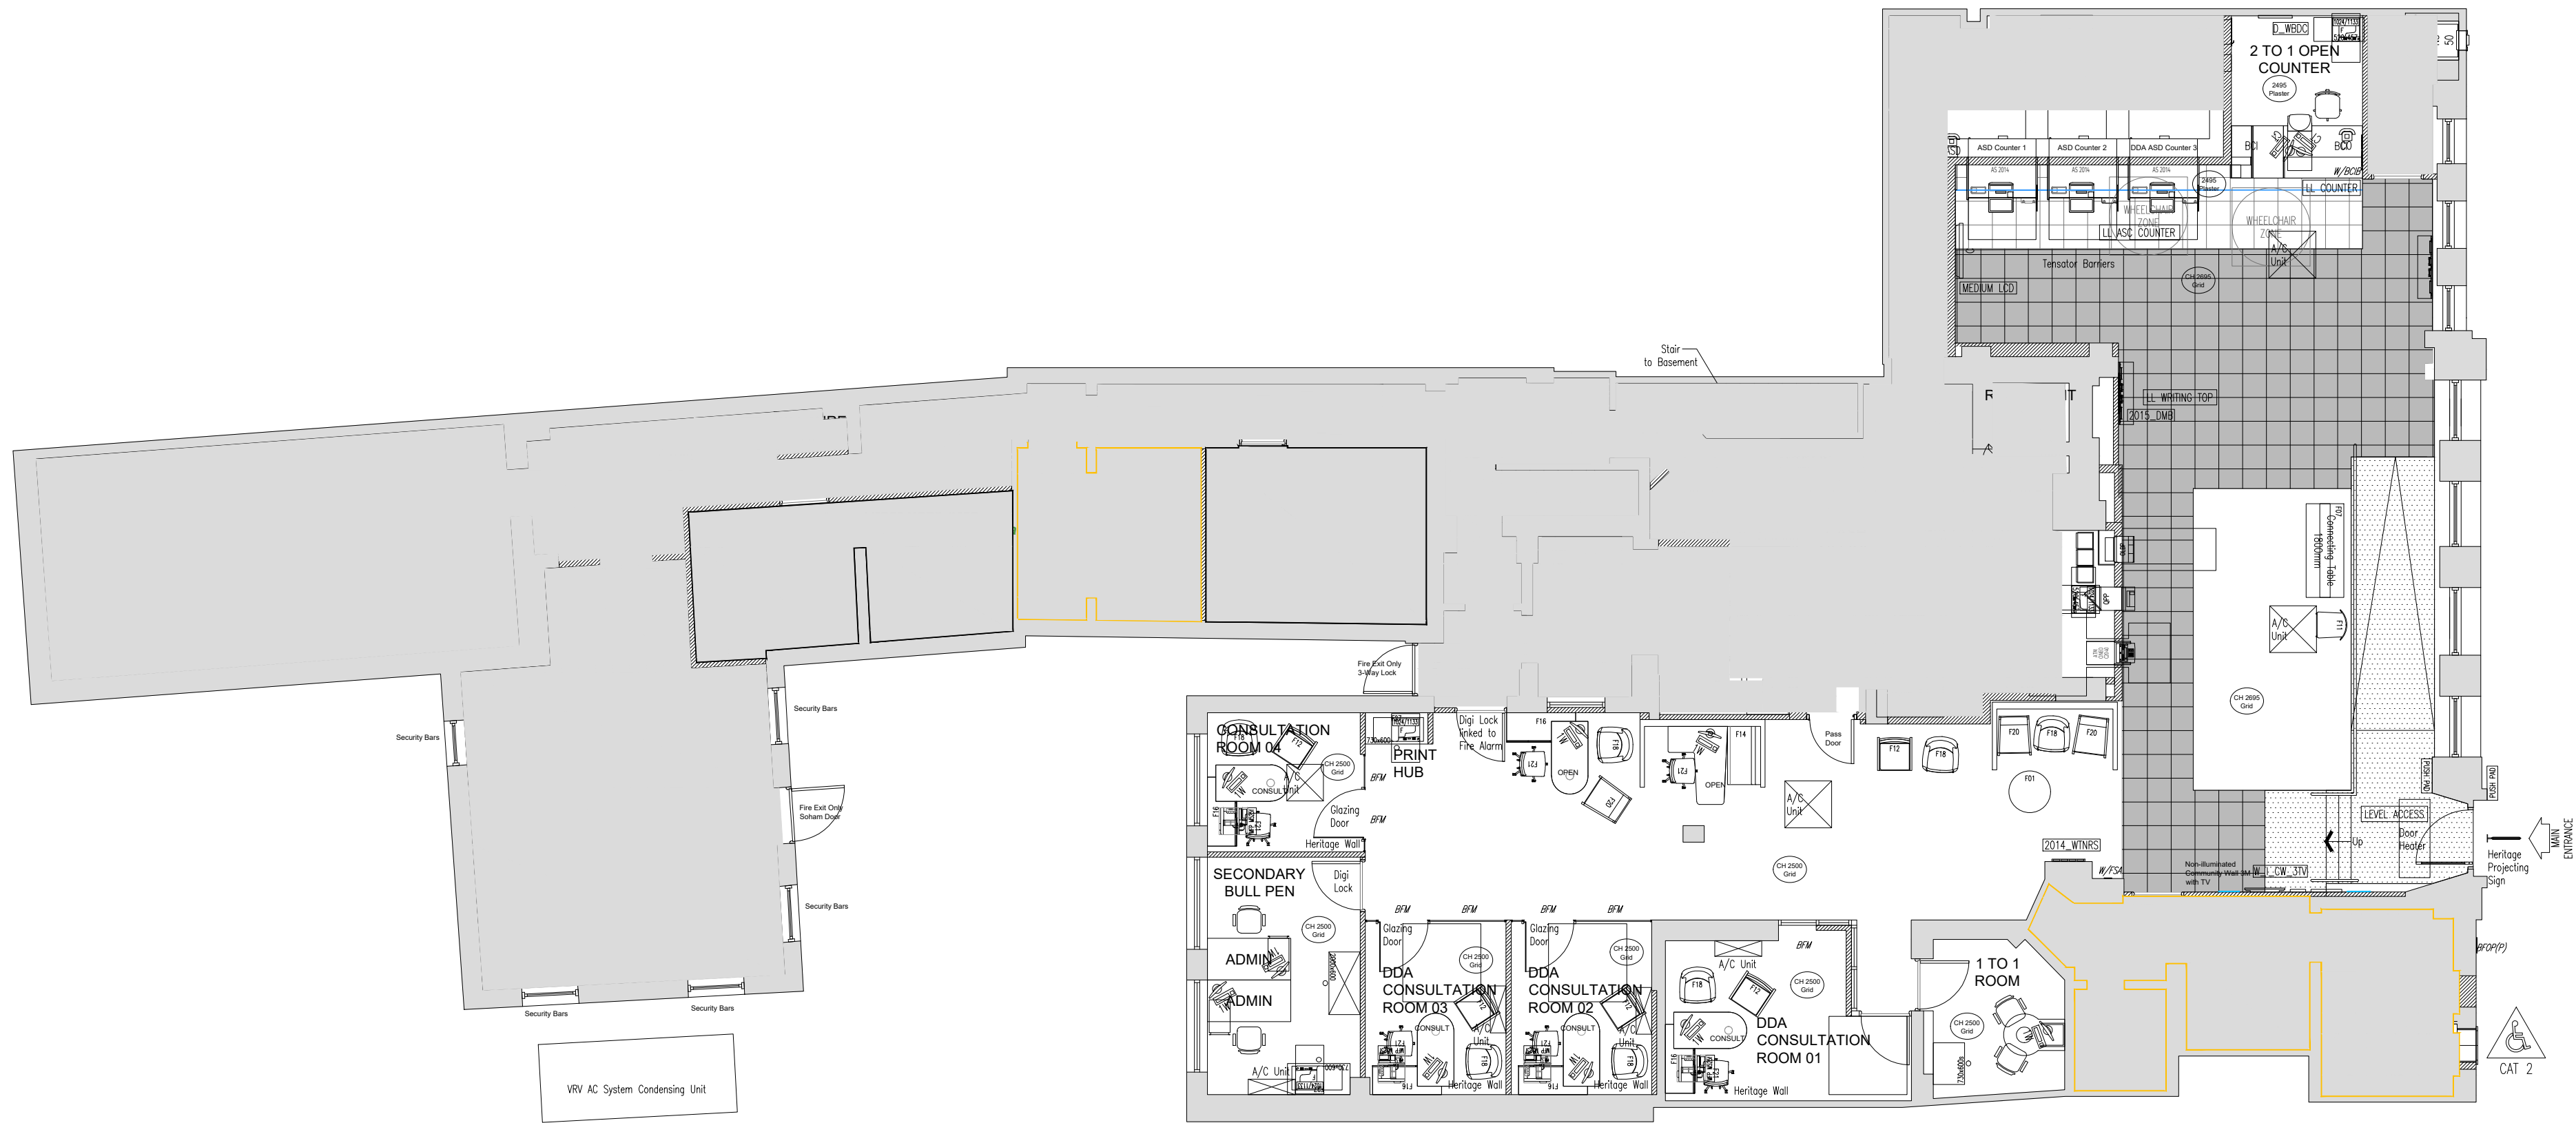

Wates

RECORD DRAWING

DB3

CARDIFF

2 Callaghan Square, Cardiff, CF10 5BT.
T: 029 2034 2686 www.dbs3group.com

CLIENT
BARCLAYS BANK PLC

PROJECT
HITCHIN
5/6 High St, Hitchin SG5 1BH

TITLE
GROUND FLOOR EXISTING GA
ASC ENHANCEMENT PROGRAMME

CREATION DATE	SCALE @ A1	DRN	CHK	APP	SUIT
03/03/2025	1:100@A1	DB3			

SHEET NO.	REVISION
18360 - DB3 - B01 - 00 - DR - A - 20001	A

© COPYRIGHT: ALL RIGHTS RESERVED.
THIS DOCUMENT MUST BE KEPT IN CONNECTION WITH ALL OTHER RELEVANT DRAWINGS AND INFORMATION.
ANY DOCUMENTS MUST BE RETURNED TO DAWTONS IMMEDIATELY.
THIS DRAWING INFORMATION MUST NOT BE USED FOR CONSTRUCTION UNLESS EXPRESSLY ISSUED FOR CONSTRUCTION.

DO NOT SCALE FROM THIS DRAWING. WORK ONLY TO THE PRINTED DIMENSIONS.