


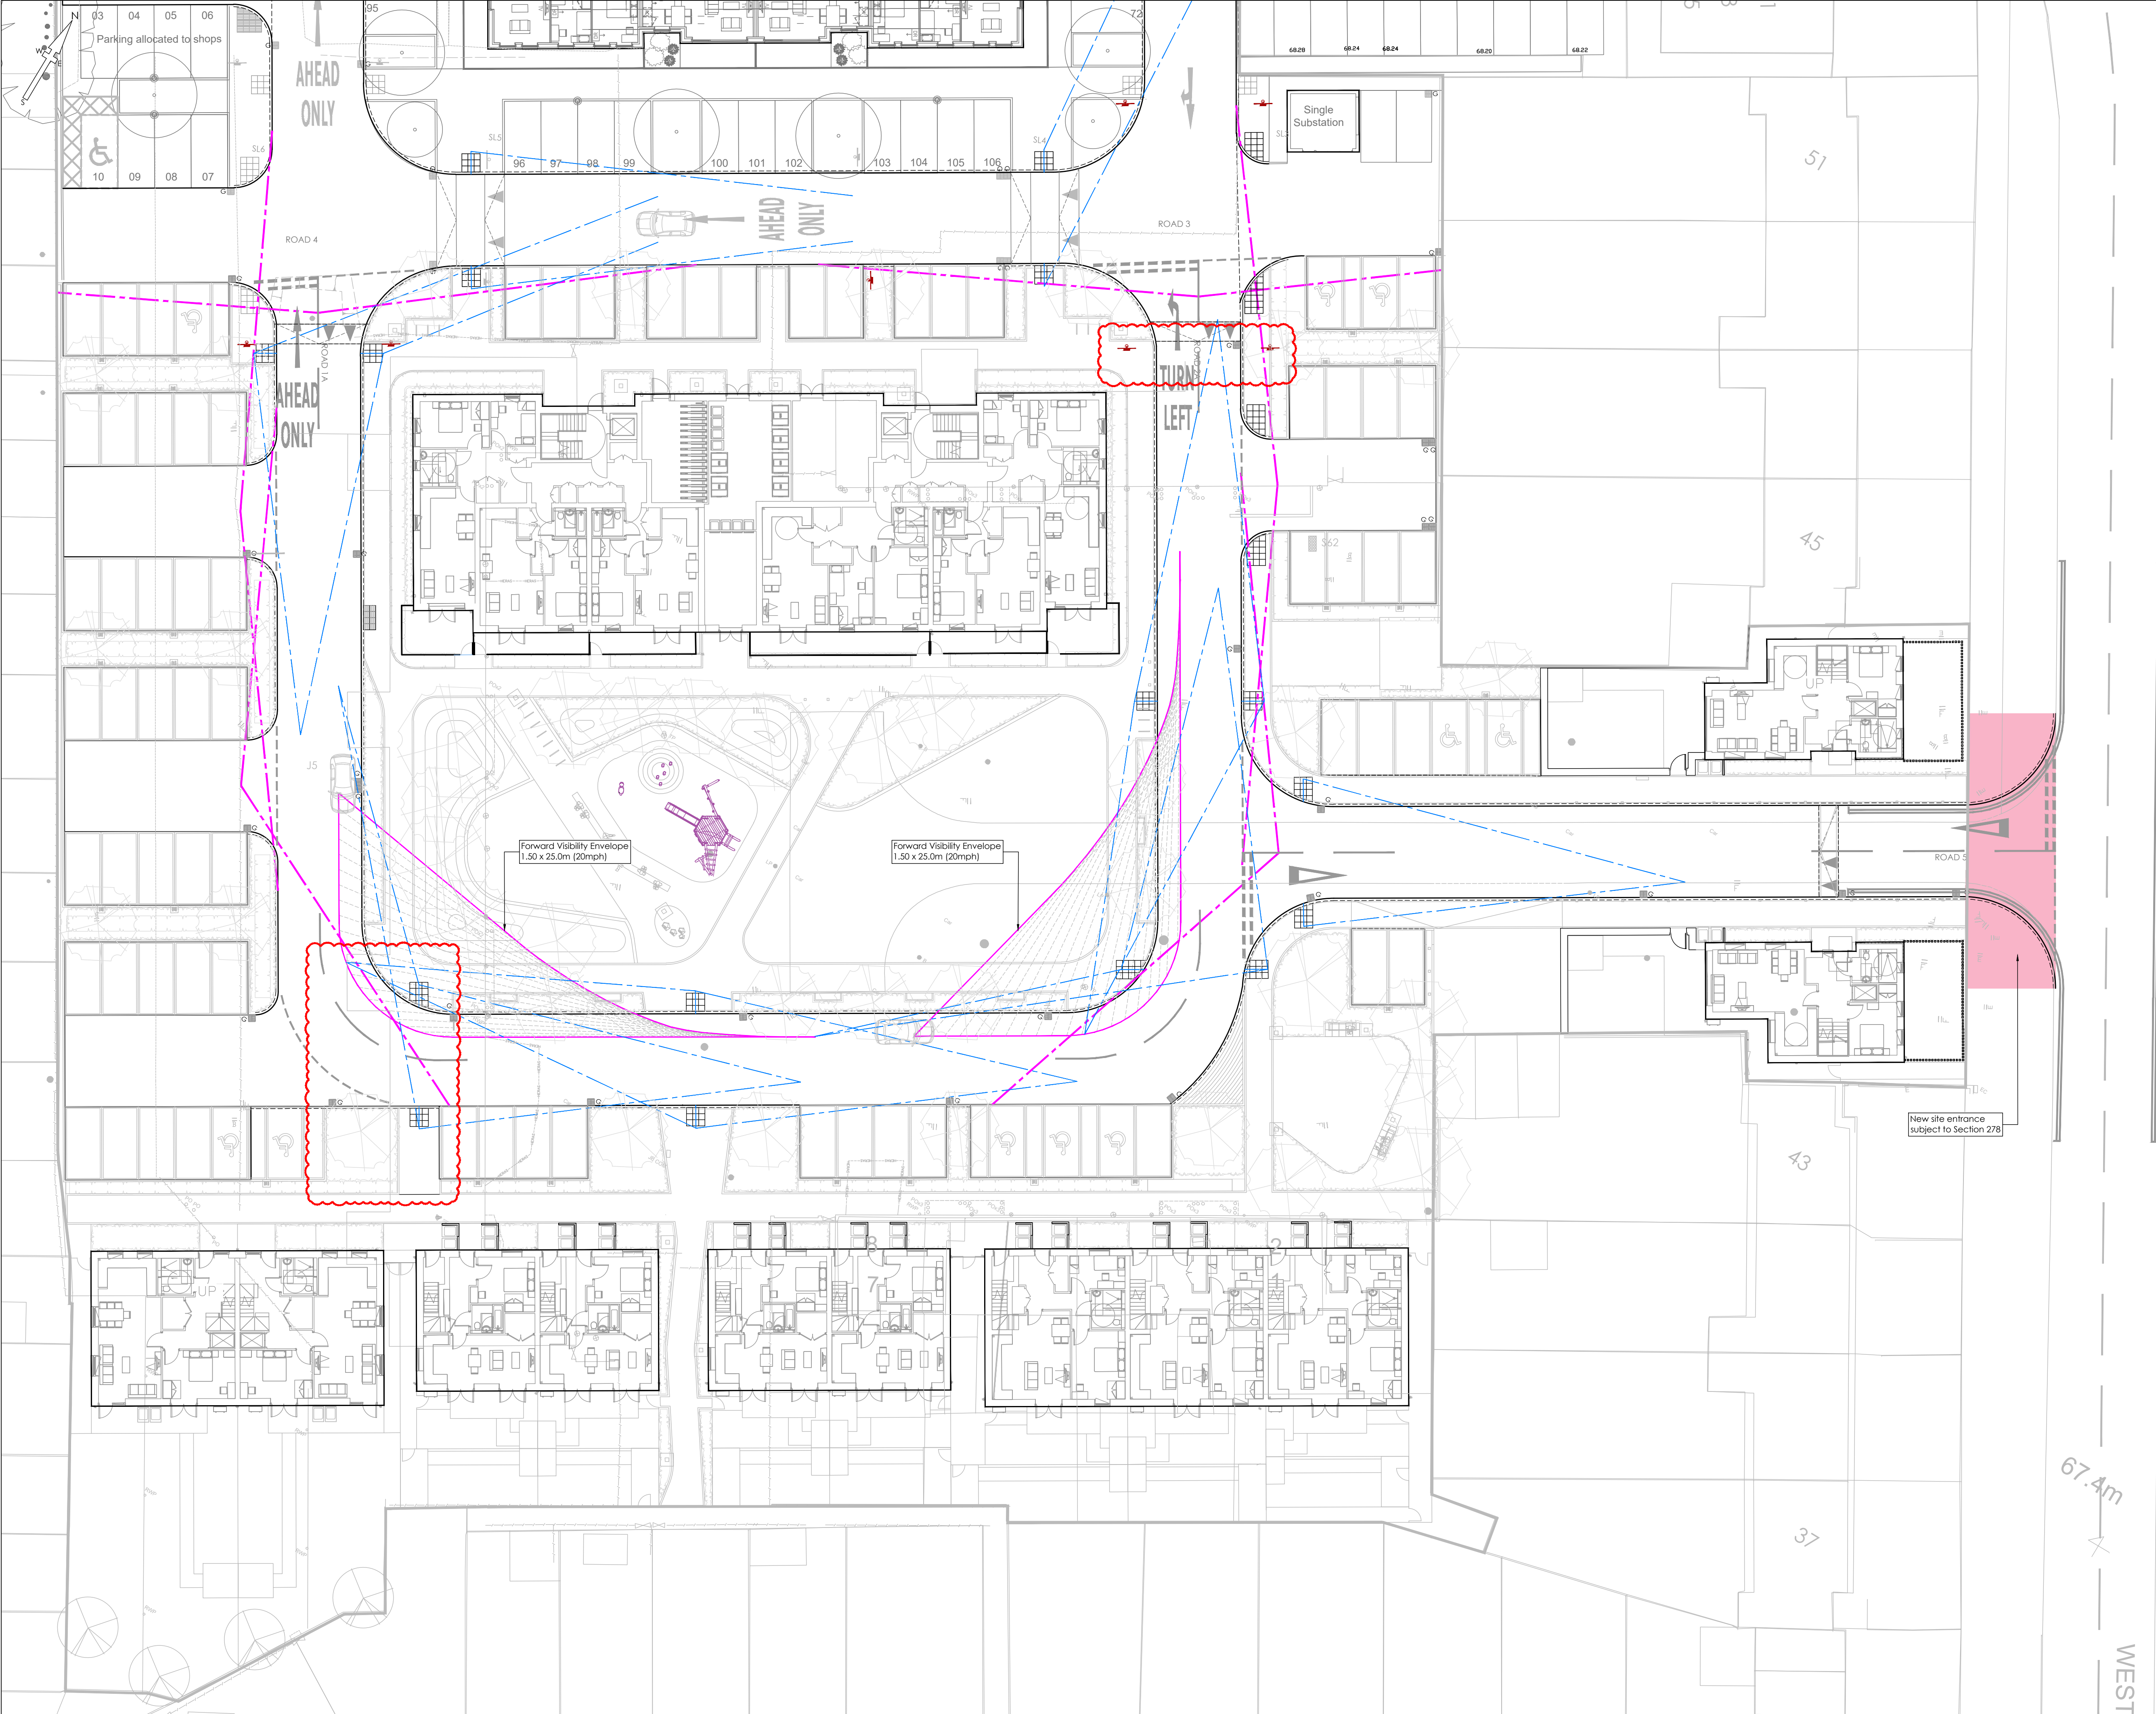

Survey: SOR018003 Sheet: 1/2/3
Site Plan: MW201113-HUN-00-ZZ-DR-A-3001 P1
Rec'd: 05.10.2020
Rec'd: 20.11.2020

NOTES

- All dimensions and levels are in metres unless otherwise noted
- This drawing is to be read in conjunction with the relevant Architect's/Engineer's drawings, specifications and CDM documentation
- This drawings has been produced electronically and may have been photo reduced or enlarged when copied. Work to figured dimensions only (DO NOT SCALE). All dimensions to be checked on site. Any errors or omissions to be reported to the engineer immediately.
- This drawing contains coloured lines / information that may not be clear if reproduced in black and white.
- Digital copies of this plan can only be considered accurate if supplied directly by Infrastruct CS Ltd.

DESIGNERS CDM NOTE - RESIDUAL RISKS NOT IDENTIFIED

The design Engineer(s) have assessed this design as the scheme has been developed in order to identify if there are any residual risk hazards (i.e. unusual, unexpected, abnormal or difficult).

No residual risks have been identified for this scheme and therefore no entries were added to the risk register.

This statement assumes that a competent Contractor with the appropriate qualified staff will be employed for the works, and that they will be familiar with site wide construction risks and hazards that they can reasonably be expected to encounter as part of their work.

Section 38 Legend

	Section 278 Agreement Works
	Junction Visibility - 2.40 x 25.0m (20mph)
	Forward Visibility envelope - 1.50 x 25.0m (20mph)
	Pedestrian Visibility - 1.50 x 25.0m (20mph) Measured to 1.50m off Kerbline (oncoming Traffic Direction)

AWAITING ISSUE
ELECTRONIC COPY MUST BE PRINTED
AT TIME OF ISSUE

P02	SNN	Site layout updated. Pedestrian Crossing Points amended	06/08/25	
P01	SNN	APL Initial Issue	06/05/25	
REV	DRAWN	CHECK	REVISION COMMENTS	ISSUE DATE
DRAWING TITLE				SHEET NO.
Section 38 Agreement Plan Phase 3 - Visibility Splays				1
PROJECT				
John Barker Place Hitchin Hertfordshire				
CLIENT				
Settle				
SCALE @ A1 1:200				
ENGINEER MBD				
DRAFT SNN				
APPROVED RJW				
PROJECT ORIGIN VOLUME LEVEL TYPE ROLE NO. REVISION				
MW201113 ICS 00 ZZ DR C 0527 P02				