




CAN BE SCALED FOR PLANNING PURPOSES ONLY
All dimensions to be verified on site

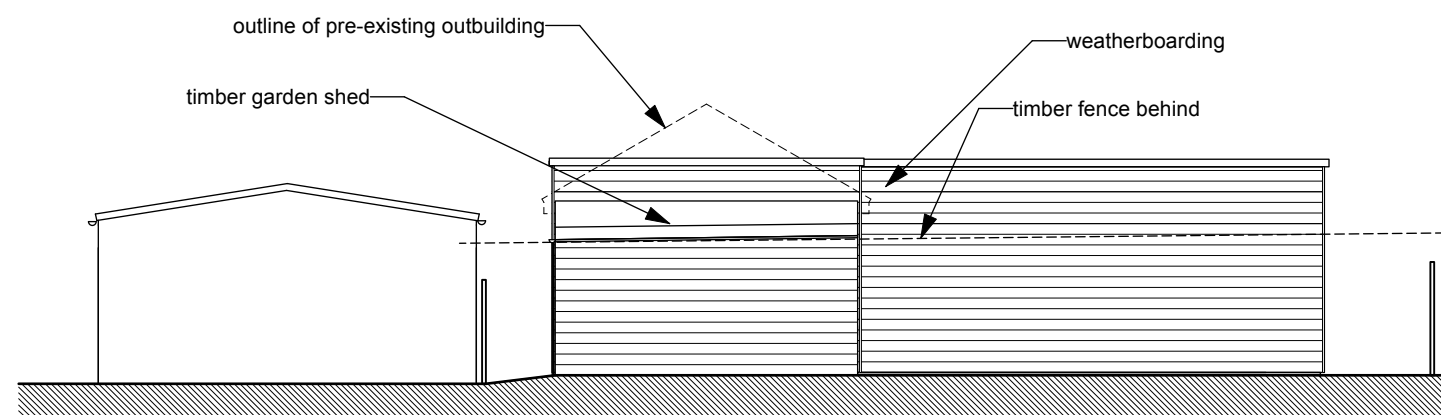


As-built North Elevation (1:100)

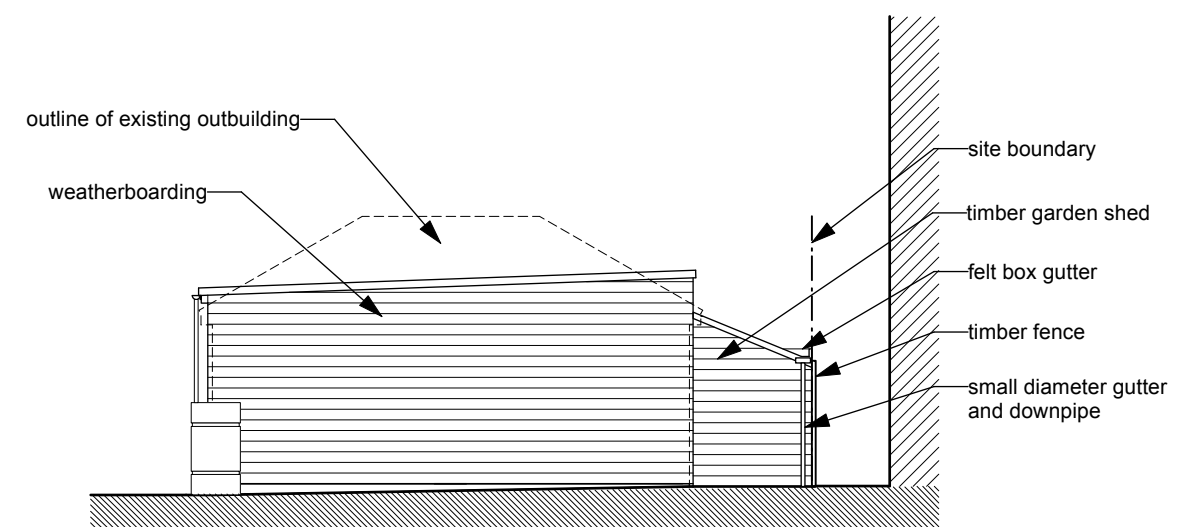


A-built East Elevation (1:100)

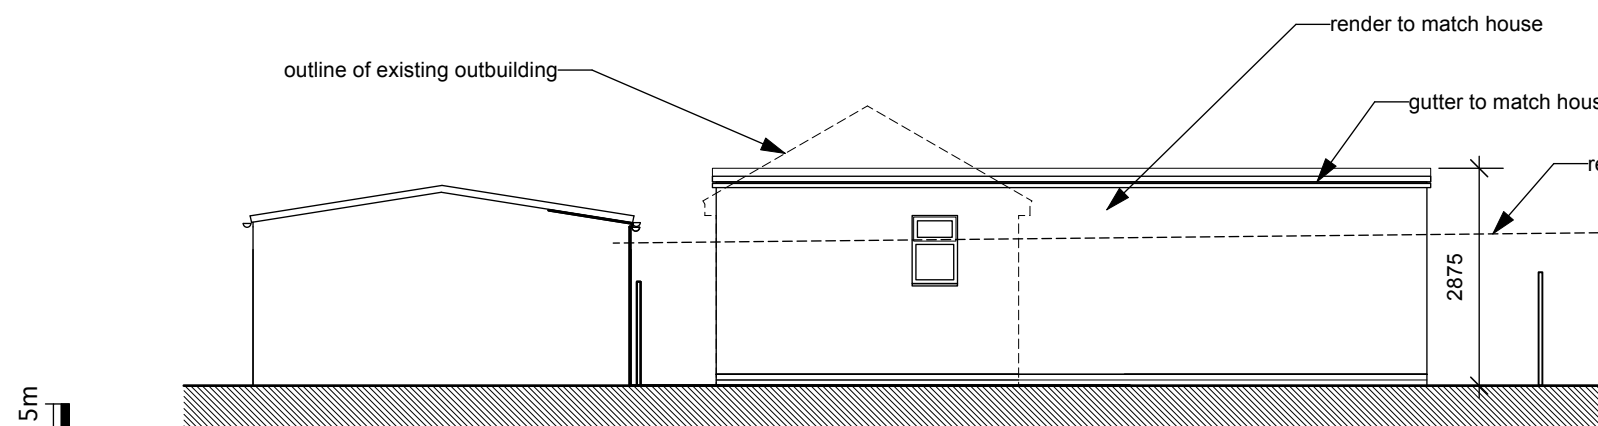

Approved North Elevation (1:100)

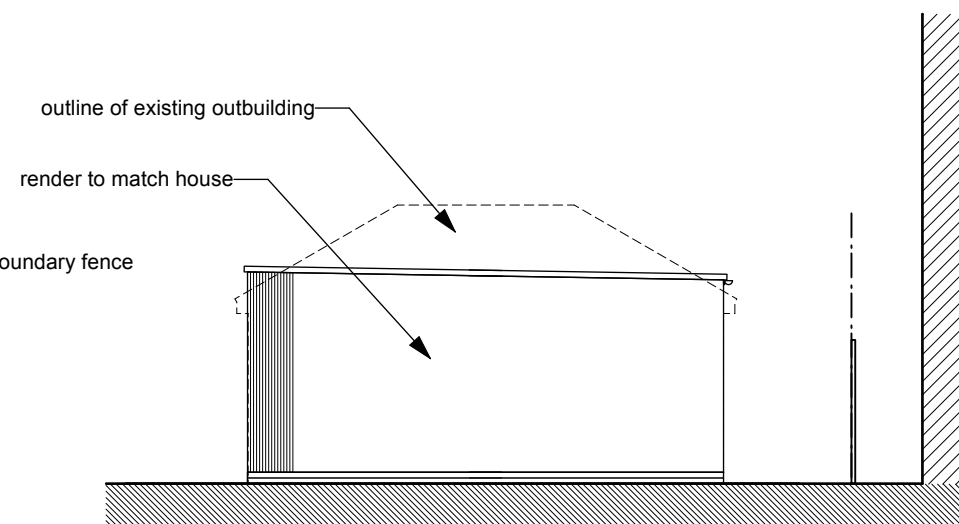

Approved East Elevation (1:100)

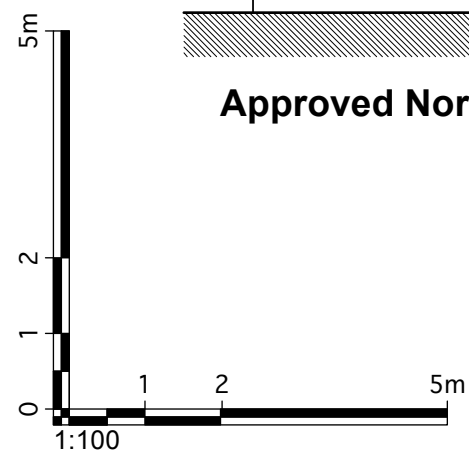

FOR PLANNING APPLICATION PURPOSES ONLY

This drawing has been produced for Mr and Mrs Turner for the project/site named below and is submitted as part of a planning/permitted development application relating to this site name only and is not intended for use by any other person or organisation or for any other purpose.

revision	description	date	project	title
A.	Lean-to shed to rear of outbuilding alignment at rear boundary adjusted as existing	Oct 2025	10 West Hill, Hitchin	Approved & As-built Elevations 1
			job no. 372/3	dwg. no./rev/status PL0005B
B.	Drawing titles amended	Oct 2025	scale 1:100 @ A3	date August 2025

Nigel Cox Architects

© Nigel Cox Architects 13 Mornington Welwyn Herts AL6 0AJ 07849 886755 nigelcoxarchitects@gmail.com