




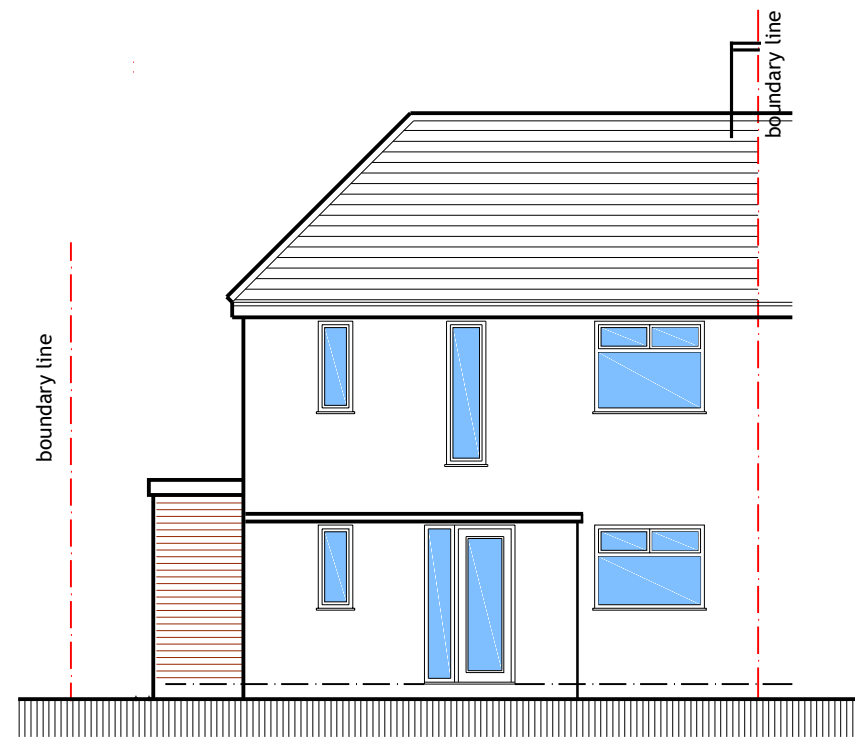


Commenced/ as built front elevation

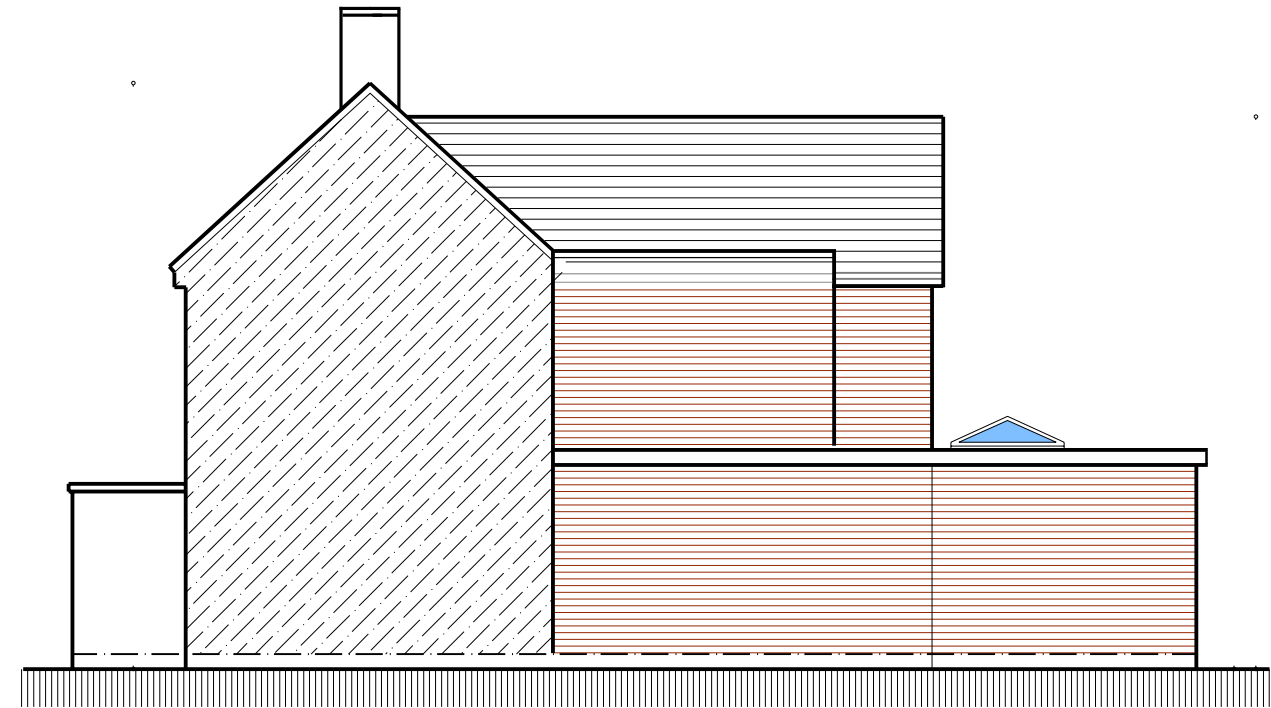


Commenced/ as built side elevation

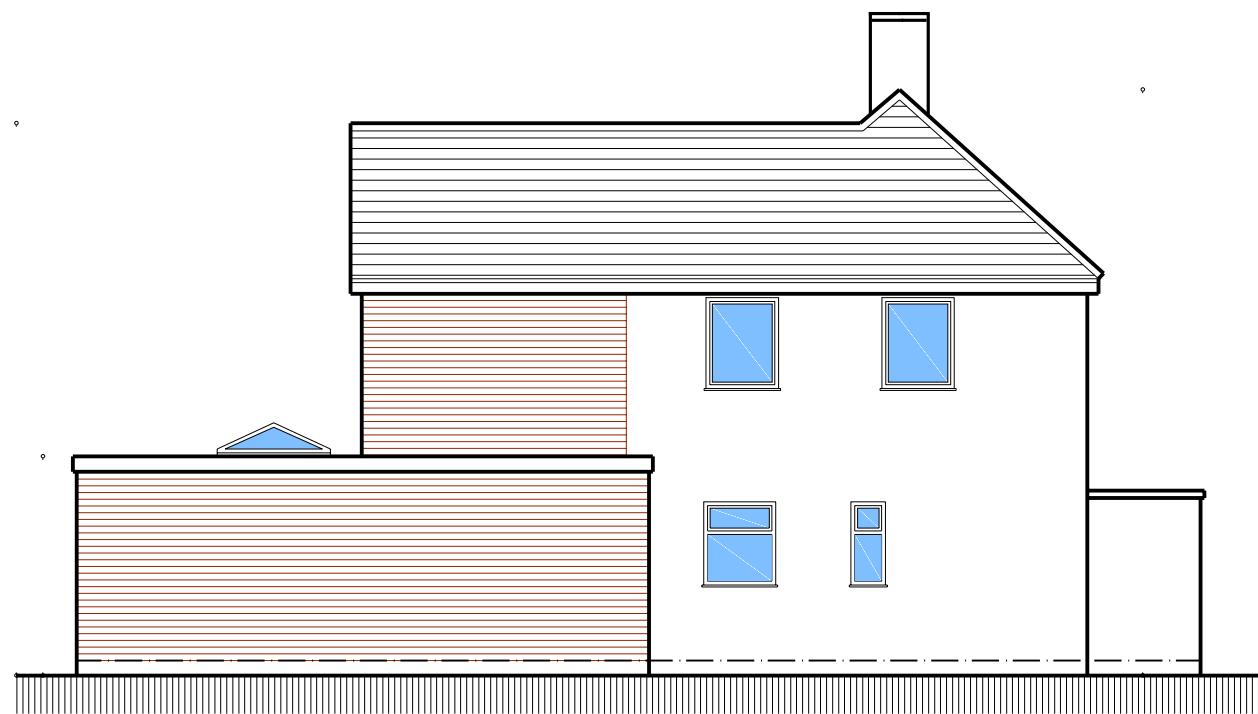

Commenced/ as built side elevation

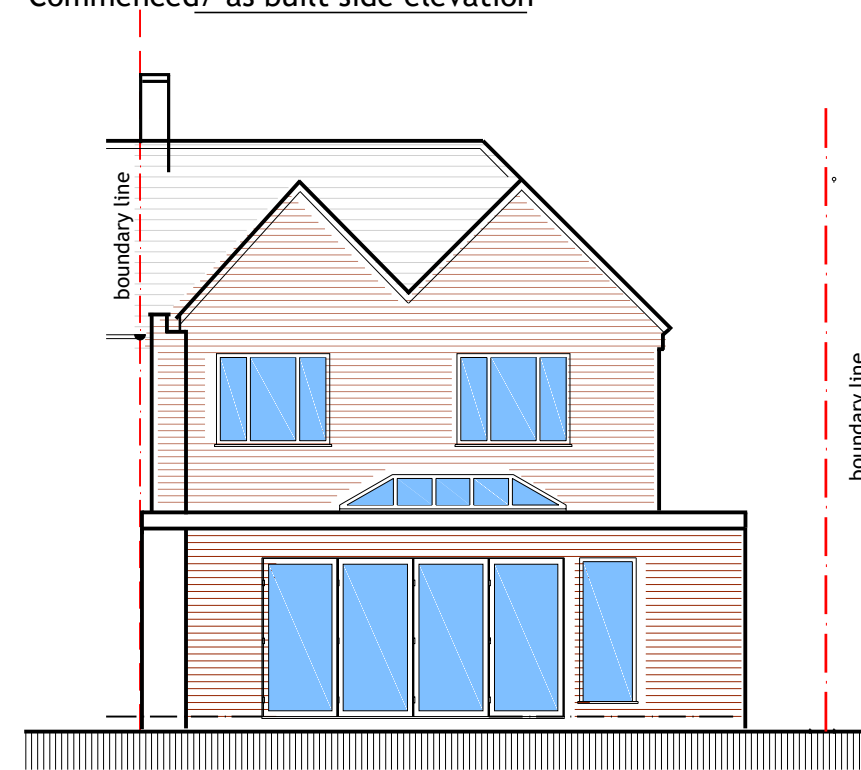

Commenced/ as built rear elevation

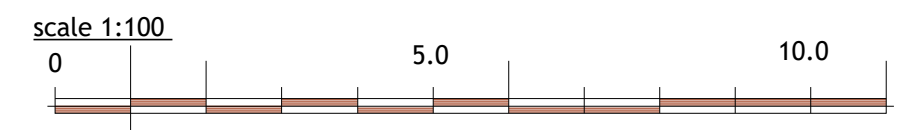

ADDRESS: 28 COMMON RISE, HITCHIN ,SG4 0HN

TITLE: COMMENCED AS BUILT ELEVATIONS

PROJECT: TWO STOREY REAR EXTENSION

DATE
DRAWN BY

09/12/2025

DWG NO.
SCALE

28CMN/12
1:100

A3