





Pre-existing Front elevation (1:100 scale)

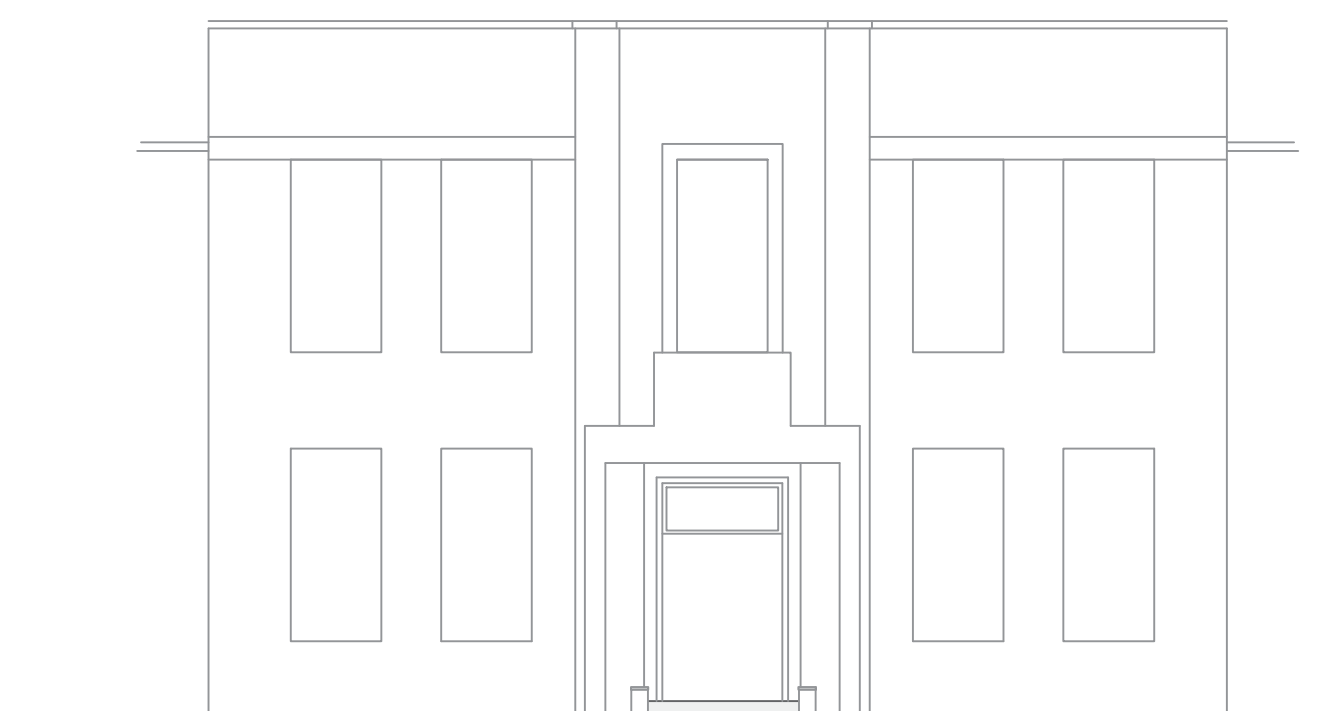

As-Built front elevation (1:100 scale)

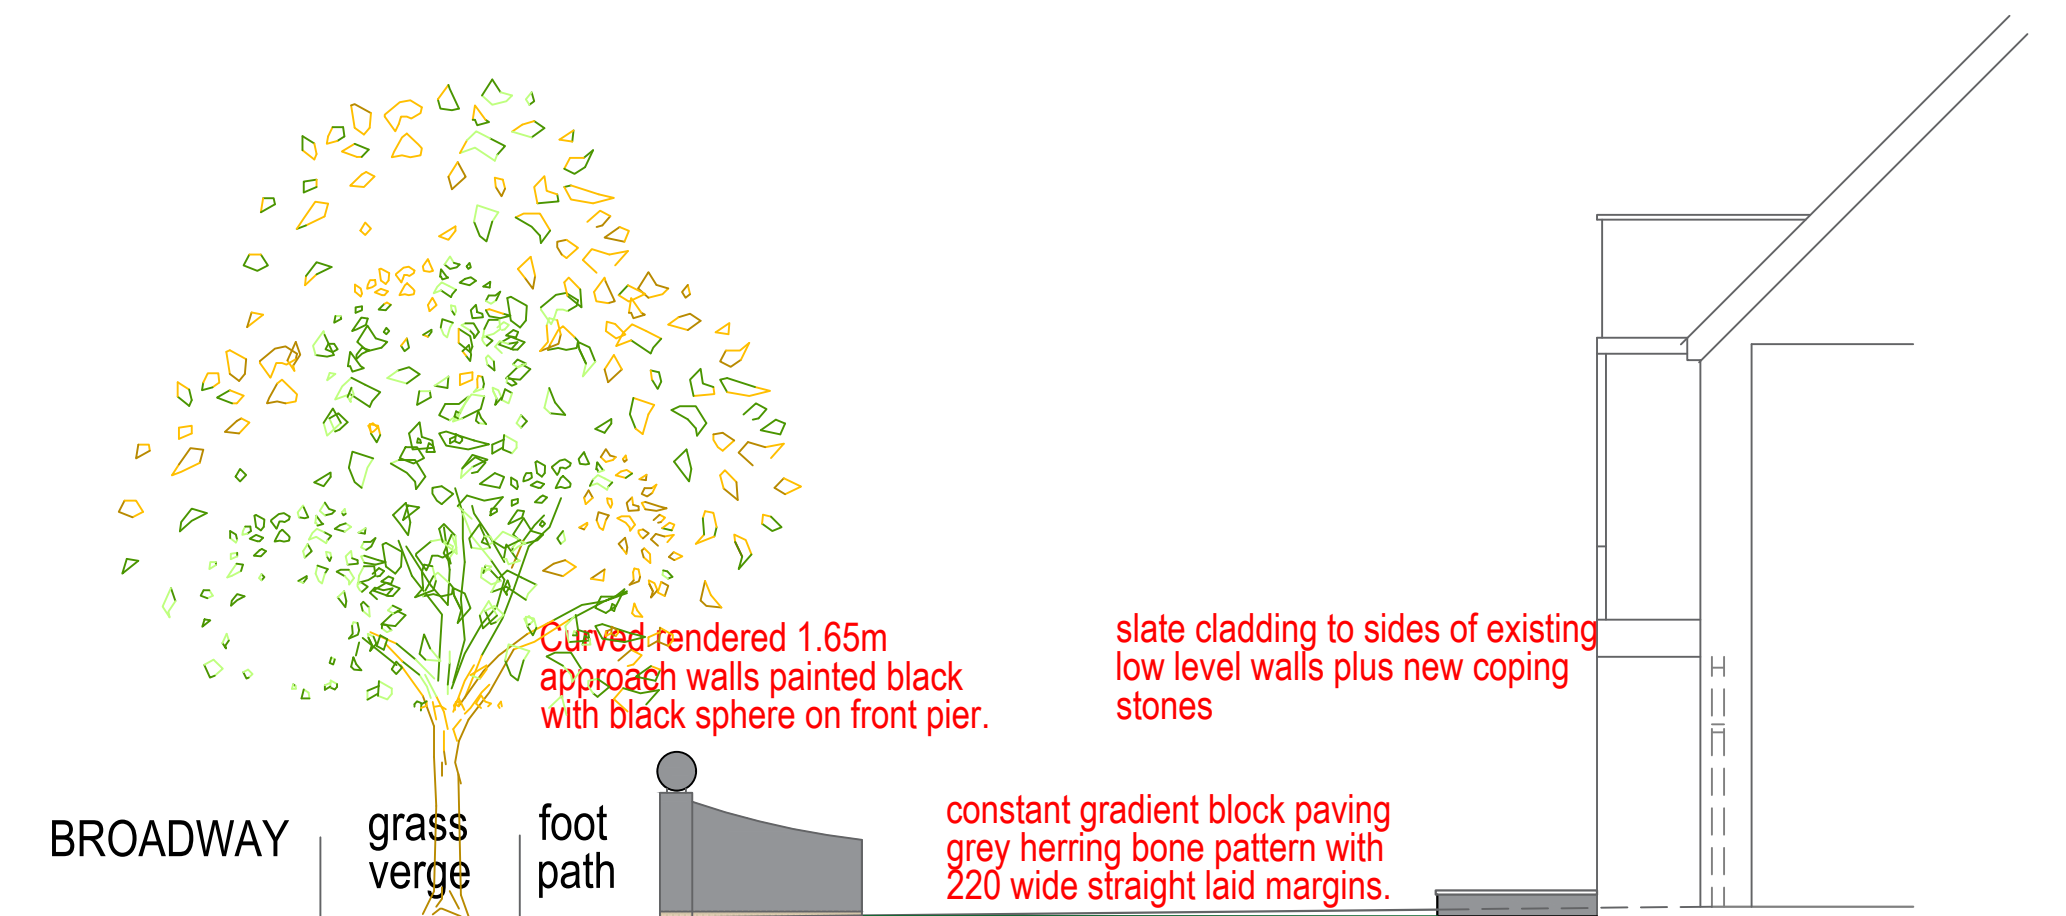


As-Built side elevation (1:100 scale)


Illuminated signage
over entrance door
2.42m long x 0.6m deep

24V LED with max 300 lux output
Acrylic black vinyl with
silver brushed vinyl letters


Illuminated signage
over entrance door
2.42m long x 0.6m deep

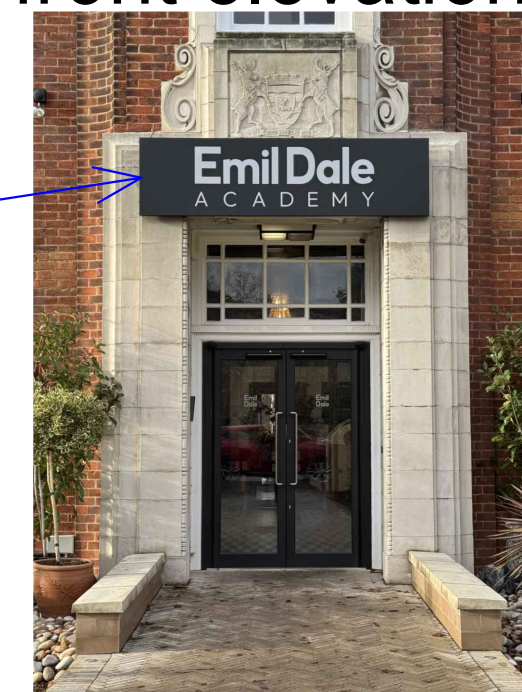

1:100 -0 4m 8m 10m 12m
TO SCALE @ SHEET SIZE A1

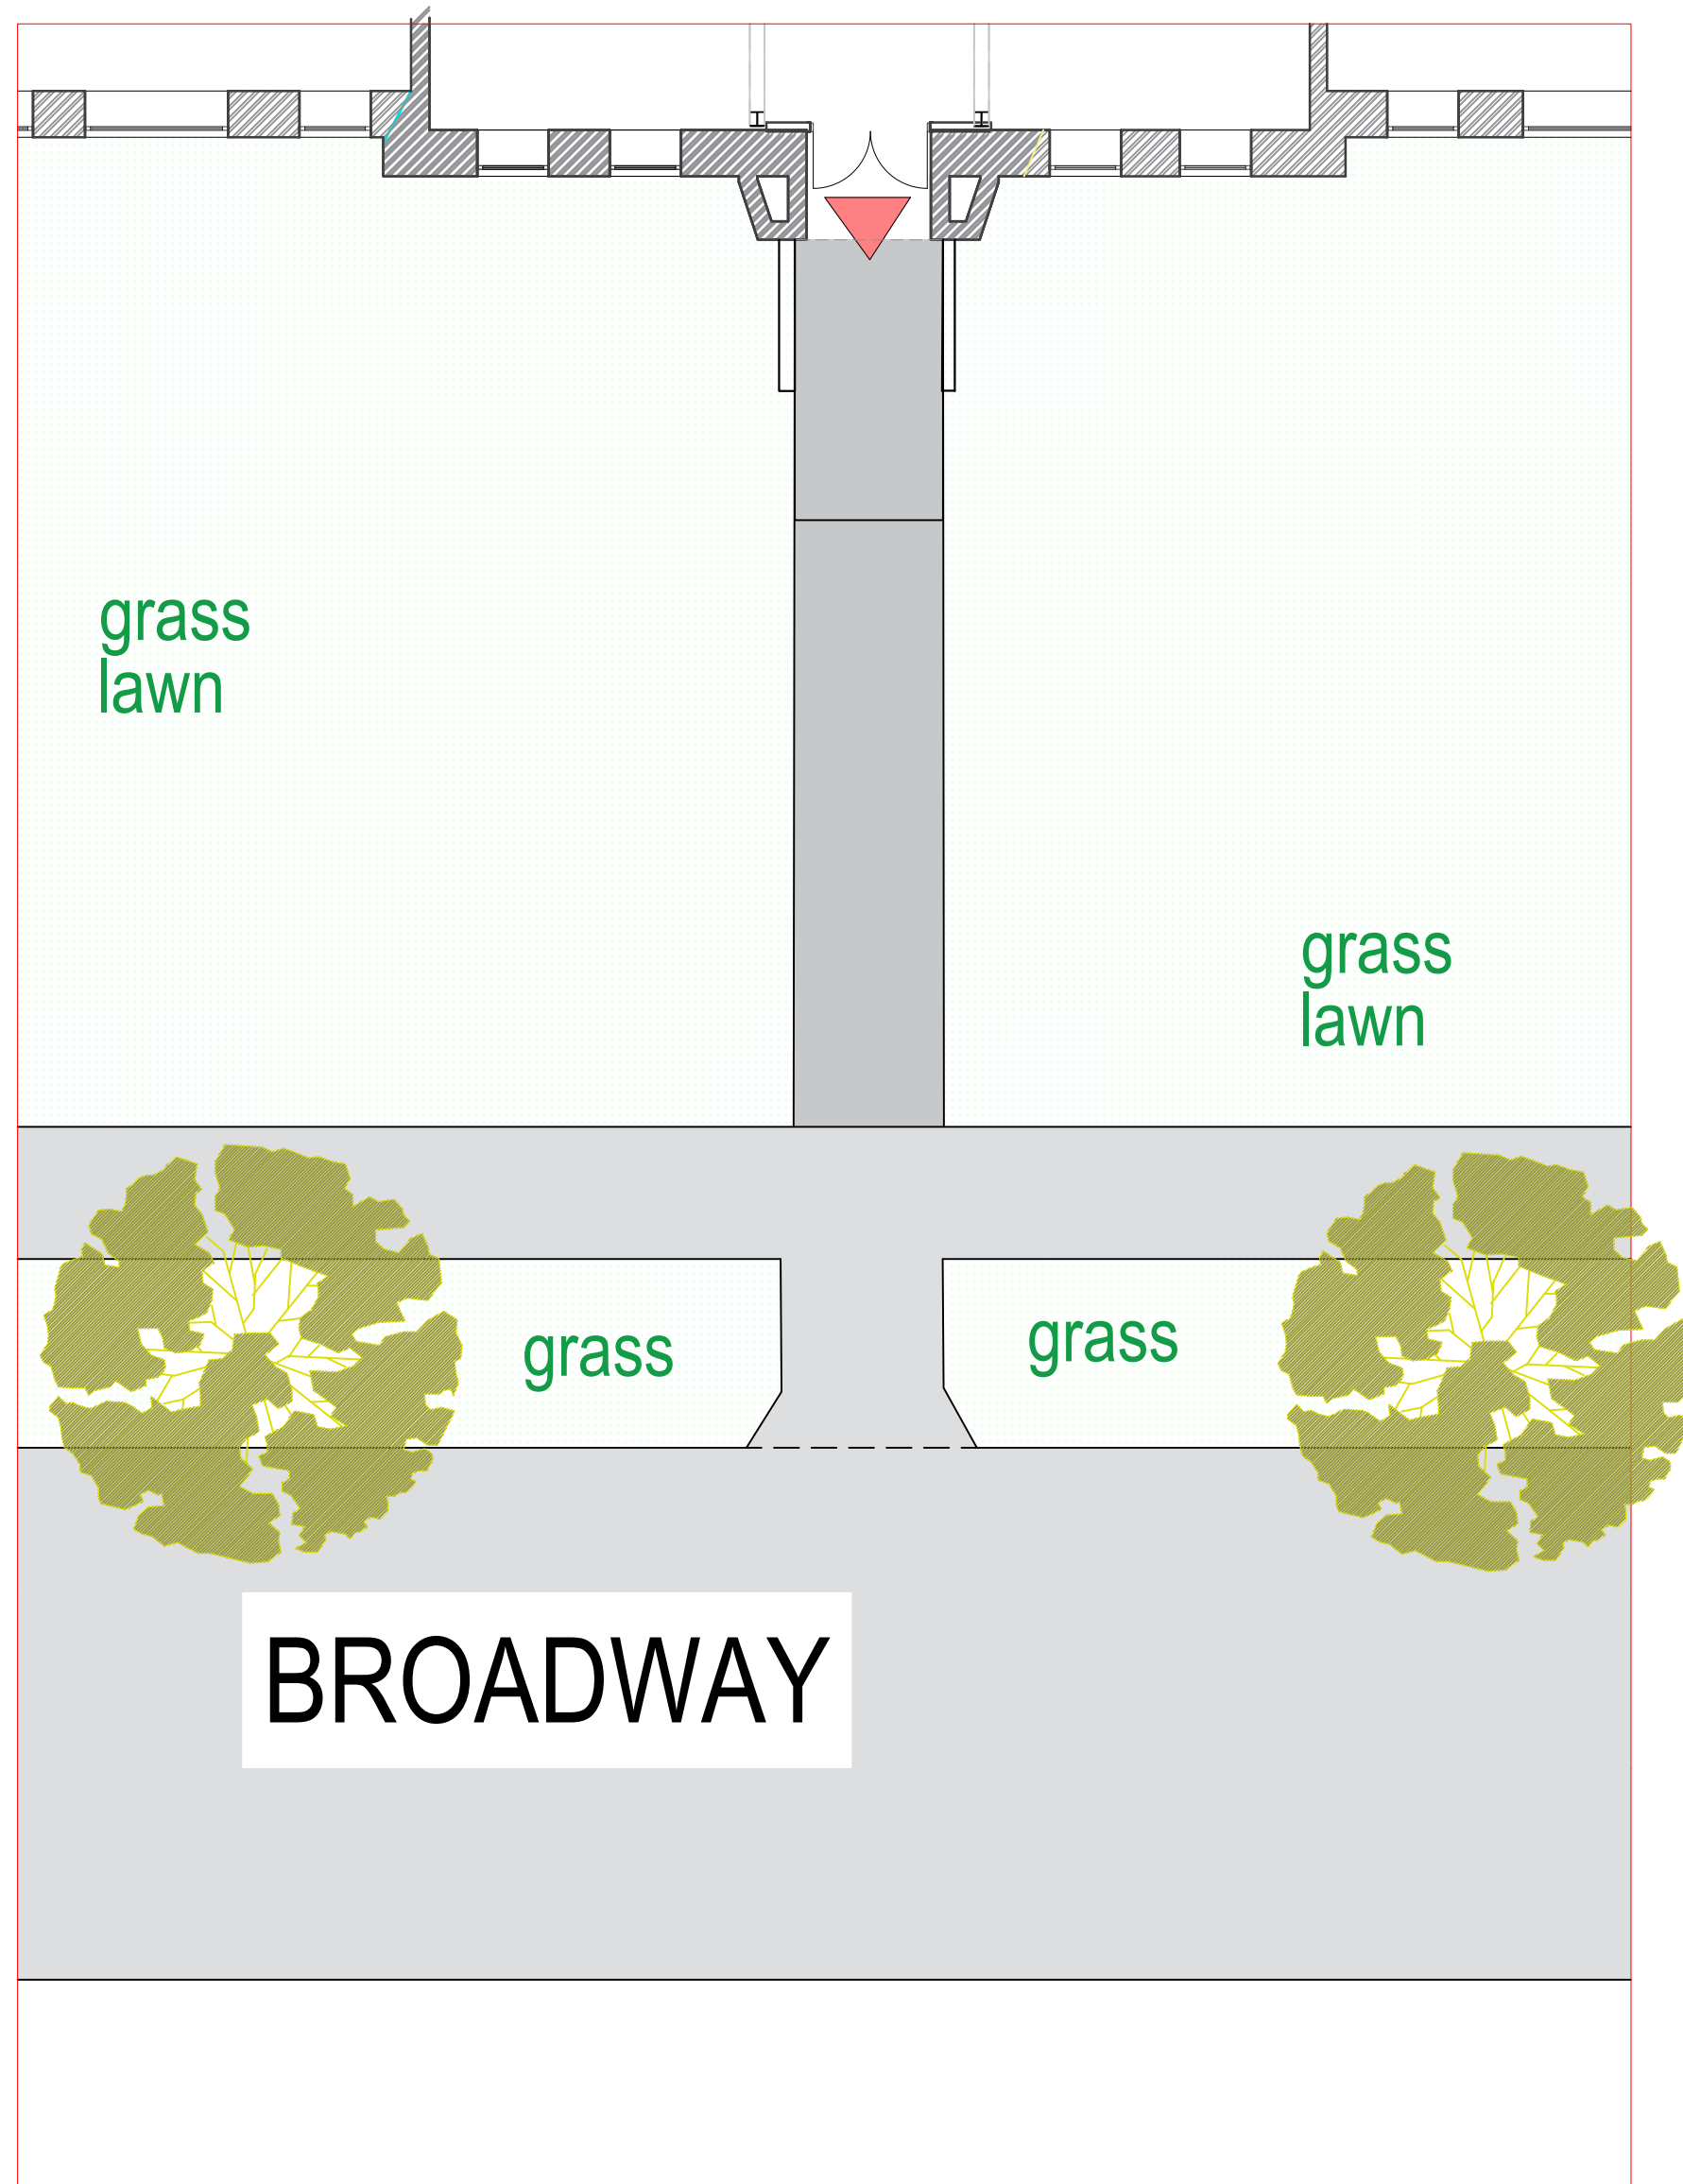

Pre-existing plan (1:100 scale)

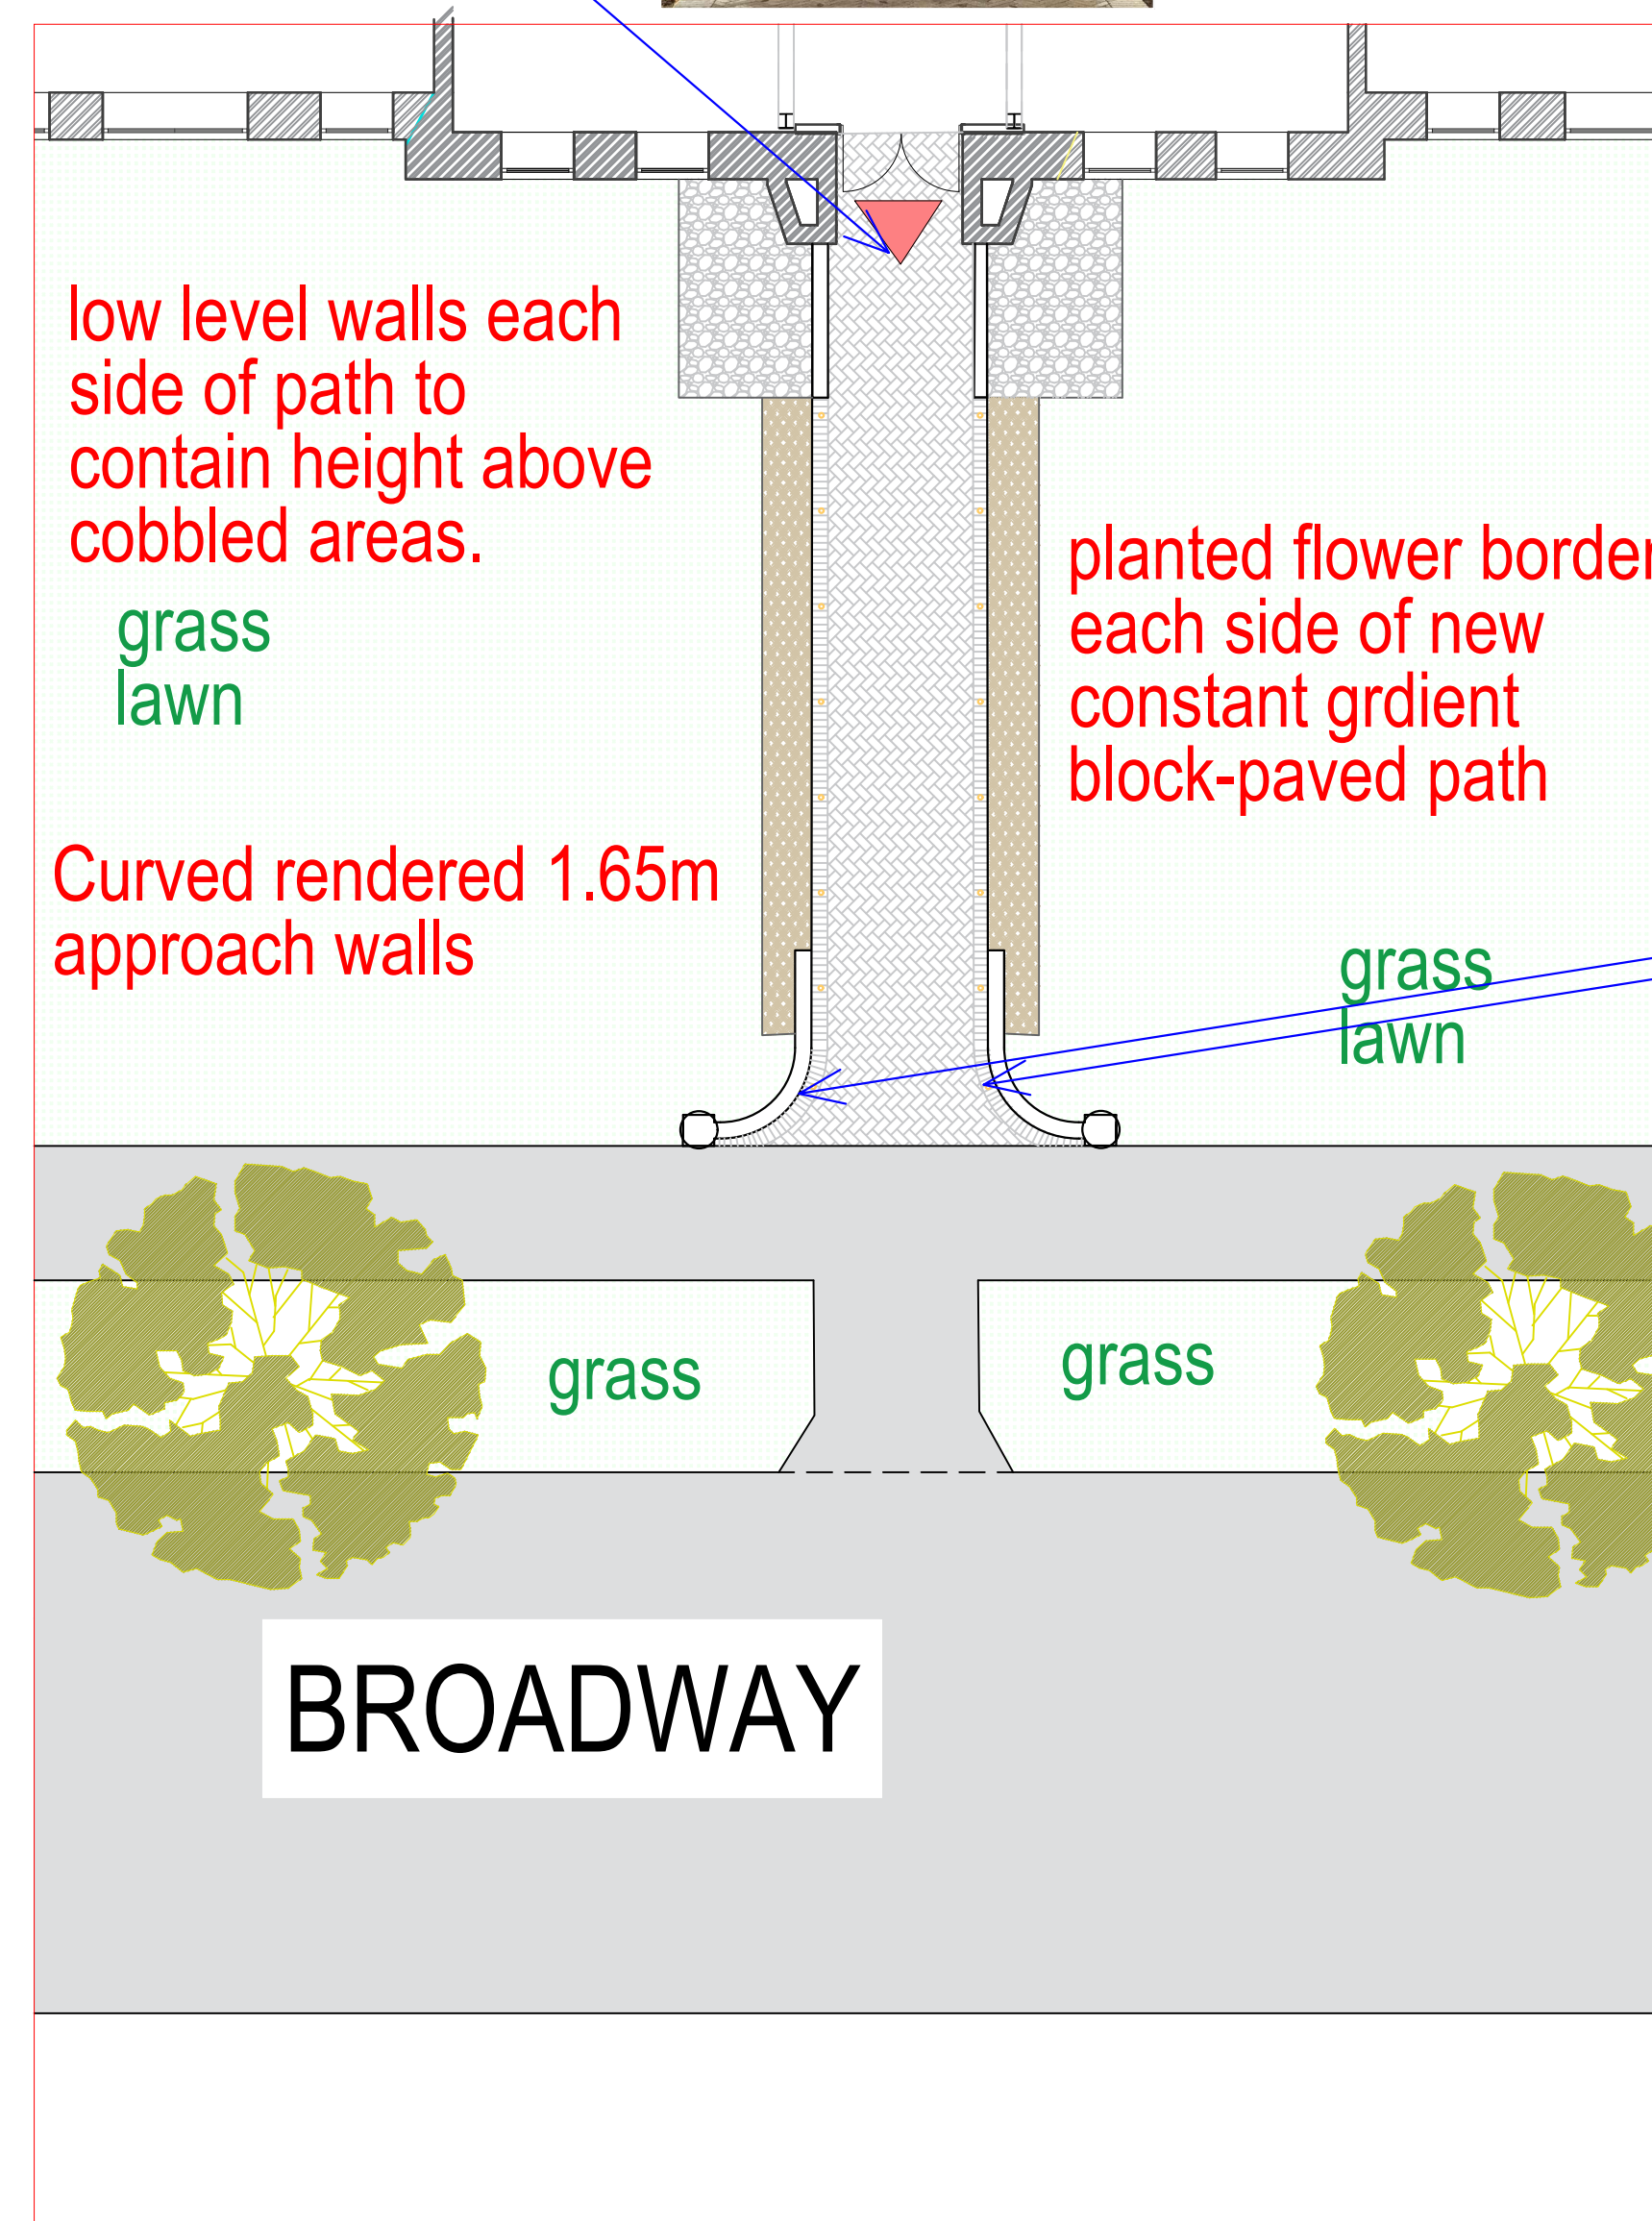

As-Built plan (1:100 scale)



Facia signage to
curved garden walls
195mm height letters
two words per curved wall
each word approx 450mm long

REVISION	DESCRIPTION	DATE	
October 2024	CLIENT/PROJECT Emil-Dale School of Performing Arts Ltd. Old Grammar School, Letchworth.		B&A Burton & Associates Ltd. 65 Shefford Road Clifton Beds. SG17 5RQ Tel. / Fax. 01462 850050
DRAWING STATUS As Built Retrospective Application.	DRAWING TITLE New walls and path to front entrance.		Ref:6796-1 102B
NO UNAUTHORISED PRINTING OR DIGITAL SCANNING ALLOWED © COPYRIGHT 2025			