




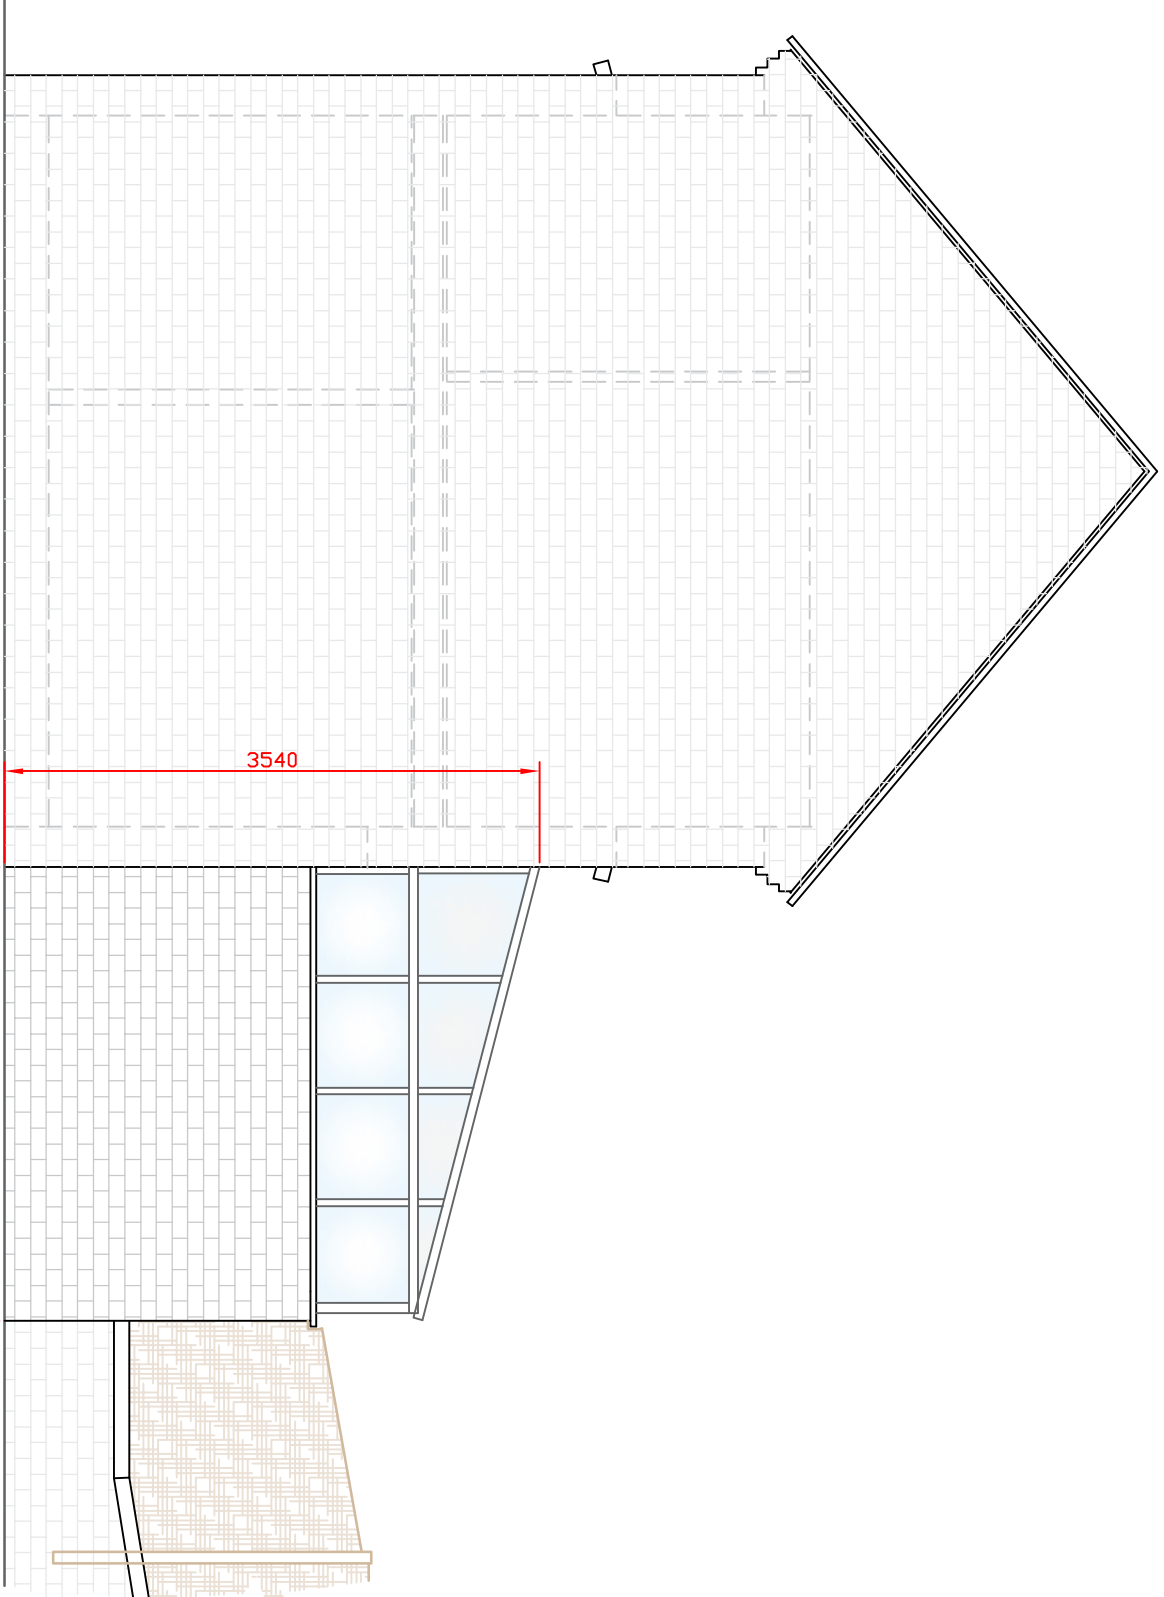

As-built PROPOSED SIDE ELEVATION
1:50 scale

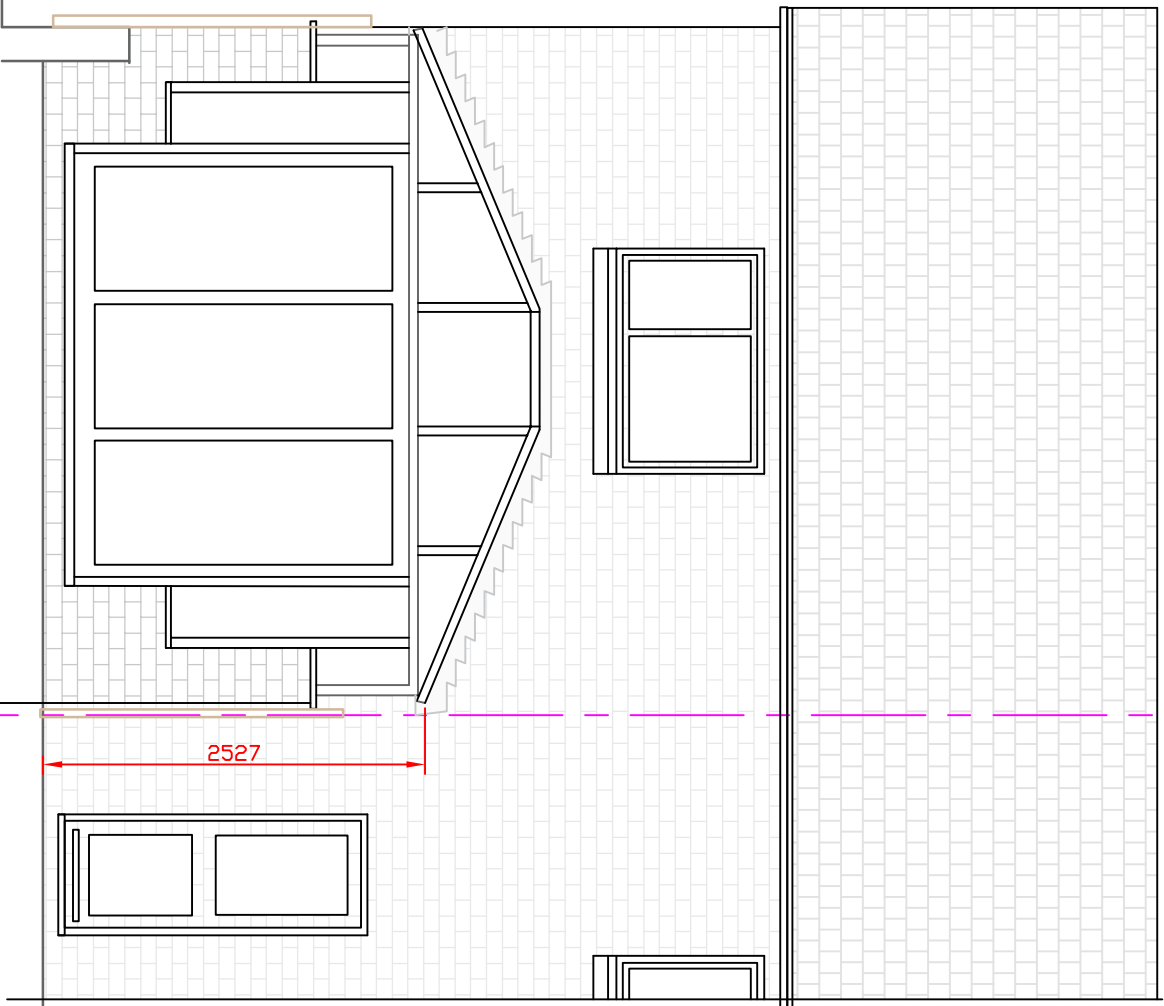



As-built PROPOSED REAR ELEVATION
1:50 scale

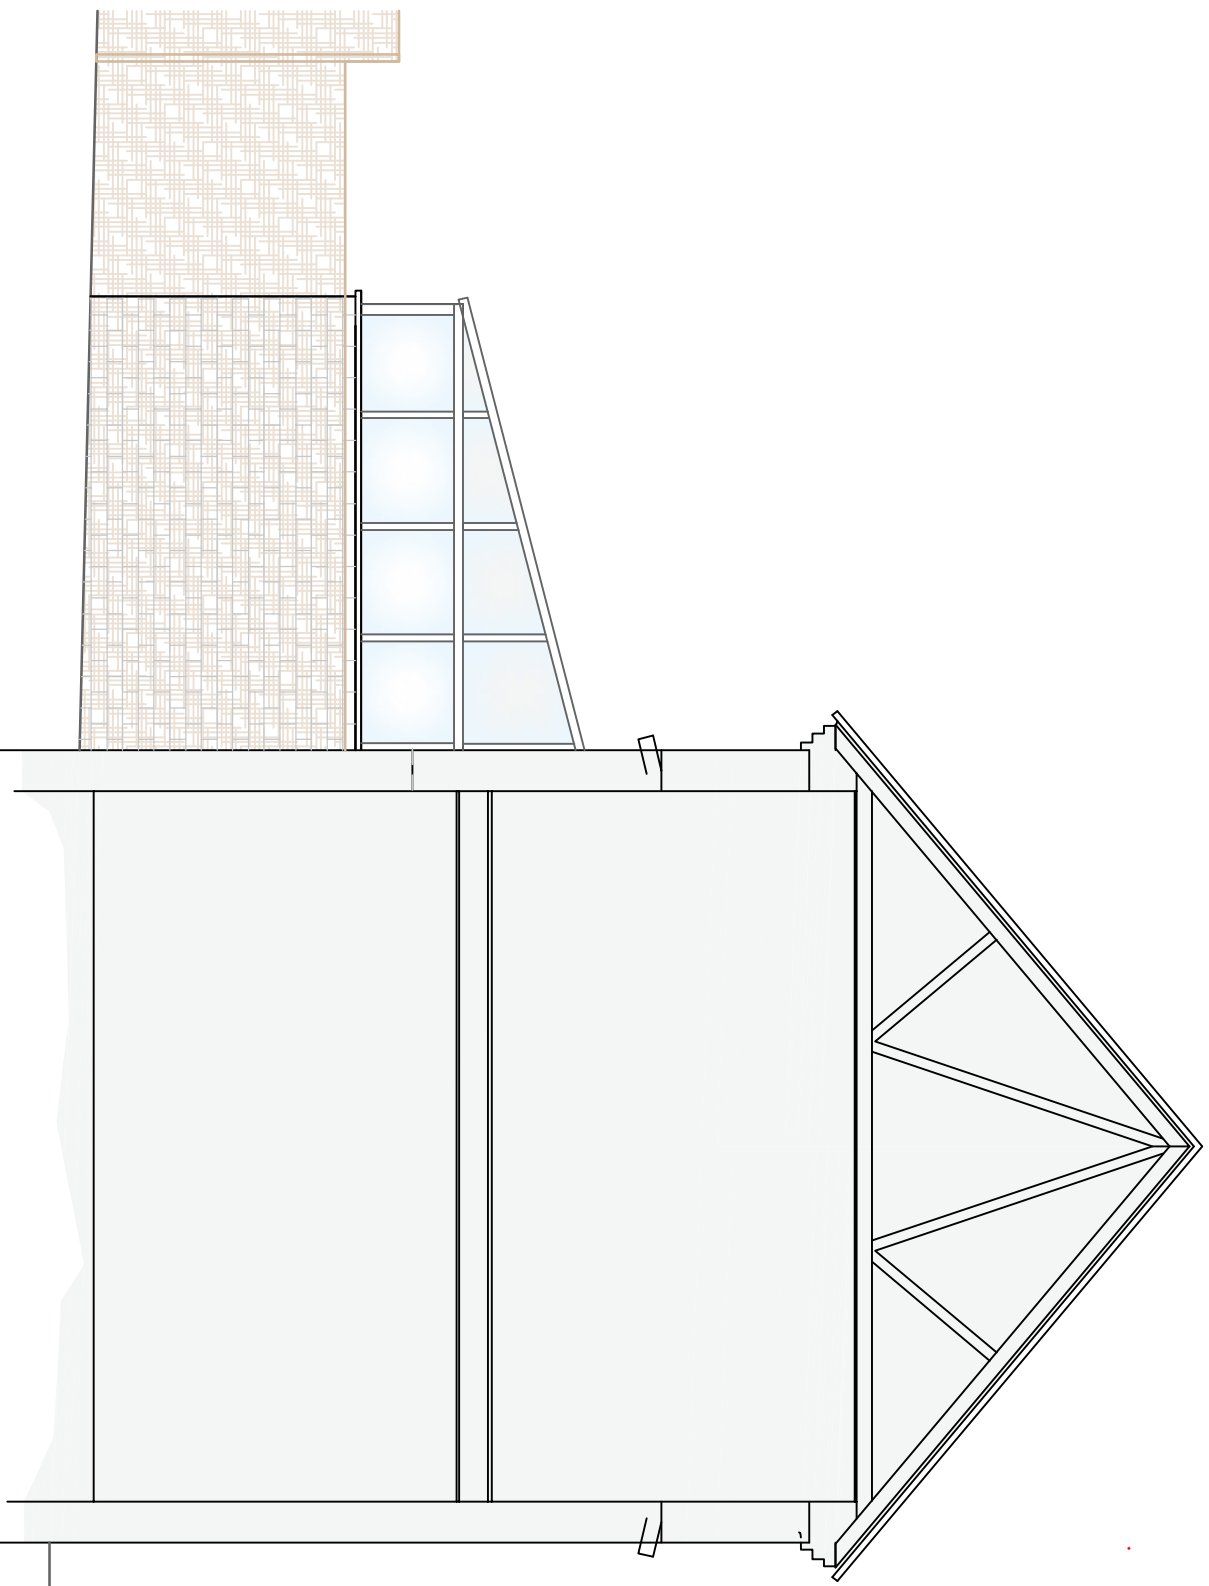


As-built PROPOSED SIDE ELEVATION
1:50 scale





As-built rear & side photos

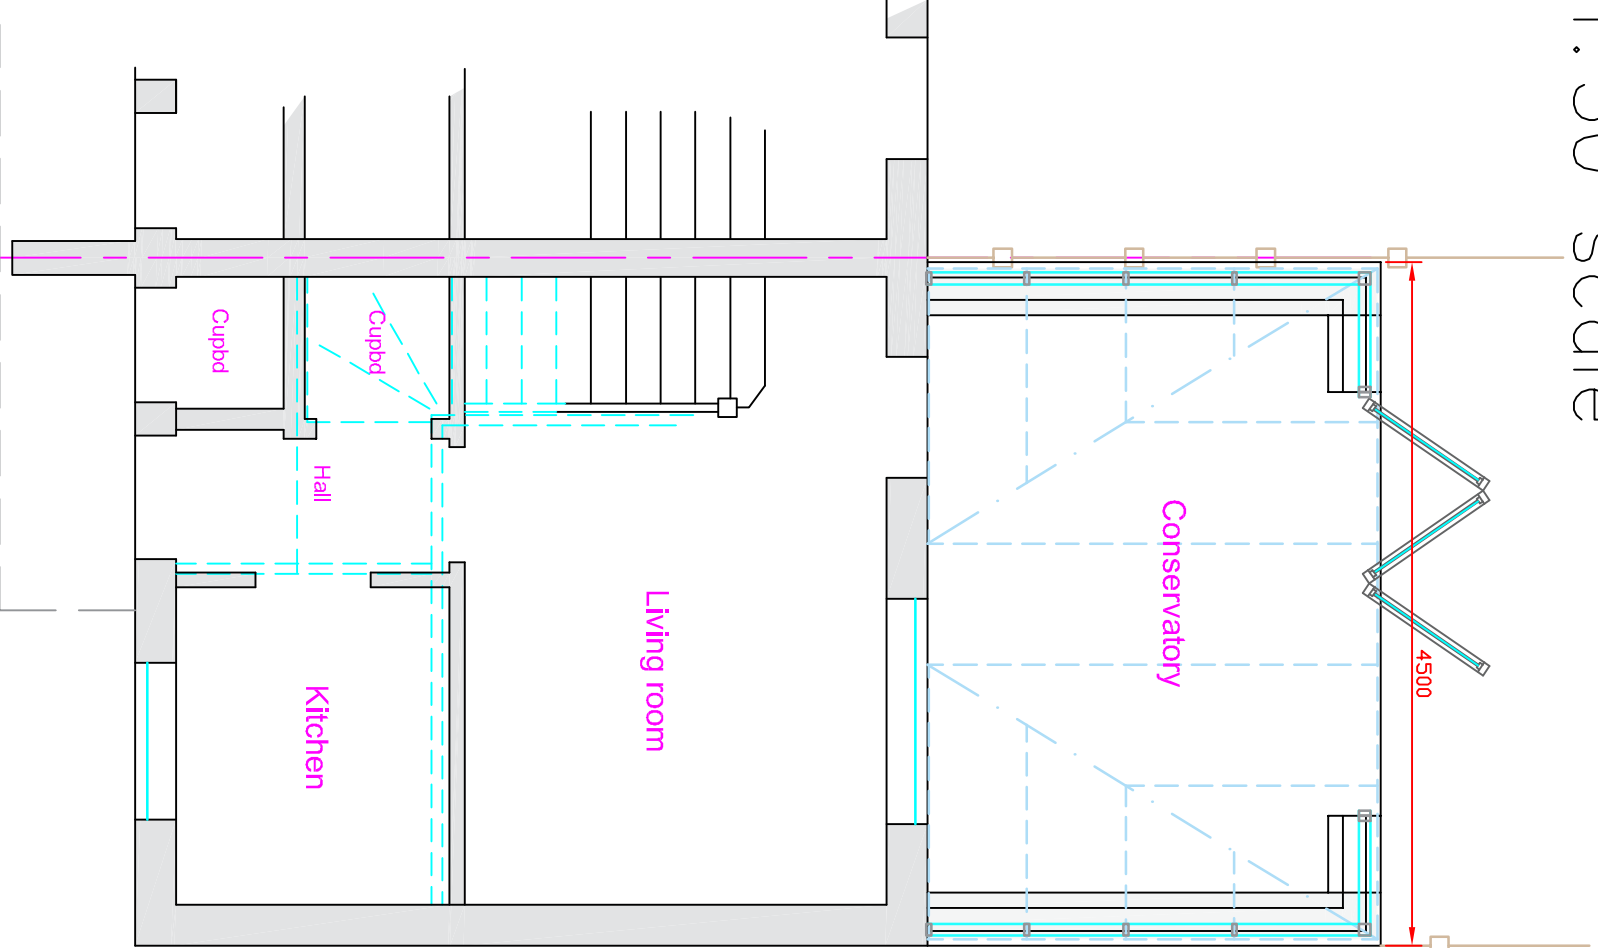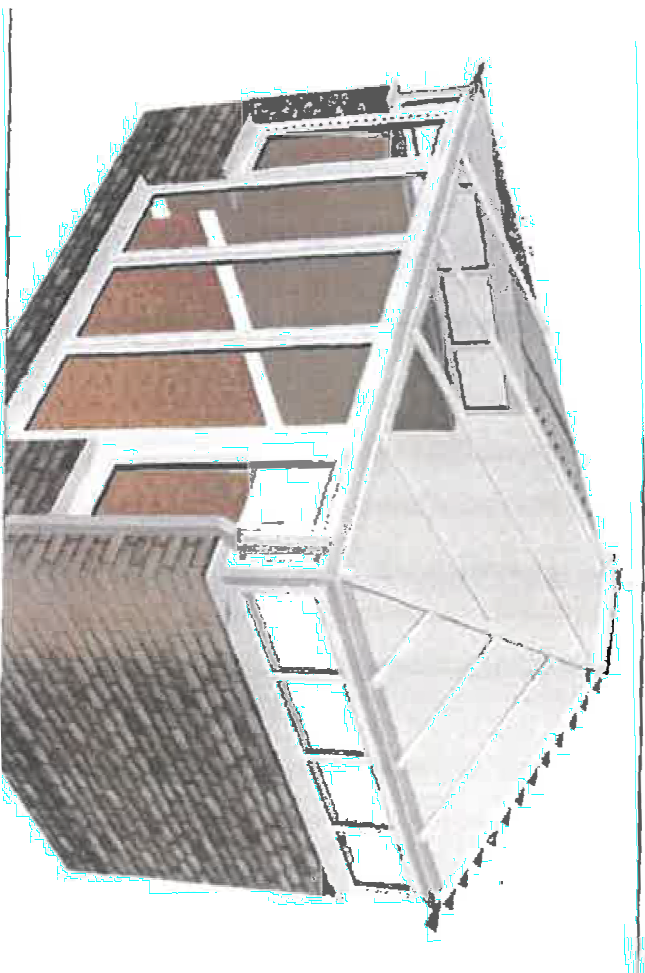


As-built GROUND FLOOR
1:50 scale

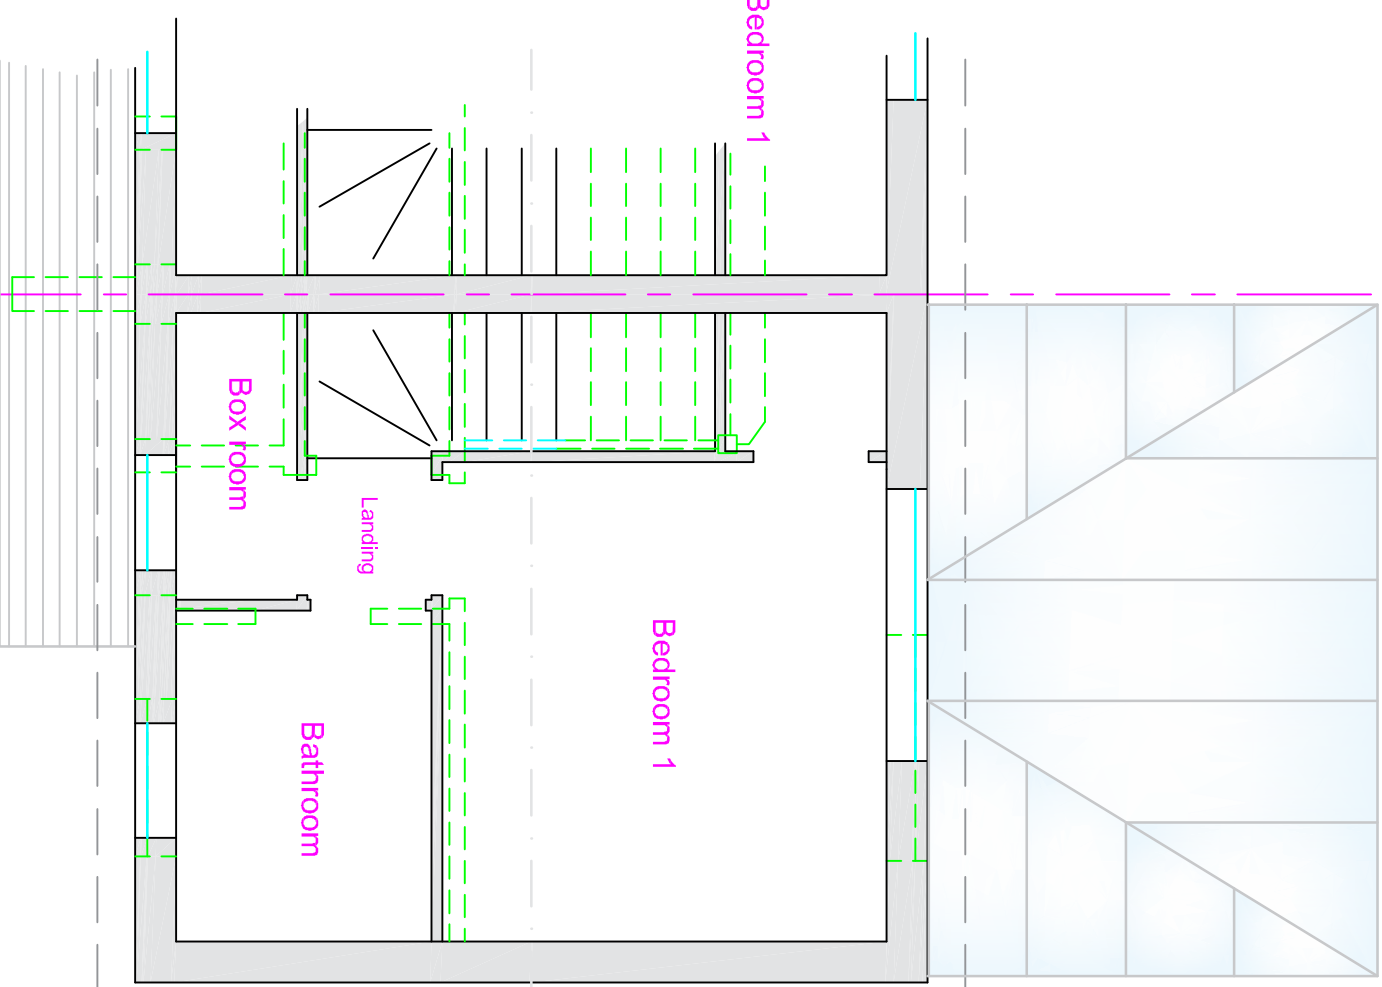


As-built FIRST FLOOR
1:50 scale

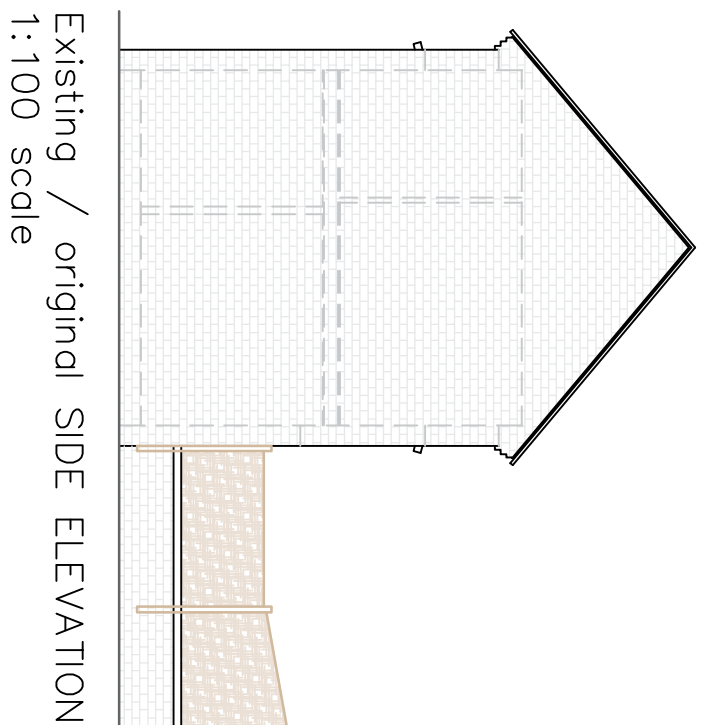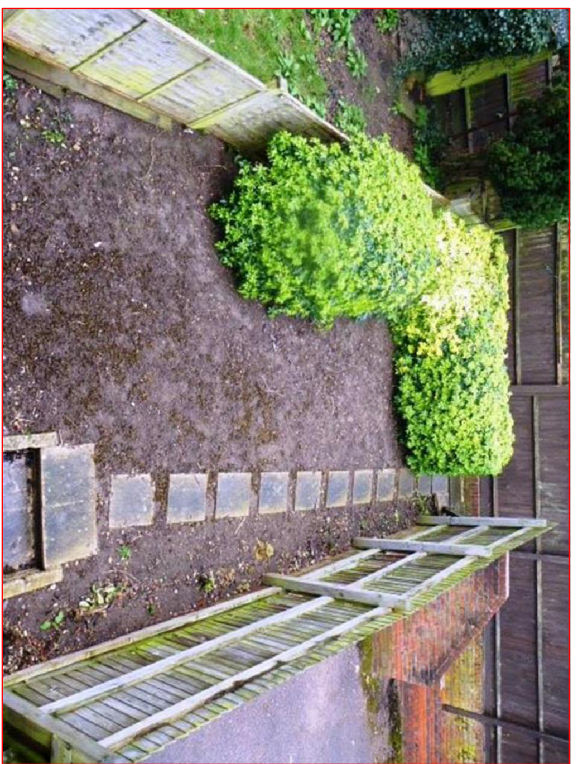


Existing / original SIDE ELEVATION
1:100 scale

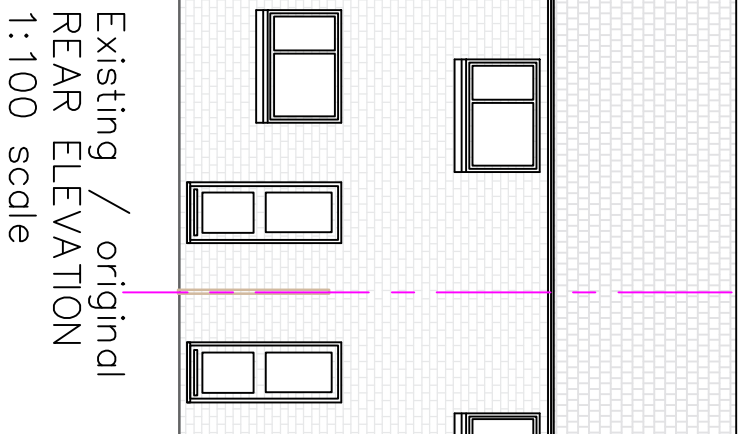


Existing / original REAR ELEVATION
1:100 scale

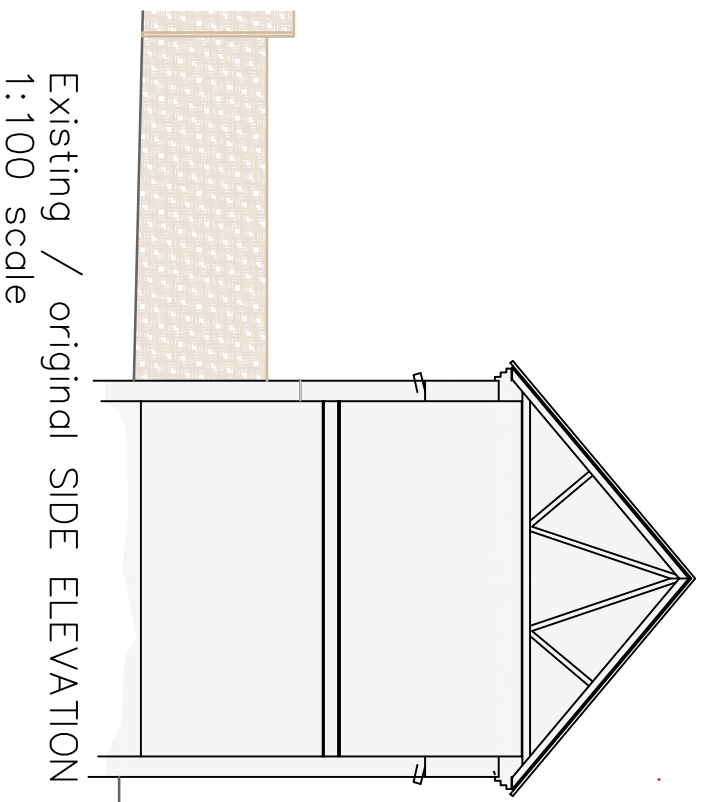


Existing / original SIDE ELEVATION
1:100 scale

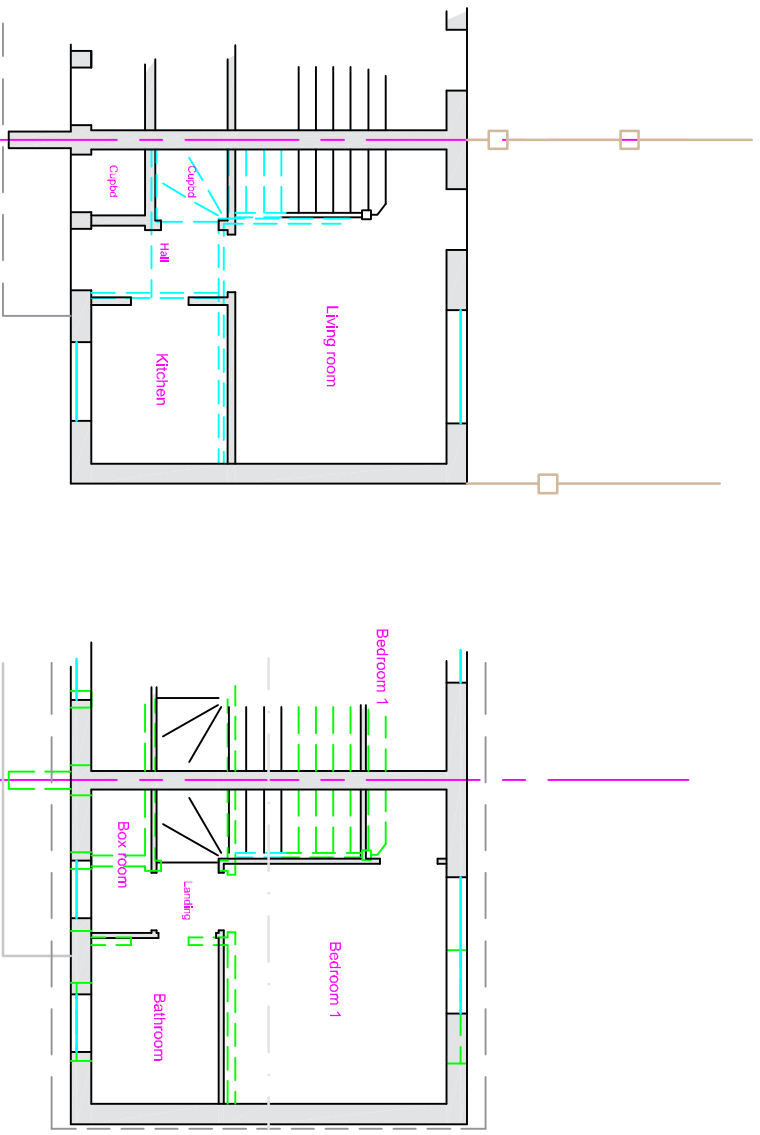



Existing / original GROUND FLOOR 1:100 scale

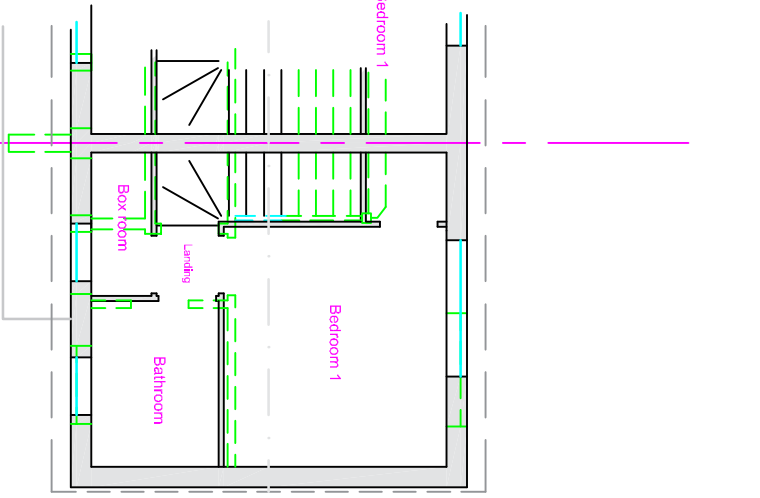

Existing / original FIRST FLOOR 1:100 scale

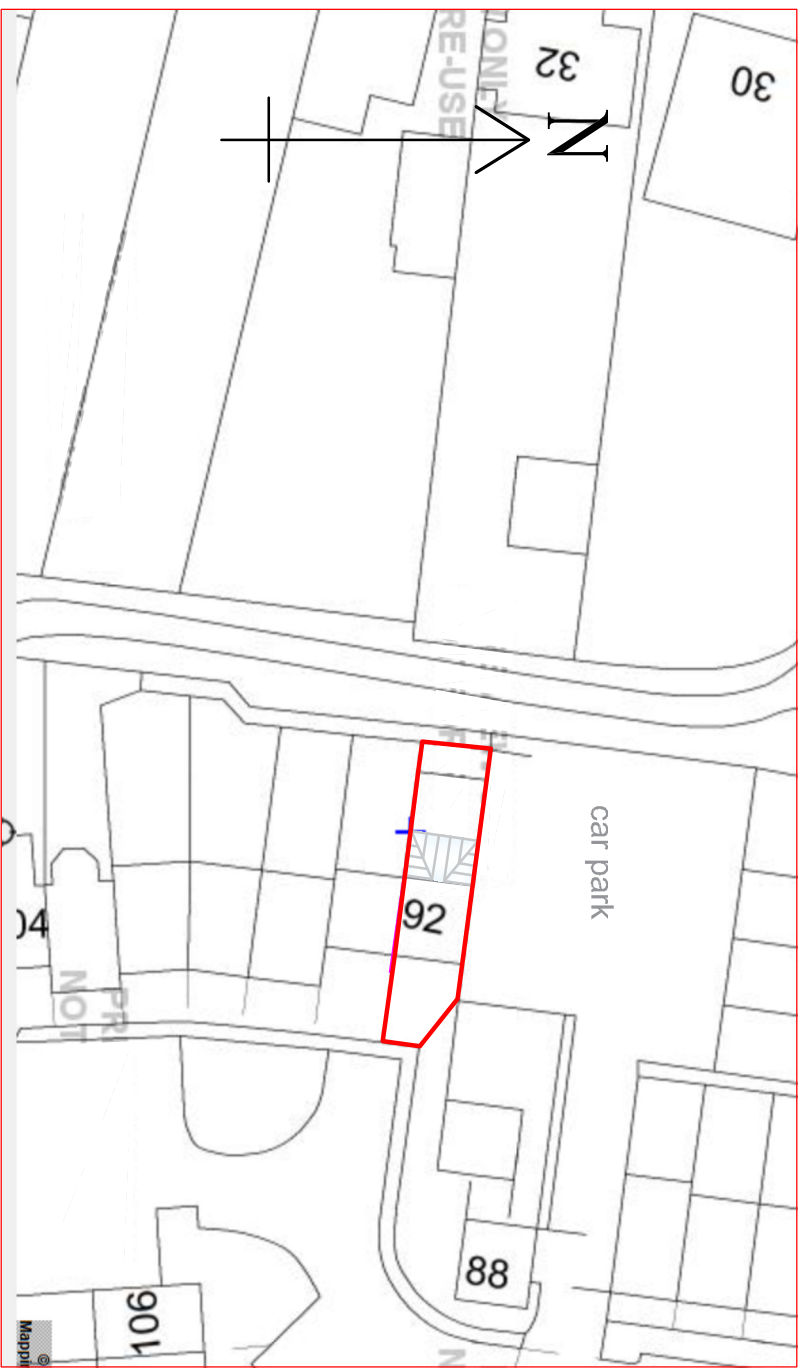

SITE PLAN 1:500 scale

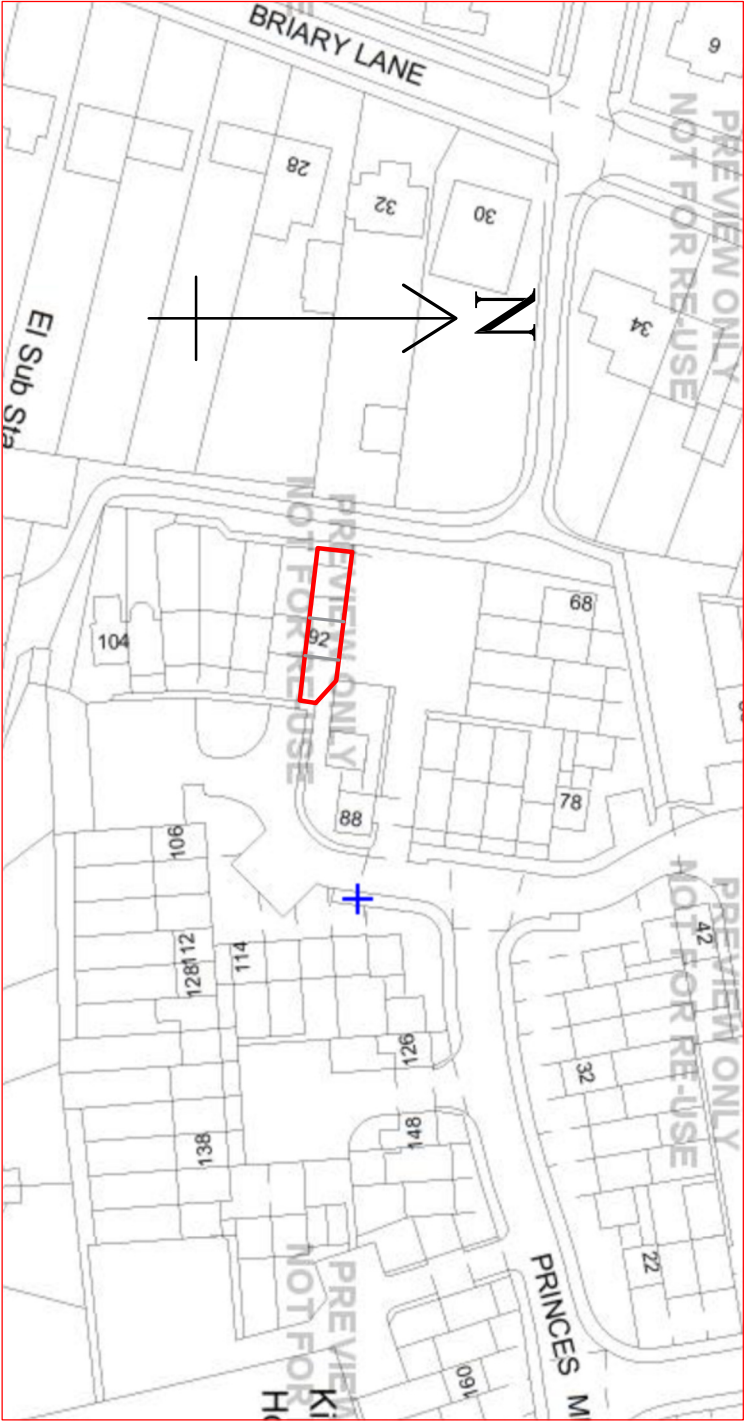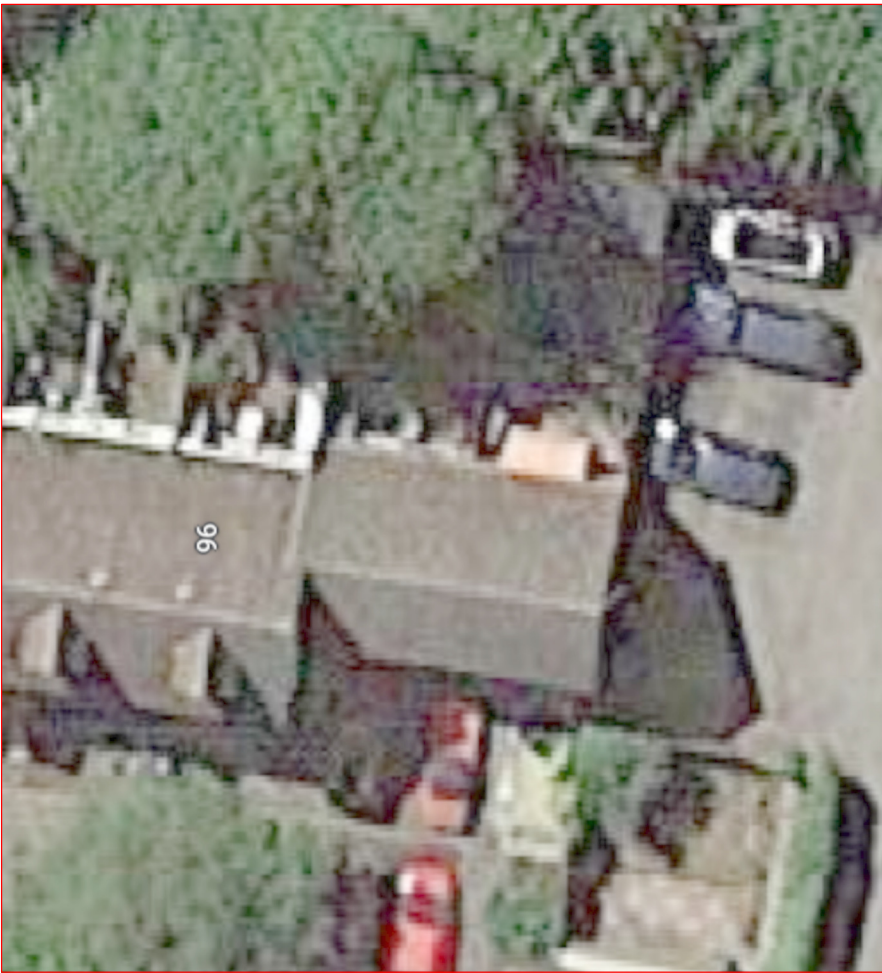

LOCATION PLAN 1:1250 scale

REVISION	DESCRIPTION	DATE
DATE	March 2025	CLIENT/PROJECT
SCALE	1:50 & 1:10	Mr. Lill
DRAWING STATUS	As-Built.	92 Princess Mews, Royston, Herts.
NO UNAUTHORISED PRINTING OR DIGITAL SCANNING ALLOWED © COPYRIGHT 2005	DRAWING TITLE	Rear extension.
	Existing and As-built plans, Location plan and site plan.	
	Ref:0916-1	01