


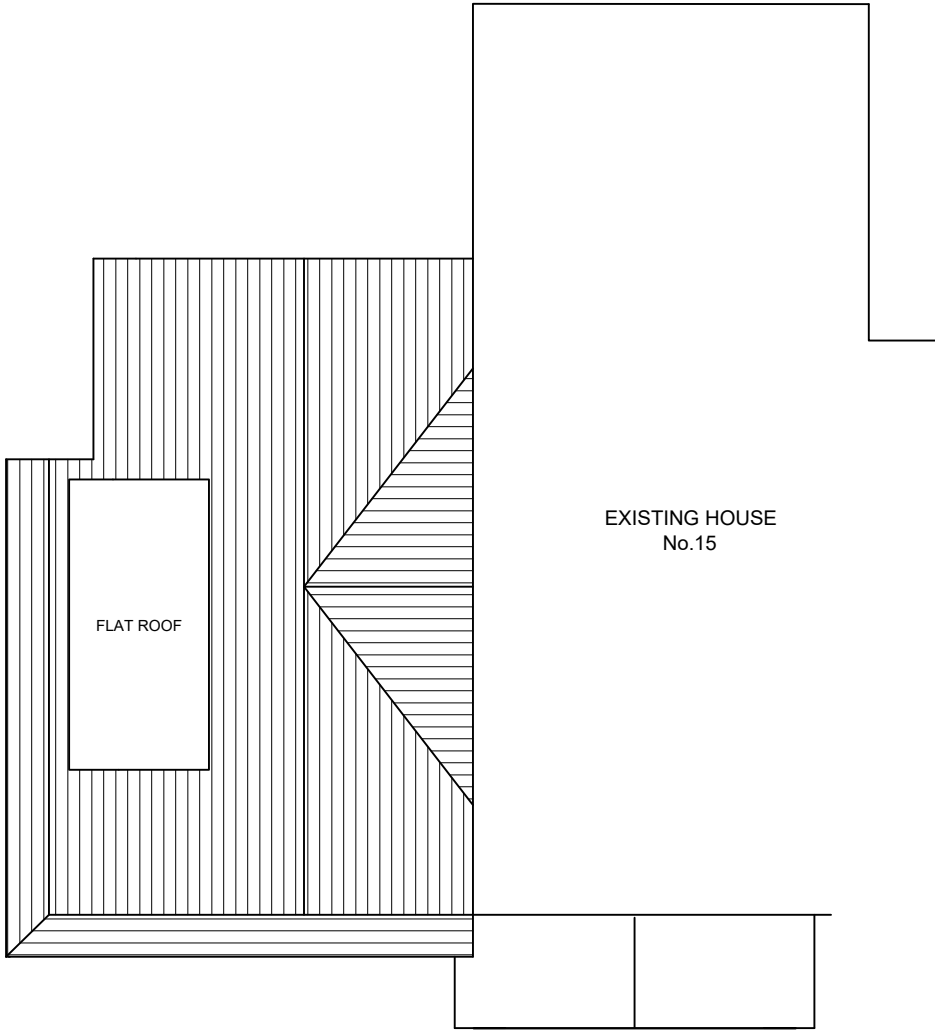

EXISTING ROOF PLAN

0123 Scale bar 1:50 0123456 Scale bar 1:100 Note ALL DIMENSIONS TO BE CHECKED AND VERIFIED ON SITE BEFORE CONSTRUCTION PHASE. DO NOT SCALE FROM THIS DRAWING. ANY AREAS INDICATED ON THIS DRAWING ARE FOR GUIDANCE ONLY AND NO RESPONSIBILITY IS TAKEN FOR THEIR ACCURACY.	Client	Job Title RETENTION OF AS BUILT NEW DWELLING FOLLOWING PREVIOUS APPROVAL FOR AN ANNEX AT: 15 THE CRESCENT, HITCHIN, SG4 7RE	Scale 1:100
	Drawing Title EXISTING ROOF PLAN		Date NOVEMBER 2025
			Drawing No. 15/TC/04