


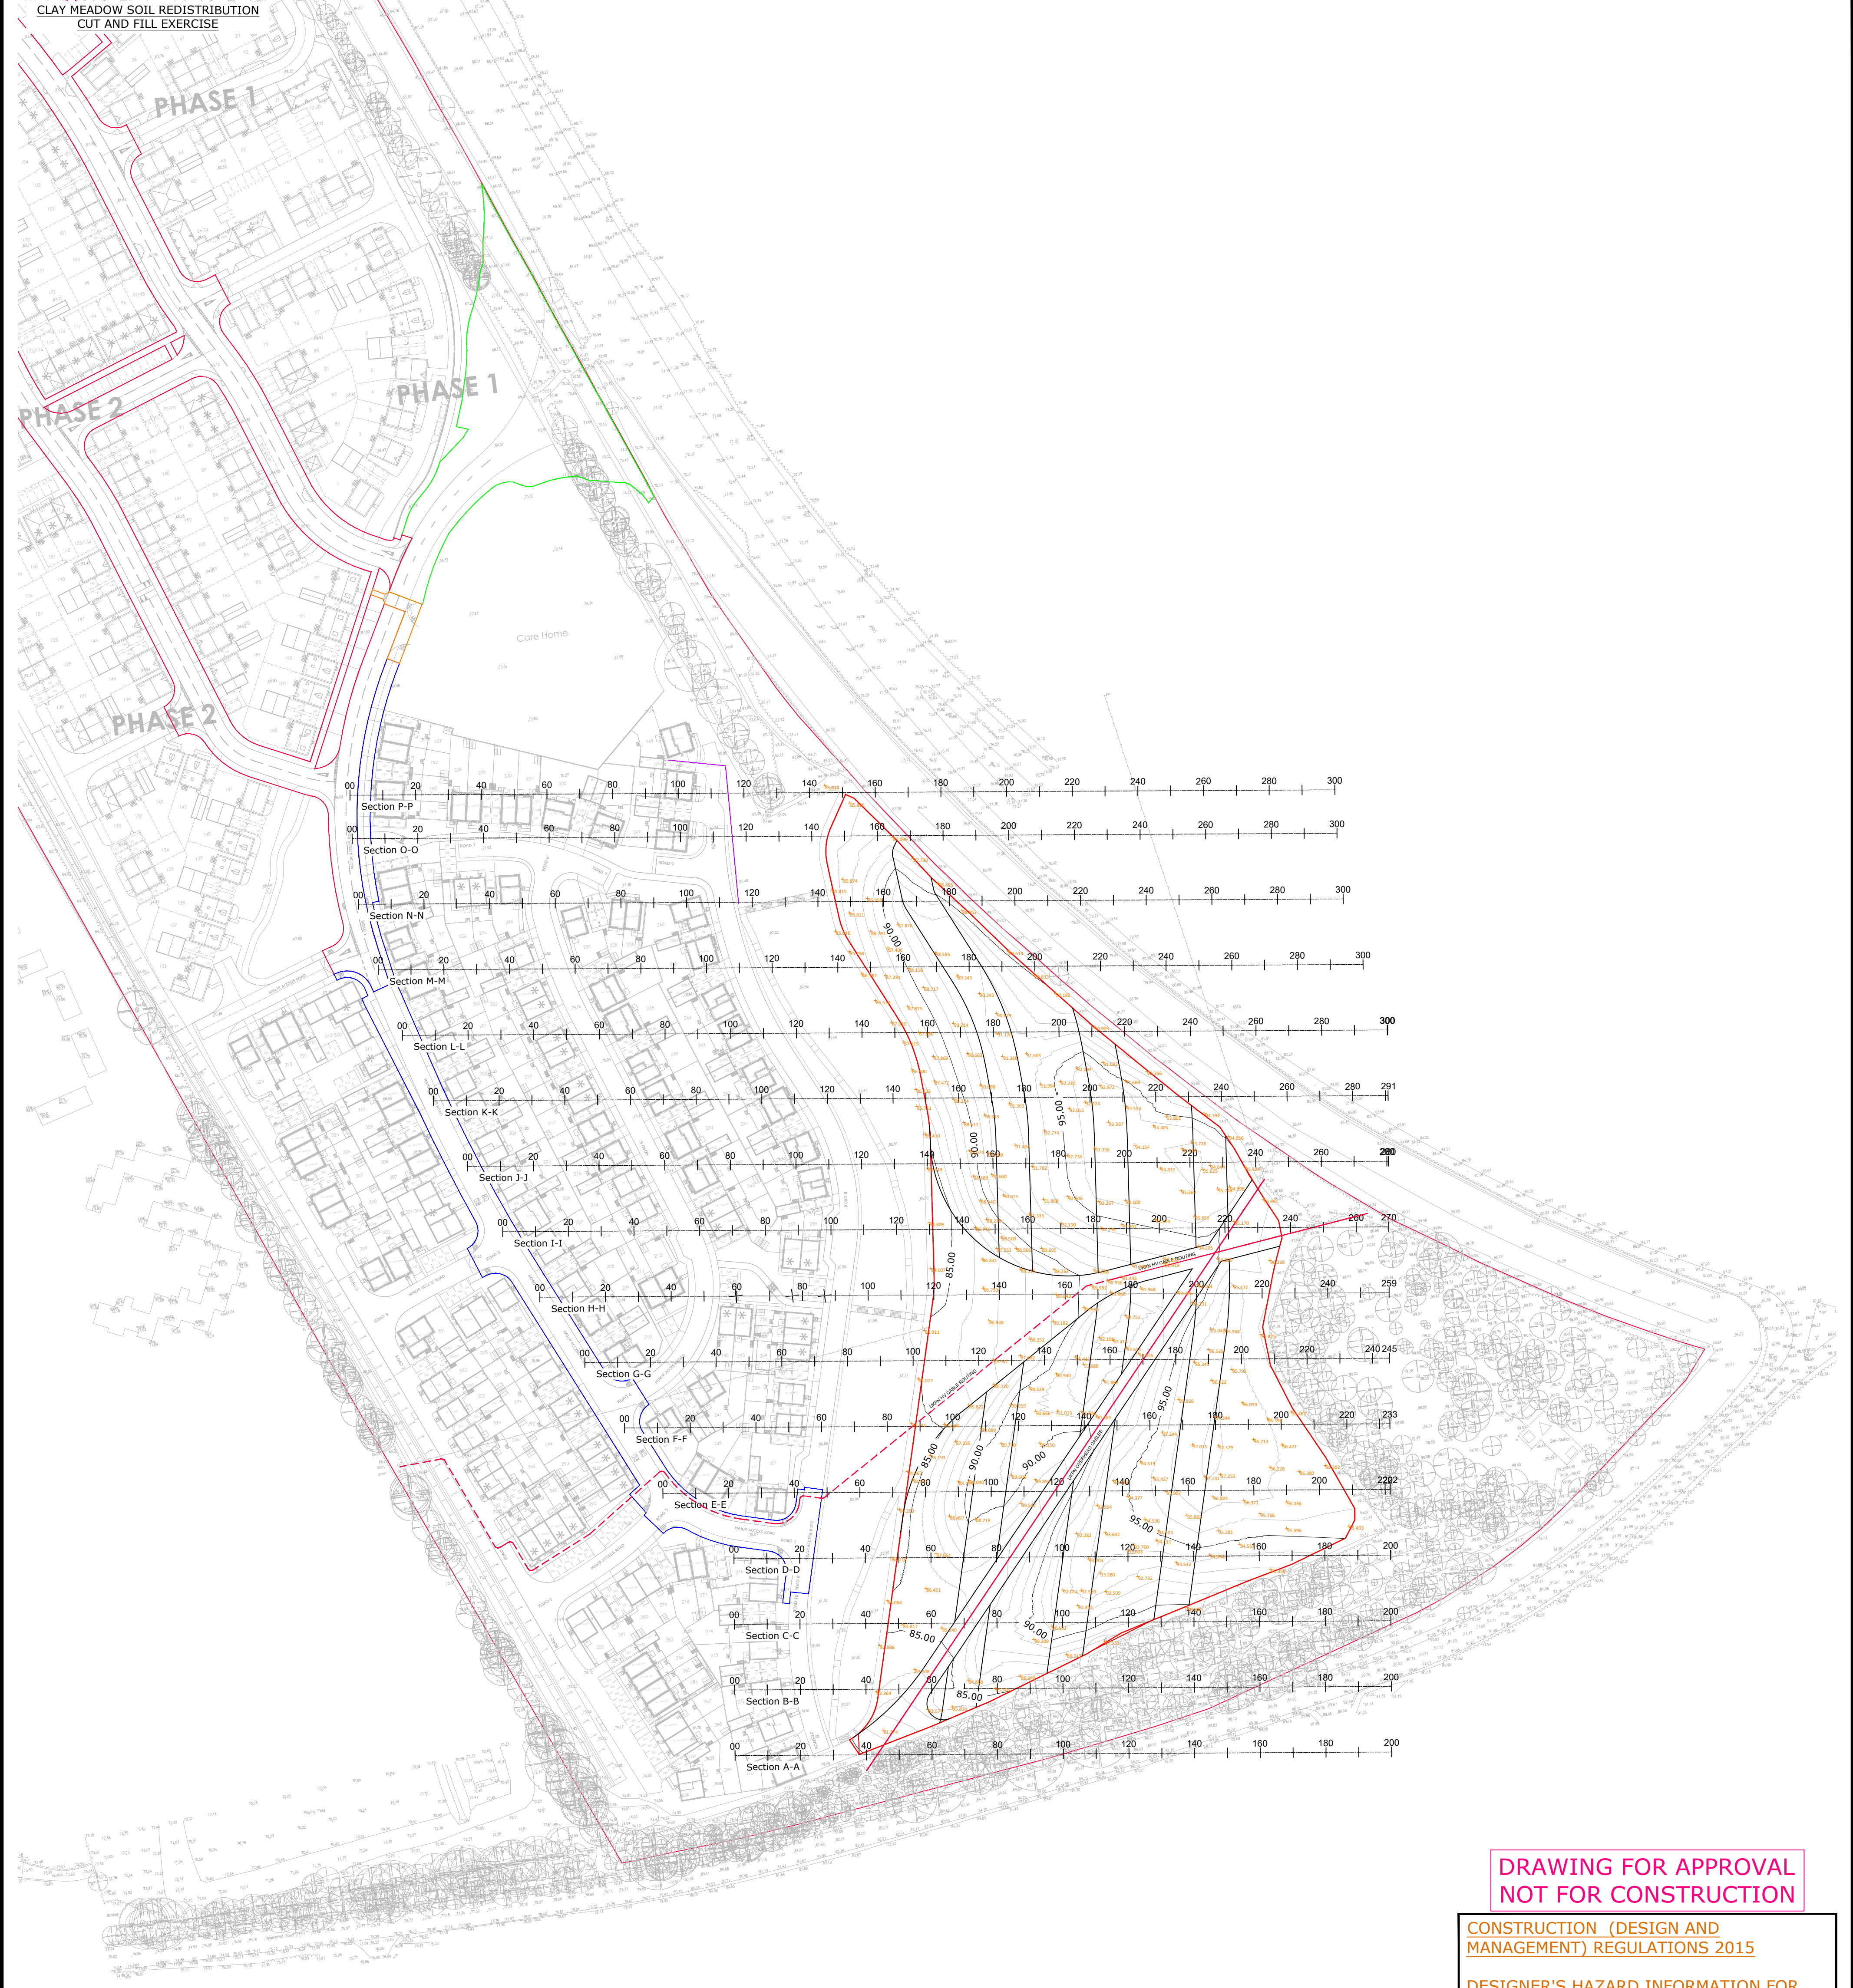

DRAWING FOR APPROVAL
NOT FOR CONSTRUCTION

CONSTRUCTION (DESIGN AND
MANAGEMENT) REGULATIONS 2015

DESIGNER'S HAZARD INFORMATION FOR
CONSTRUCTION

- IF YOU DO NOT FULLY UNDERSTAND THE RISKS INVOLVED DURING THE CONSTRUCTION OF THE ITEMS INDICATED ON THIS DRAWING ASK YOUR MANAGER, HEALTH & SAFETY ADVISOR OR A MEMBER OF THE DESIGN TEAM BEFORE PROCEEDING.
 - STRIKING CHARTED AND UNCHARTED BURIED AND OVERHEAD SERVICES.
 - DEEP DRAINAGE EXCAVATIONS. RISK OF FALLS, COLLAPSE OF TRENCH OR BATTER, CONFINED SPACES.
 - CONNECTIONS TO EXISTING LIVE SEWERS/DRAINS. RISK OF DANGEROUS GASES/CONDITIONS/DISEASE.
 - CONFLICT BETWEEN CONSTRUCTION WORKERS, VISITORS AND GENERAL PUBLIC WITH MOVING PLANT AND VEHICLES.
 - WORKS ADJACENT TO AND WITHIN PUBLIC ADOPTED HIGHWAY. CONFLICT BETWEEN CONSTRUCTION WORKERS/ACTIVITIES AND MOVING VEHICLES.
- THE ABOVE NOTES REFER SPECIFICALLY TO THE INFORMATION SHOWN ON THIS DRAWING.
REFER TO THE HEALTH AND SAFETY PLAN FOR FURTHER INFORMATION.

NOTES

- THIS DRAWING IS TO BE READ IN CONJUNCTION WITH ALL RELEVANT ENGINEER'S, ARCHITECT'S AND SPECIALIST'S DRAWINGS AND THE SPECIFICATION.
- DO NOT SCALE FROM THIS DRAWING MANUALLY OR ELECTRONICALLY. WRITTEN PERMISSION MUST BE OBTAINED FROM SWECO PRIOR TO SCALING ELECTRONICALLY OR USING THIS ELECTRONIC FILE.
- SITE LAYOUT BASED ON TREME DESIGN DRG. SITE PLAN - V2 -01.04.22. TOPOGRAPHICAL SURVEY FROM ASC (SURVEYS) LTD DRAWING ASC.17.250, RECEIVED 15/01/18.

KEY

- 1.0m MINOR CONTOUR
- 5.0m MAJOR CONTOUR
- CLAY MEADOW FILL SLOPE EXTENTS
- AS-BUILT RE-GRADING/ STEPPED EMBANKMENT PROFILE LEVELS

P03	10.10.2024	AS-BUILT EMBANKMENT PROFILE ADDED	GJ	RS	TM
P02	10.09.2024	SECTIONS AMENDED	GJ	RS	SP
P01	05.09.2024	FIRST ISSUE	GJ	RS	SP
Rev	Date	Amendment Details	Dr'n	Chk'	App'

This drawing should not be relied on or used in circumstances other than those for which it was originally prepared and for which Sweco UK Limited was commissioned. Sweco UK Limited accepts no responsibility for this drawing to any party other than the person by whom it was commissioned. Any party which breaches the provisions of this disclaimer shall indemnify Sweco UK Limited for all loss or damage arising therefrom.
COPYRIGHT © Sweco 2021

Client

VISTRY HOMES

Project Title

NEWMARKET ROAD, ROYSTON
PHASE 3

Drawing Title

SOIL REDISTRIBUTION CUT &
FILL CONTOUR GA - OPTION 6

Sweco
North Kiln, Felaw Maltings
46 Felaw Street
Ipswich
IP2 8PN
Tel: +44 (0)1473 231 100
Web: www.sweco.co.uk



Purpose Of Issue

PRELIMINARY

Status Description

Status

Designed	Drawn	Checked	Approved
TM	GJ	RS	SP
Sheet Size	Scale	SWECO Ref	Revision
A1	1:1000	66200295	P03

Drawing Number

66200295-SWE-ZZ-XX-D-C-4154