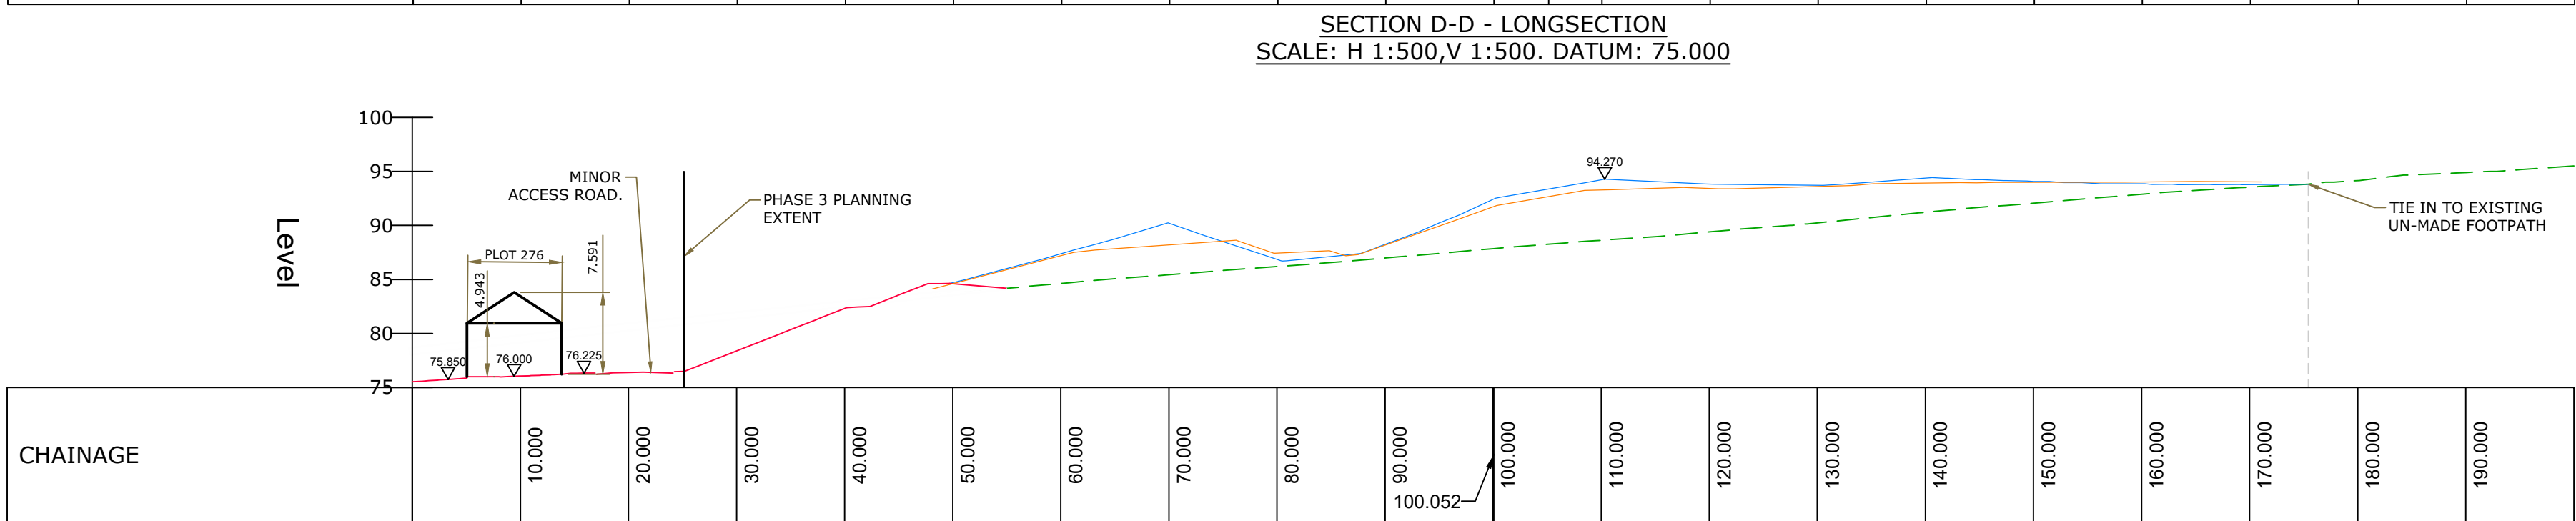
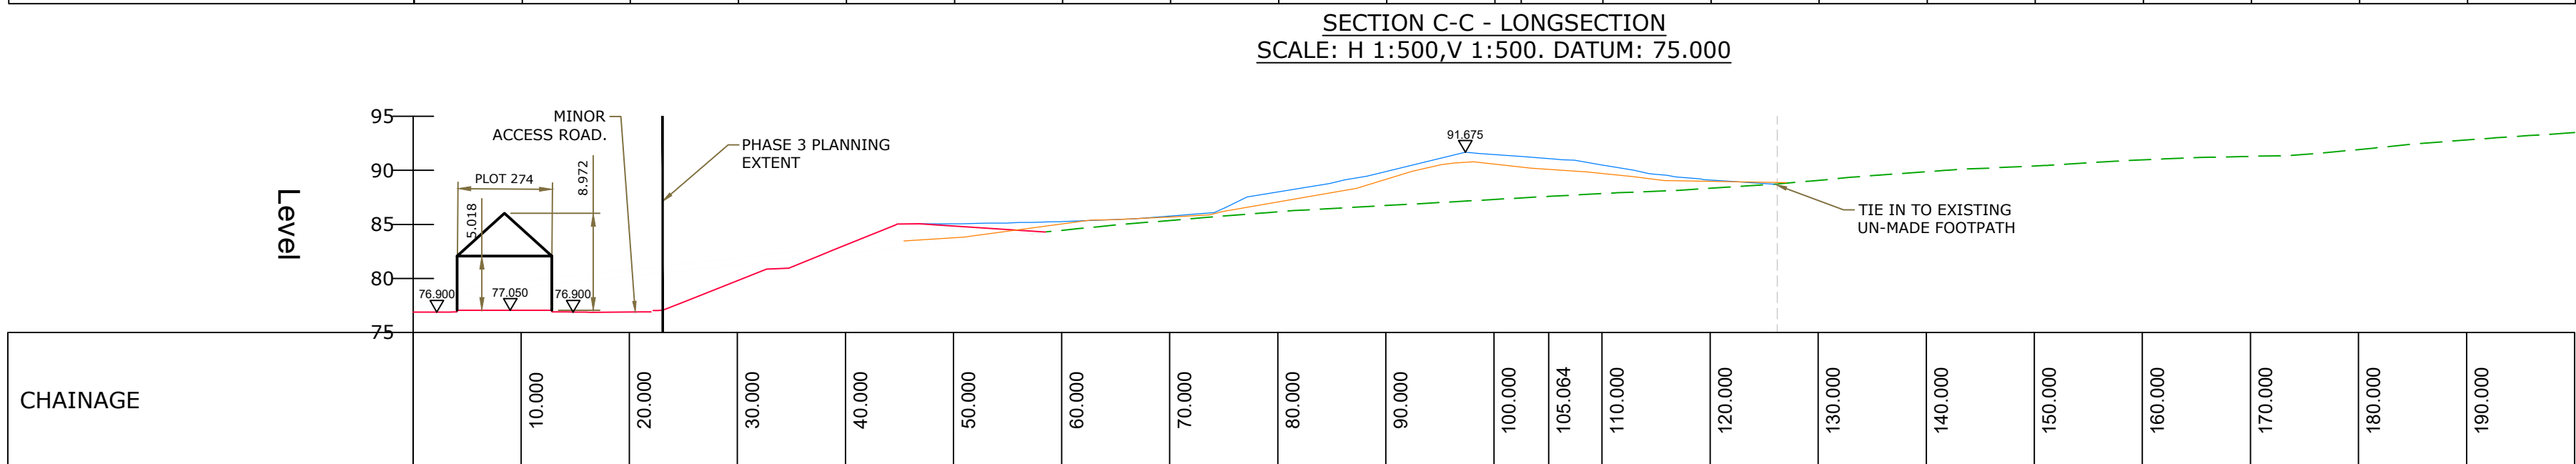
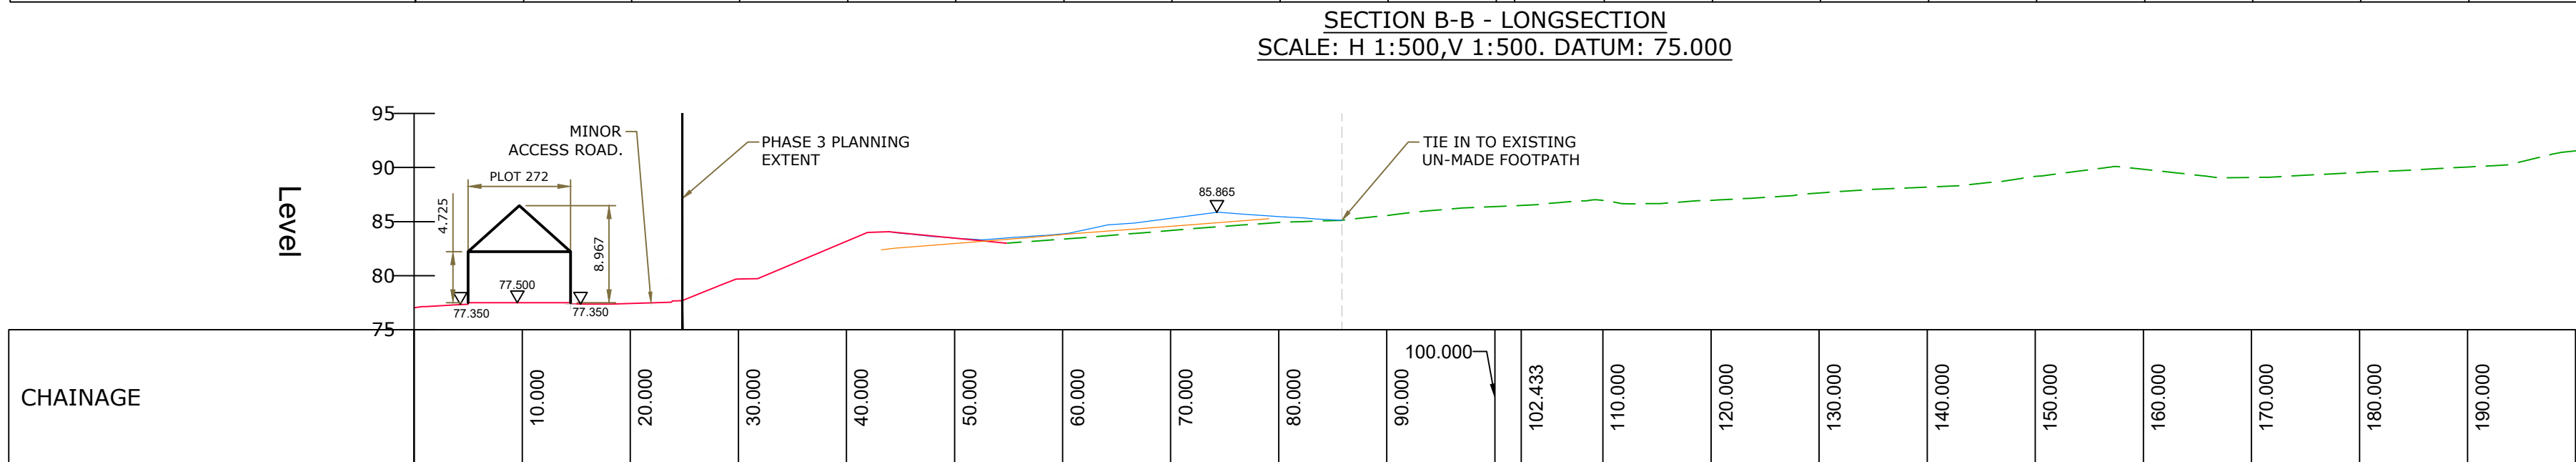
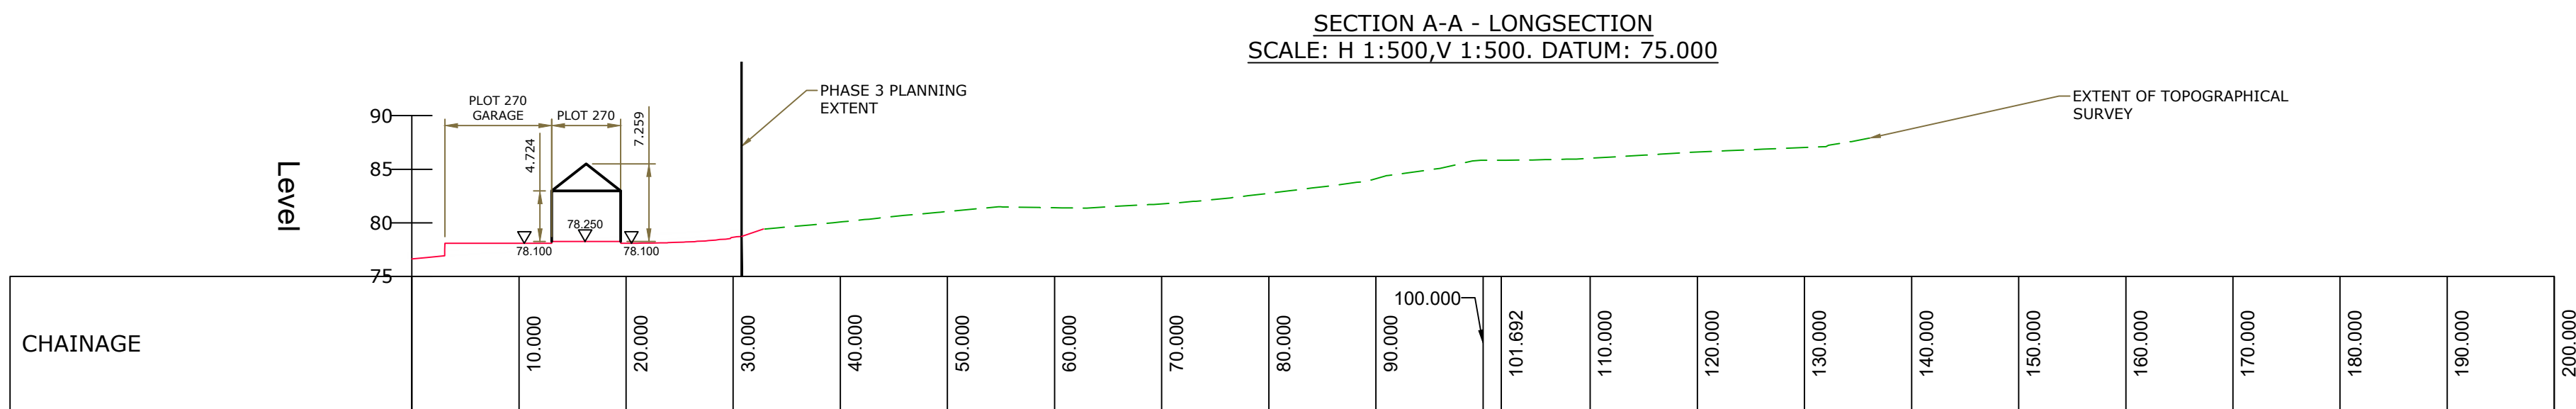


KEY	
—	CURRENT FINISHED GROUND PROFILE - APPROVED UNDER NMA Ref: 21/00996/NMA
---	EXISTING GROUND PROFILE OF COS
—	PROPOSED RE-GRADING/ STEPPED EMBANKMENT PROFILE
—	AS-BUILT RE-GRADING/ STEPPED EMBANKMENT PROFILE

NOTES

- THIS DRAWING IS TO BE READ IN CONJUNCTION WITH ALL RELEVANT ENGINEERS, ARCHITECTS AND SPECIALISTS DRAWINGS AND THE SPECIFICATION.
- DO NOT SCALE FROM THIS DRAWING MANUALLY OR ELECTRONICALLY. WRITTEN PERMISSION MUST BE OBTAINED FROM SWECO PRIOR TO SCALING ELECTRONICALLY OR USING THIS ELECTRONIC FILE.
- SITE LAYOUT BASED ON TREME DESIGN OVERALL SITE PLAN, DRG L1003/SITE EXT PH3/6001 REV T5, RECEIVED 20.07.23 TOPOGRAPHICAL SURVEY FROM ASC (SURVEYS) LTD DRAWING ASC.17.250, RECEIVED 15/01/18.
- FOR SECTION LOCATIONS REFER TO 66200295-SWE-ZZ-XX-D-C-4150.

DRAWING FOR APPROVAL
NOT FOR CONSTRUCTION

CONSTRUCTION (DESIGN AND MANAGEMENT) REGULATIONS 2015

DESIGNER'S HAZARD INFORMATION FOR CONSTRUCTION

- IF YOU DO NOT FULLY UNDERSTAND THE RISKS INVOLVED DURING THE CONSTRUCTION OF THE ITEMS INDICATED ON THIS DRAWING ASK YOUR MANAGER, HEALTH & SAFETY ADVISOR OR A MEMBER OF THE DESIGN TEAM BEFORE PROCEEDING.
 - STRIKING CHARTED AND UNCHARTED BURIED AND OVERHEAD SERVICES.
 - DEEP DRAINAGE EXCAVATIONS. RISK OF FALLS, COLLAPSE OF TRENCH OR BATTER, CONFINED SPACES.
 - CONNECTIONS TO EXISTING LIVE SEWERS/DRAINS. RISK OF DANGEROUS GASES/CONDITIONS/DISEASE.
 - CONFLICT BETWEEN CONSTRUCTION WORKERS, VISITORS AND GENERAL PUBLIC WITH MOVING PLANT AND VEHICLES.
 - WORKS ADJACENT TO AND WITHIN PUBLIC ADOPTED HIGHWAY. CONFLICT BETWEEN CONSTRUCTION WORKERS/ACTIVITIES AND MOVING VEHICLES.
- THE ABOVE NOTES REFER SPECIFICALLY TO THE INFORMATION SHOWN ON THIS DRAWING.
REFER TO THE HEALTH AND SAFETY PLAN FOR FURTHER INFORMATION.

P03	10.10.2024	AS-BUILT EMBANKMENT PROFILE ADDED	GJ	RS	TM
P02	10.09.2024	SECTIONS AMENDED	GJ	RS	SP
P01	05.09.2024	FIRST ISSUE	GJ	RS	SP
Rev	Date	Amendment Details	Dr'n	Chk'	App'

This drawing should not be relied on or used in circumstances other than those for which it was originally prepared and for which Sweco UK Limited was commissioned. Sweco UK Limited accepts no responsibility for this drawing to any party other than the person by whom it was commissioned. Any party which breaches the provisions of this disclaimer shall indemnify Sweco UK Limited for all loss or damage arising therefrom.
COPYRIGHT © Sweco 2021

Sweco
North Kiln, Felaw Maltings
46 Felaw Street
Ipswich
IP2 8PN
Tel: +44 (0)1473 231 100
Web: www.sweco.co.uk



Client

VISTRY HOMES

Project Title

NEWMARKET ROAD, ROYSTON

Drawing Title

SOIL REDISTRIBUTION CUT &
FILL SECTIONS - OPTION 6
SHEET 1

Purpose Of Issue

PRELIMINARY

Status	Status Description
--------	--------------------

Designed	Drawn	Checked	Approved
----------	-------	---------	----------

TM	GJ	RS	SP
----	----	----	----

Sheet Size	Scale	SWECO Ref	Revision
------------	-------	-----------	----------

A1	1:500	66200295	P03
----	-------	----------	-----

Drawing Number

66200295-SWE-ZZ-XX-D-C-4151