



ELEVATION 3

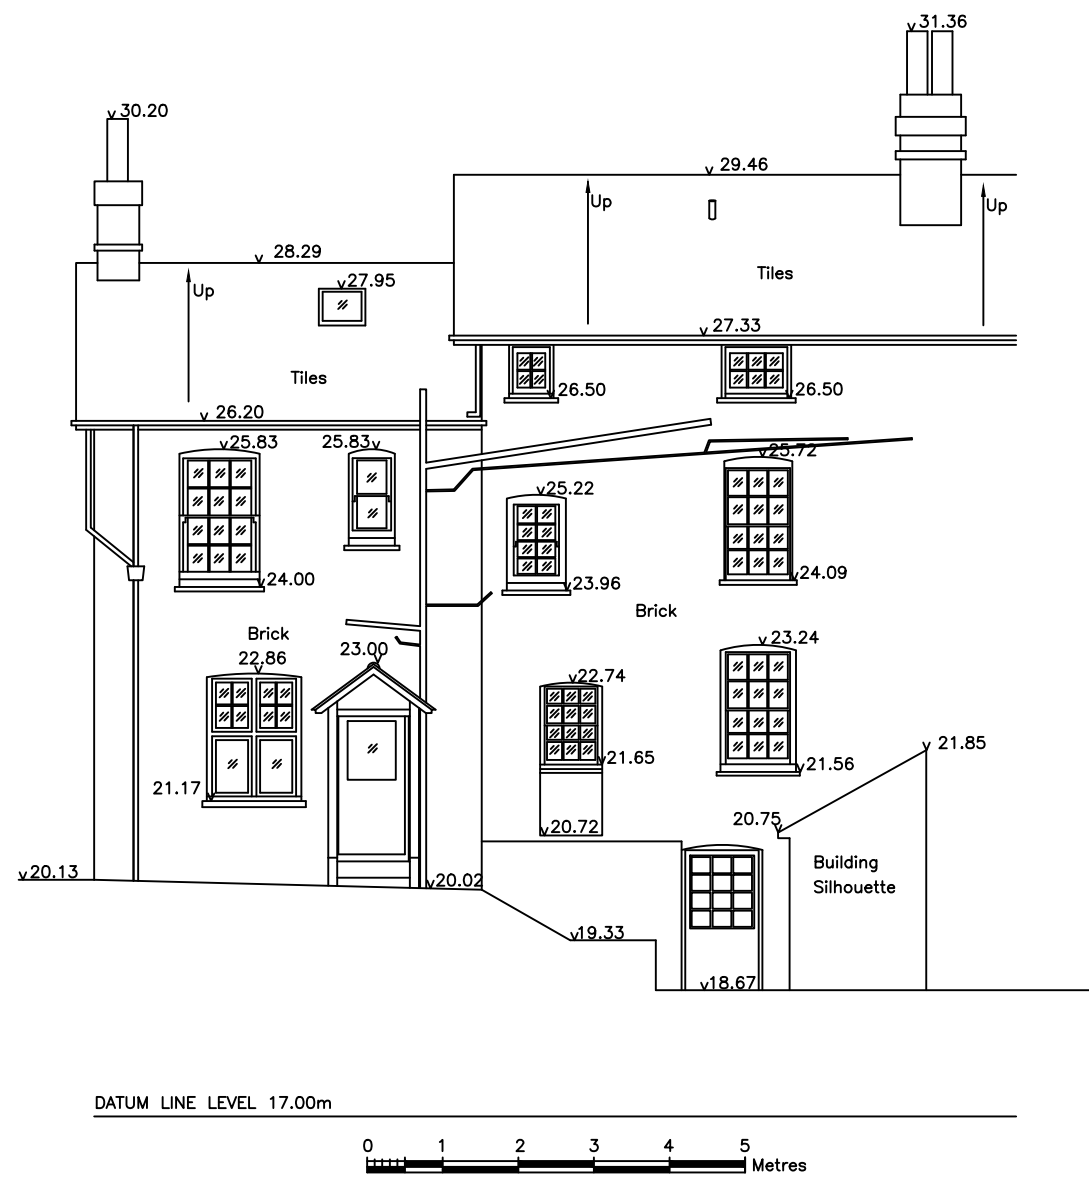

NOTES

- * Drainage pipe sizes (where shown) have been gauged from the surface for safety reasons and should be regarded as approximate only.
- * Tree species (where shown) should be treated with caution and expert identification is advised.
- * Although this is a digital survey the accuracy and amount of detail shown is only commensurate with the graphical scale of mapping as specified. Care should be exercised in working to larger scales.
- * Visible features in the vicinity of the boundaries as shown above, may not represent the extent of legally conveyed ownership.
- * Whilst every effort has been made to achieve accuracy on this plan, CRUCIAL INFORMATION, such as levels and invert levels should be checked prior to design and construction.
- * Kerb levels have been taken in the bottom of the channel.
- * Areas shown in red are areas of high water level. These areas will be shown in outline only and marked as 'dense underwater growth'.

SECTION B

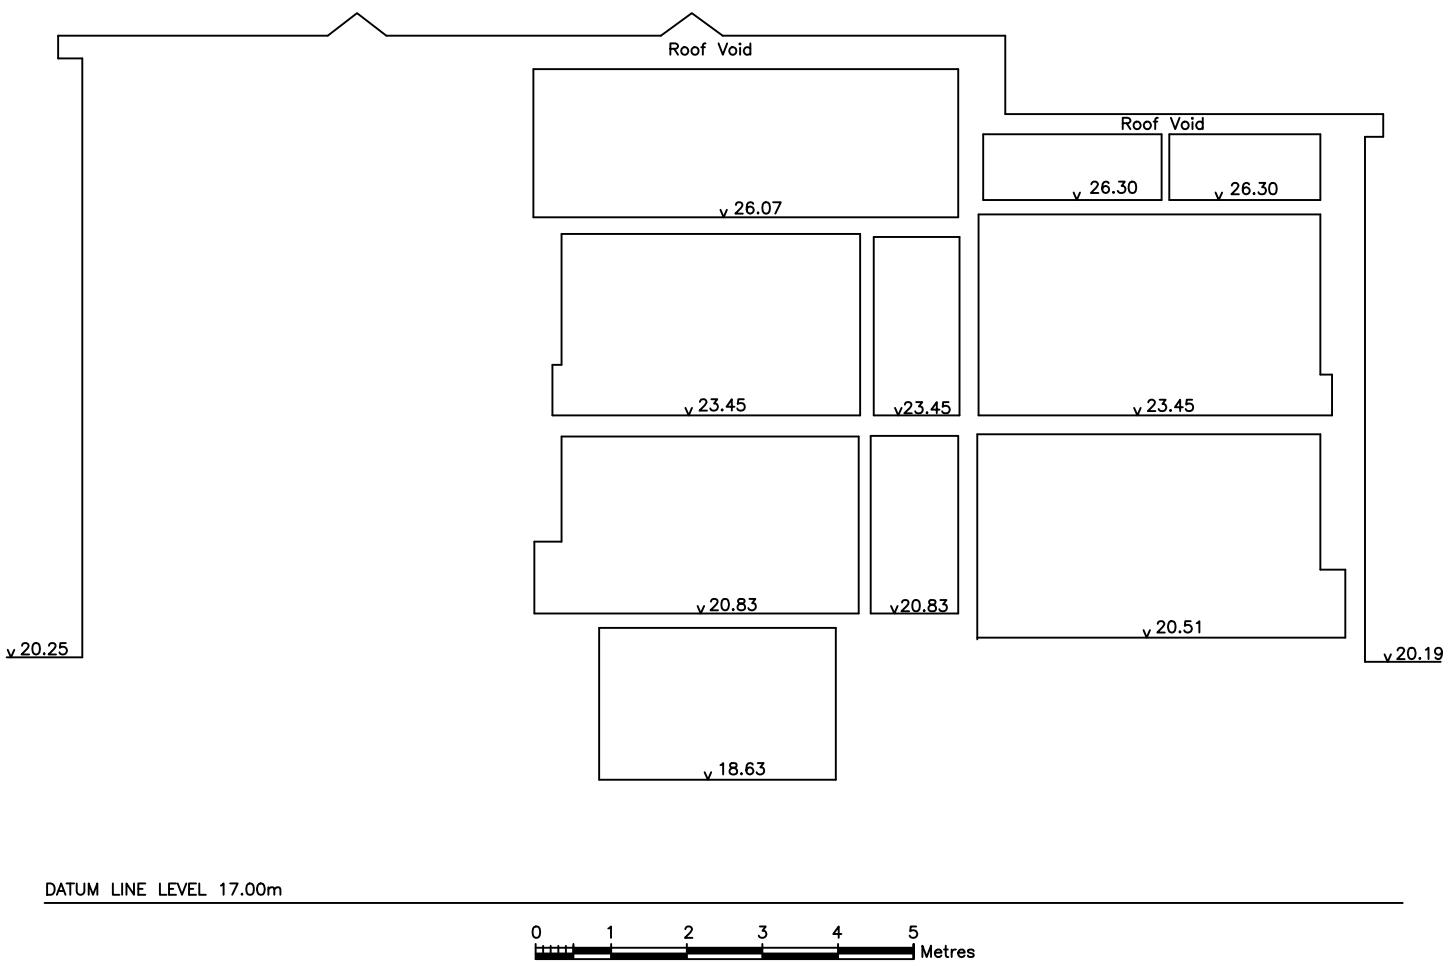

ELEVATIONS AND SECTIONS

NO	DATE	REVISION

DRAWING NO	L 9195/4	REV 0
SCALE	1 : 100 @ A1	
SEE ALSO DWG NOS	L 9195/1-3	
SHEET	4 of 4	
REF NO	L 9195	