




AS BUILT

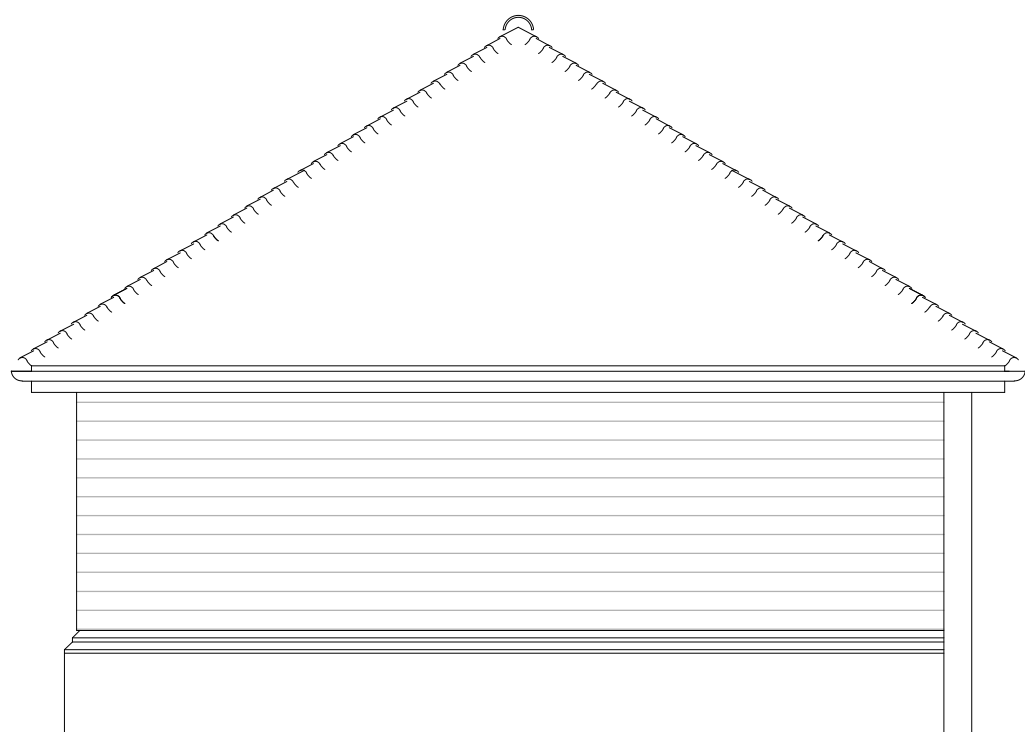


LHS ELEVATION 1:50

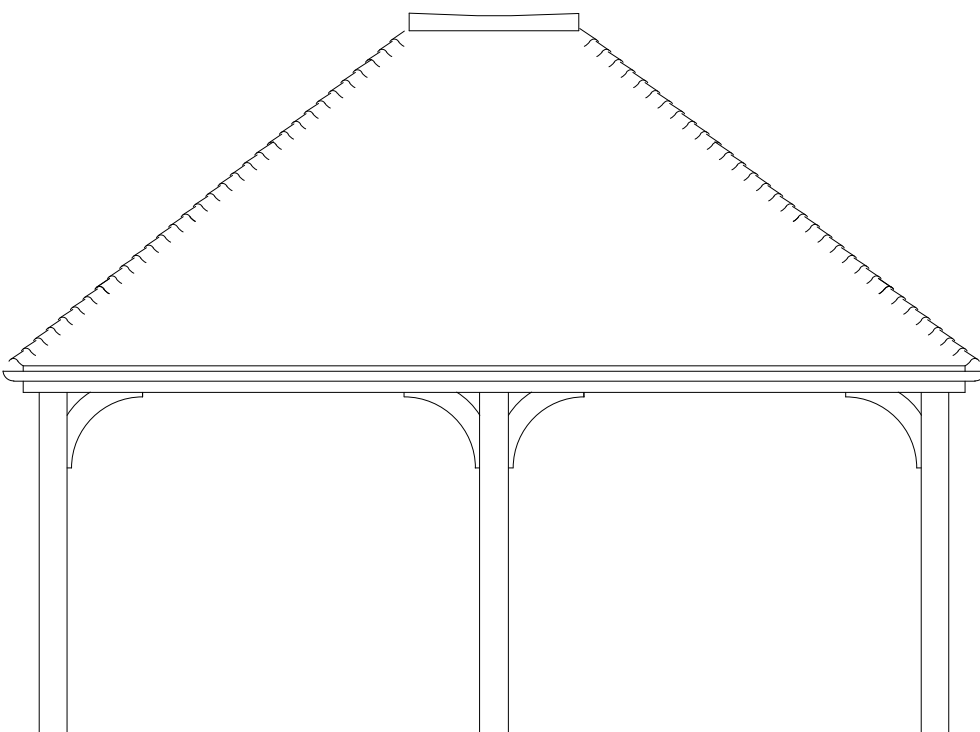


FRONT ELEVATION 1:50

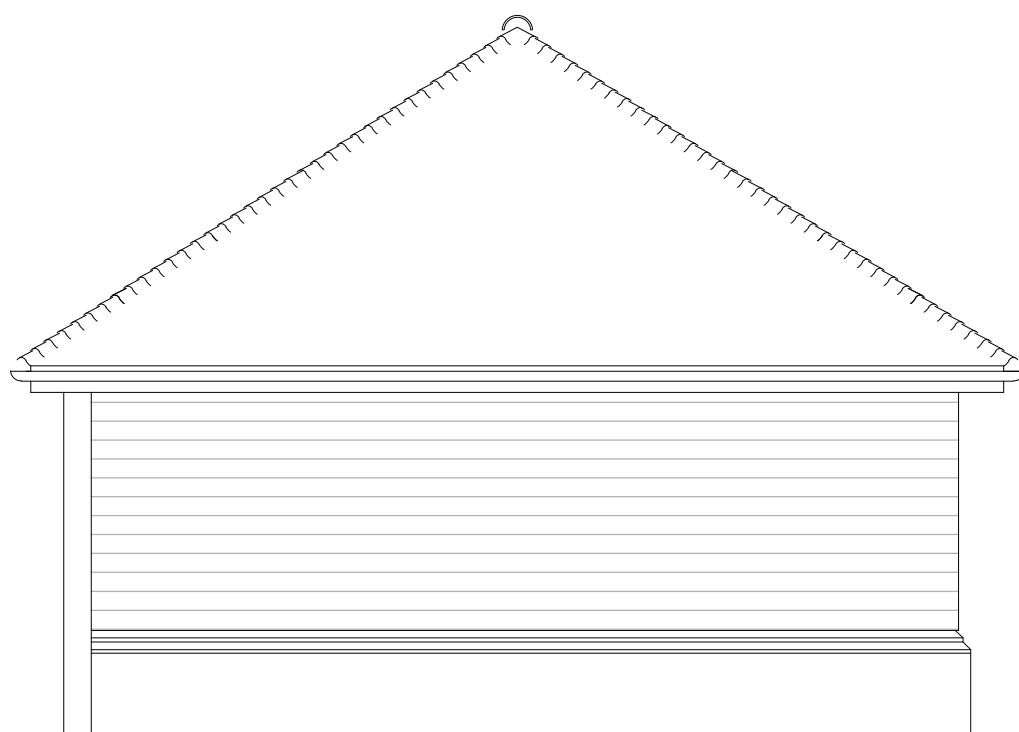


RHS ELEVATION 1:50

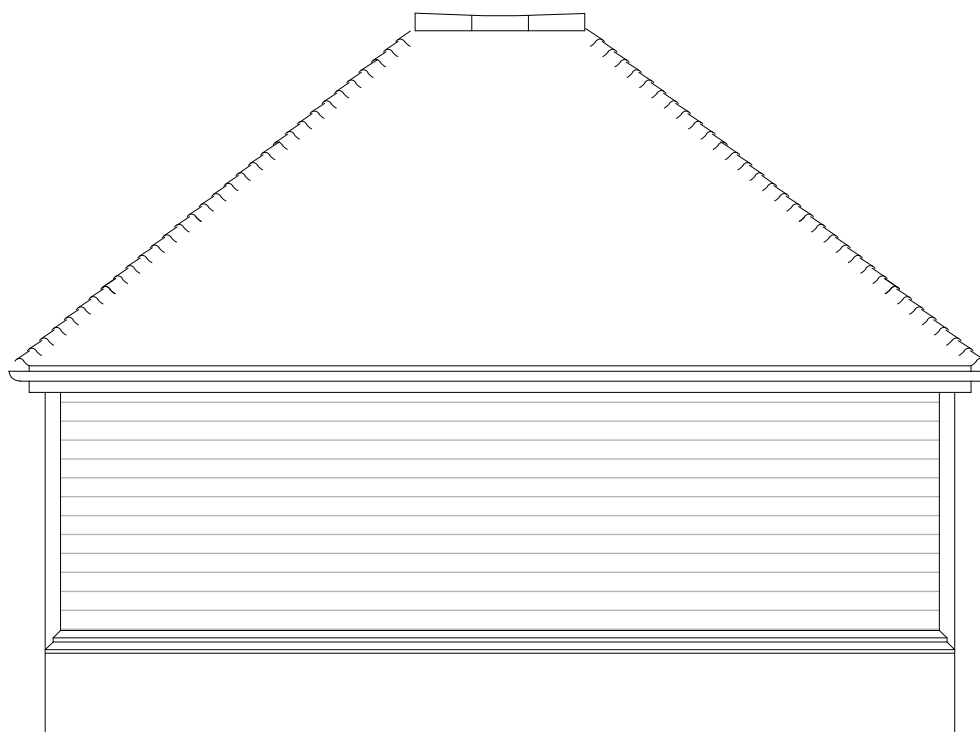


REAR ELEVATION 1:50

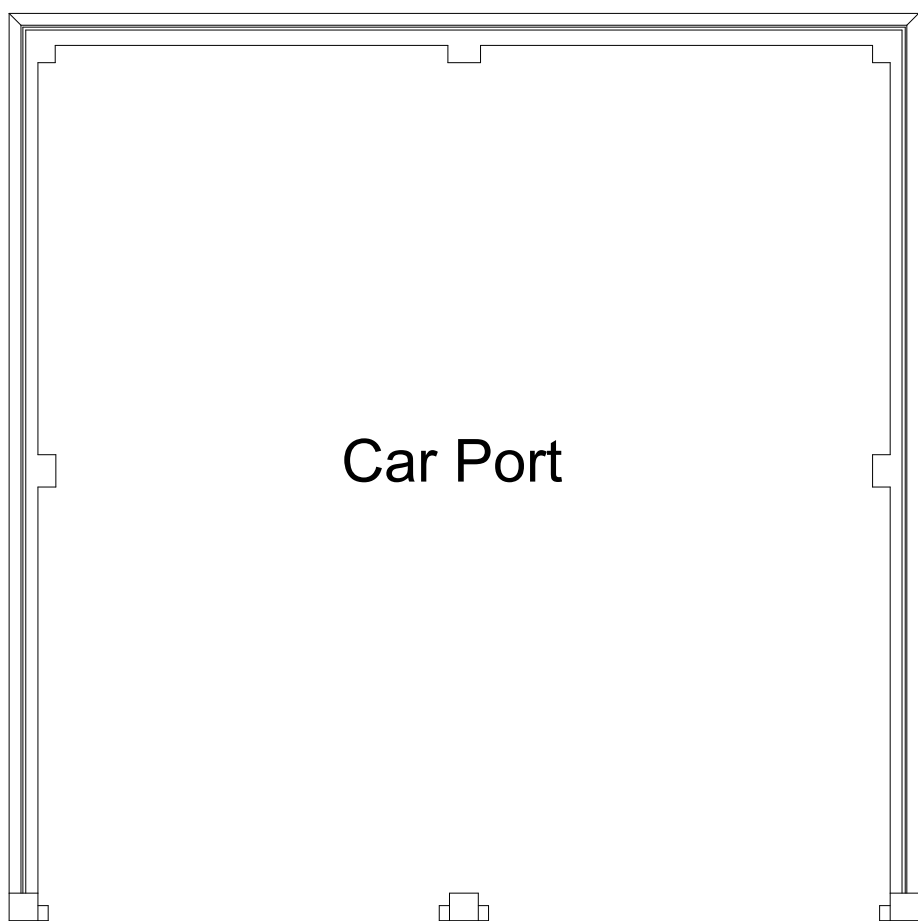

FLOOR PLAN 1:50

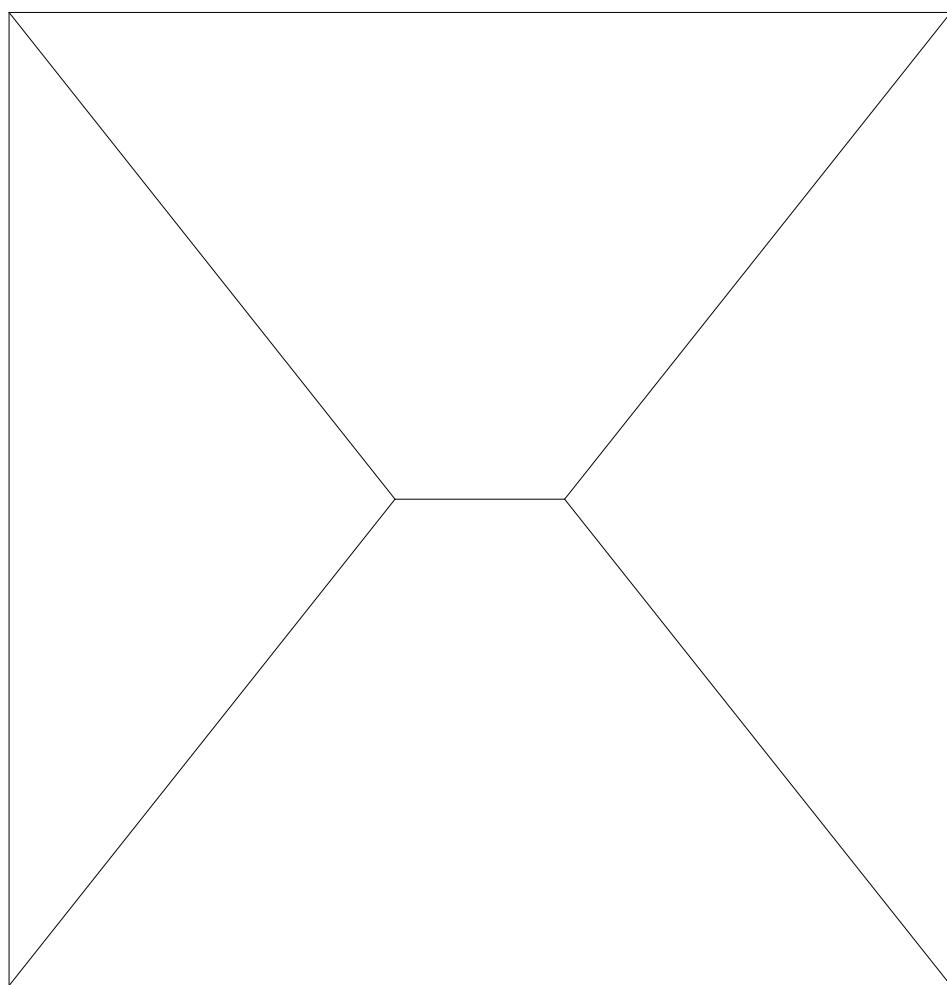

ROOF PLAN 1:50

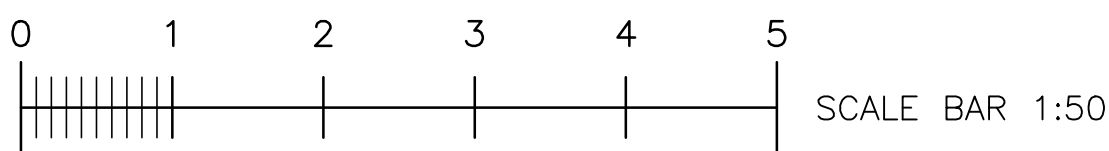

REVISION	REVISION NOTES	DATE
SITE ADDRESS BIBBSWORTH HALL FARM BIBBS HALL LANE HITCHIN SG4 8EN		THIS DRAWING IS ISSUED SOLELY ON THE UNDERSTANDING THAT IT IS COPYRIGHT, SHOULD BE REGARDED AS CONFIDENTIAL AND MUST NOT BE REPRODUCED WITHOUT THE DESIGNERS CONSENT.
N. TURNER DESIGNS LTD 28 FREEMANS CLOSE STOKE POGES BUCKS SL2 4ER MOB: 07825 372 548		DRAWN BY N. TURNER, B.Eng (Hons)
		DRAWN ON 29/01/2026
		SCALE 1:50 © A1
		DRG NO 2026-01-6049/1