





Proposed Front Elevation
1 : 100




Proposed North Elevation
1 : 100

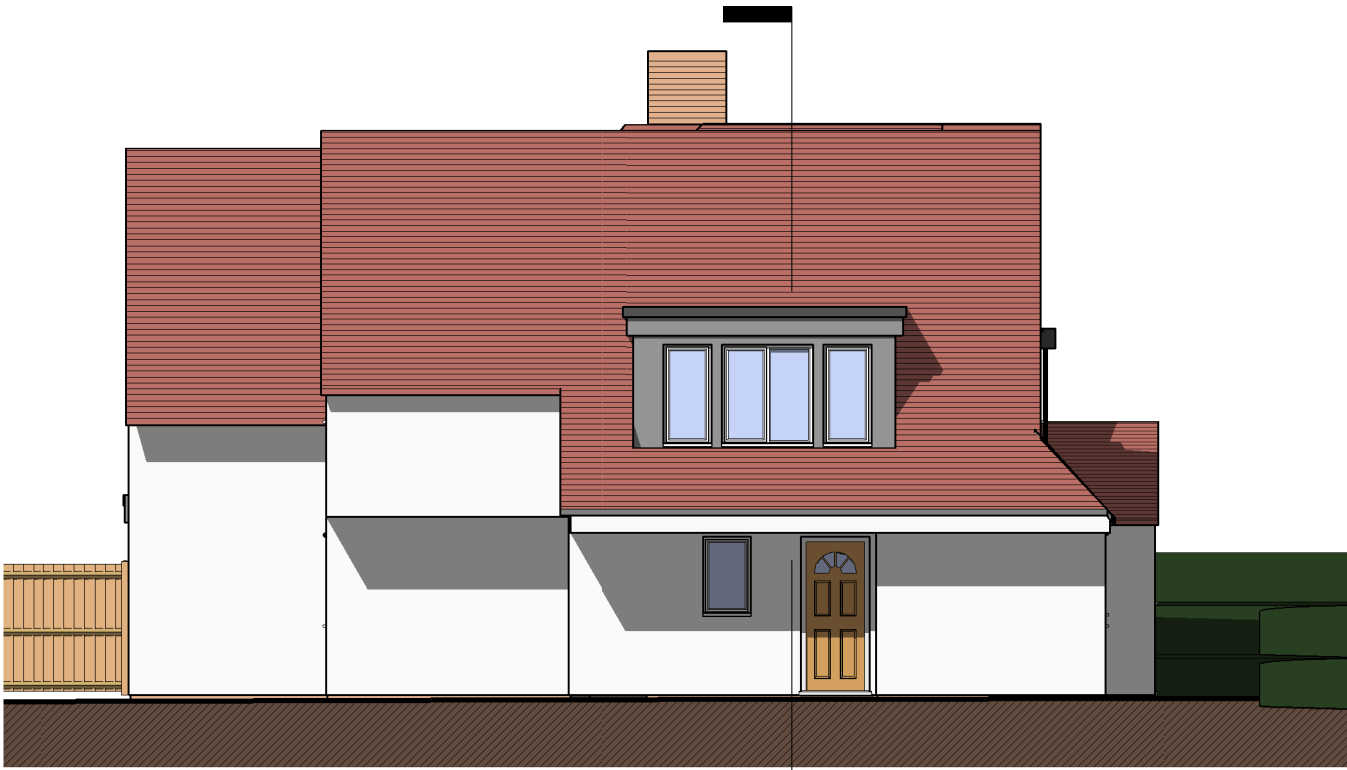


Proposed Rear Elevation
1 : 100

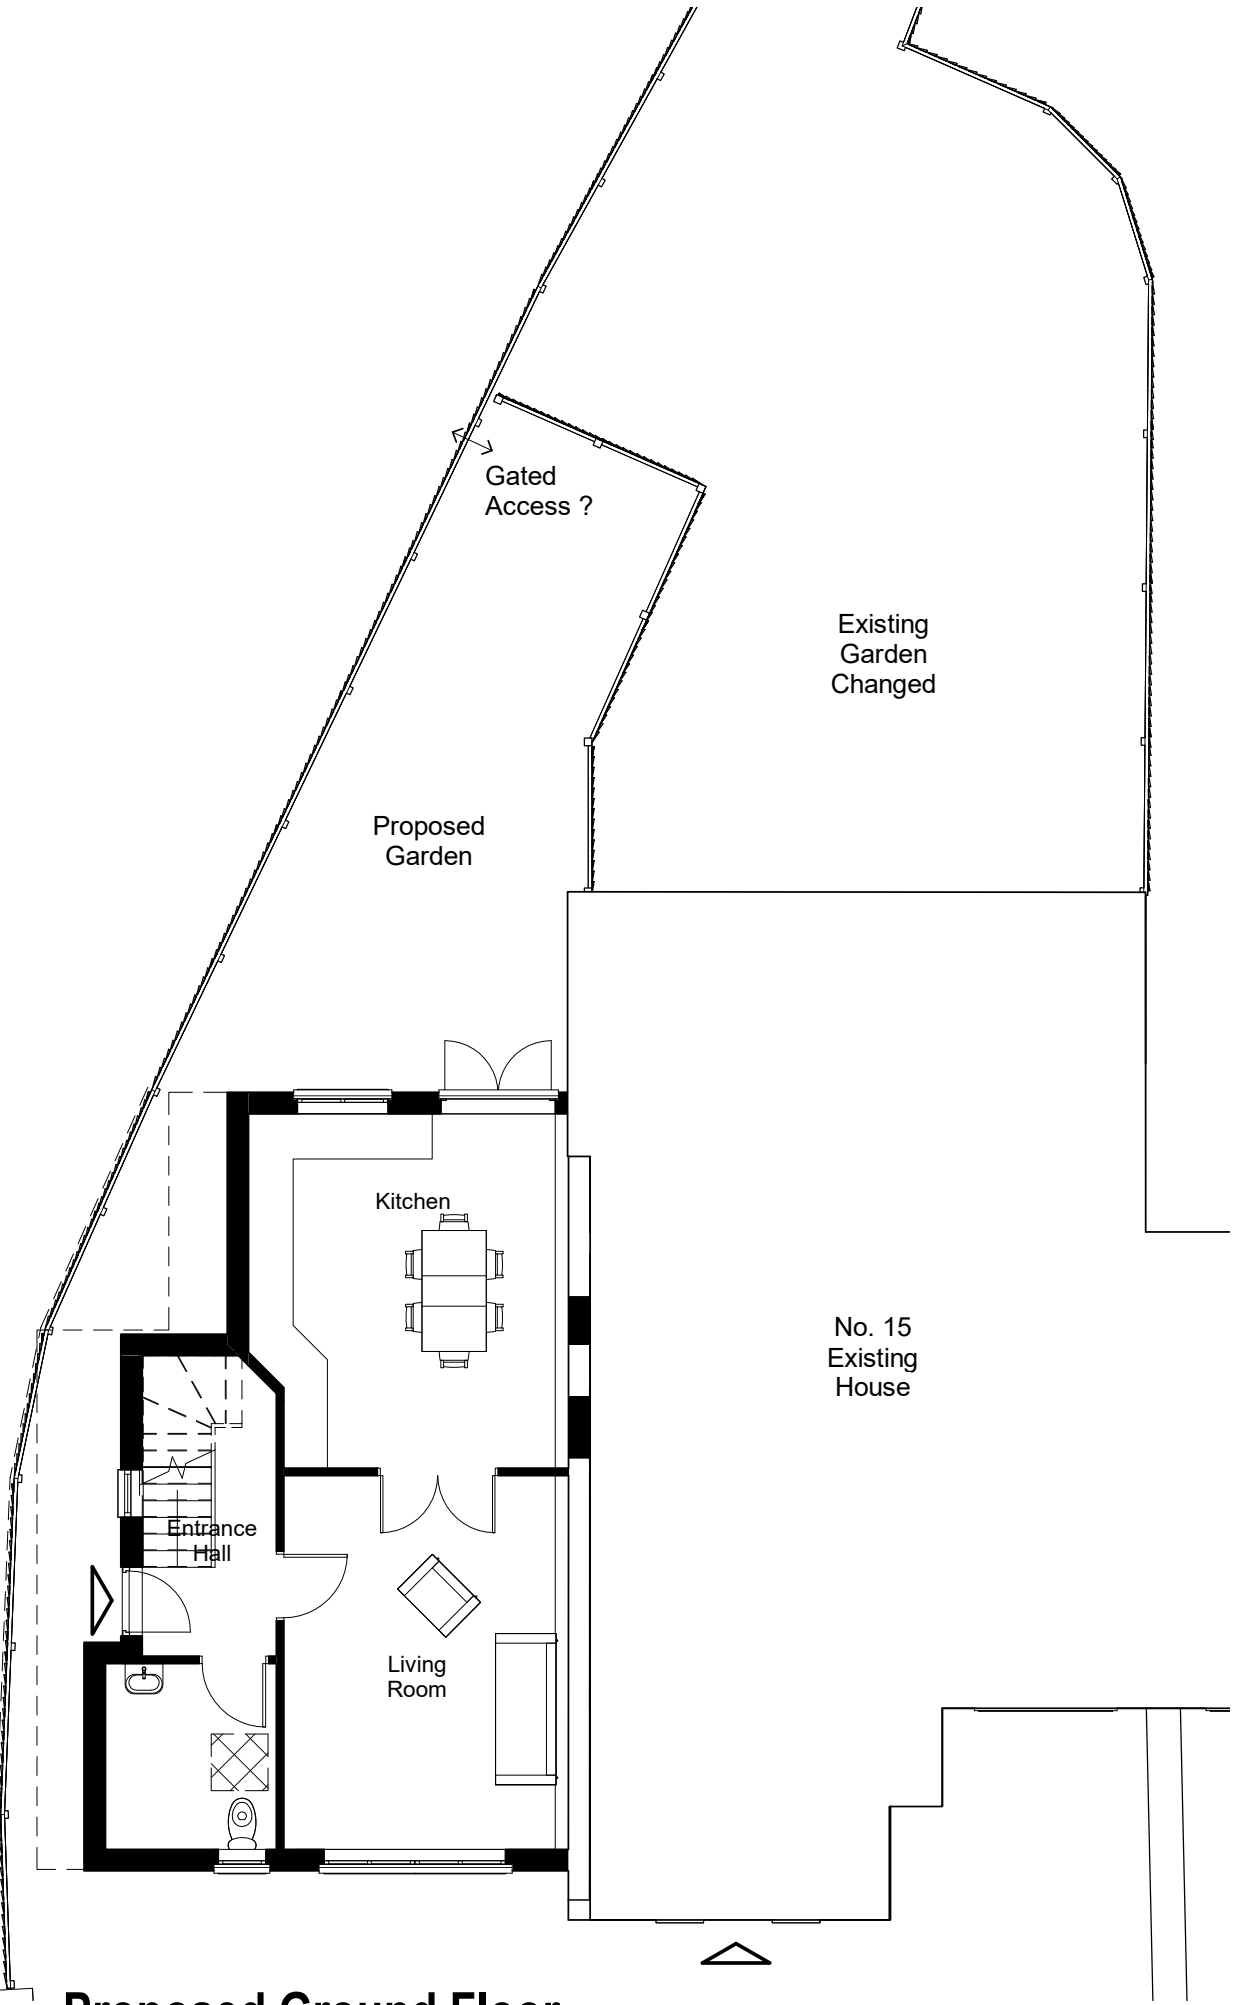

Proposed Ground Floor
1 : 100

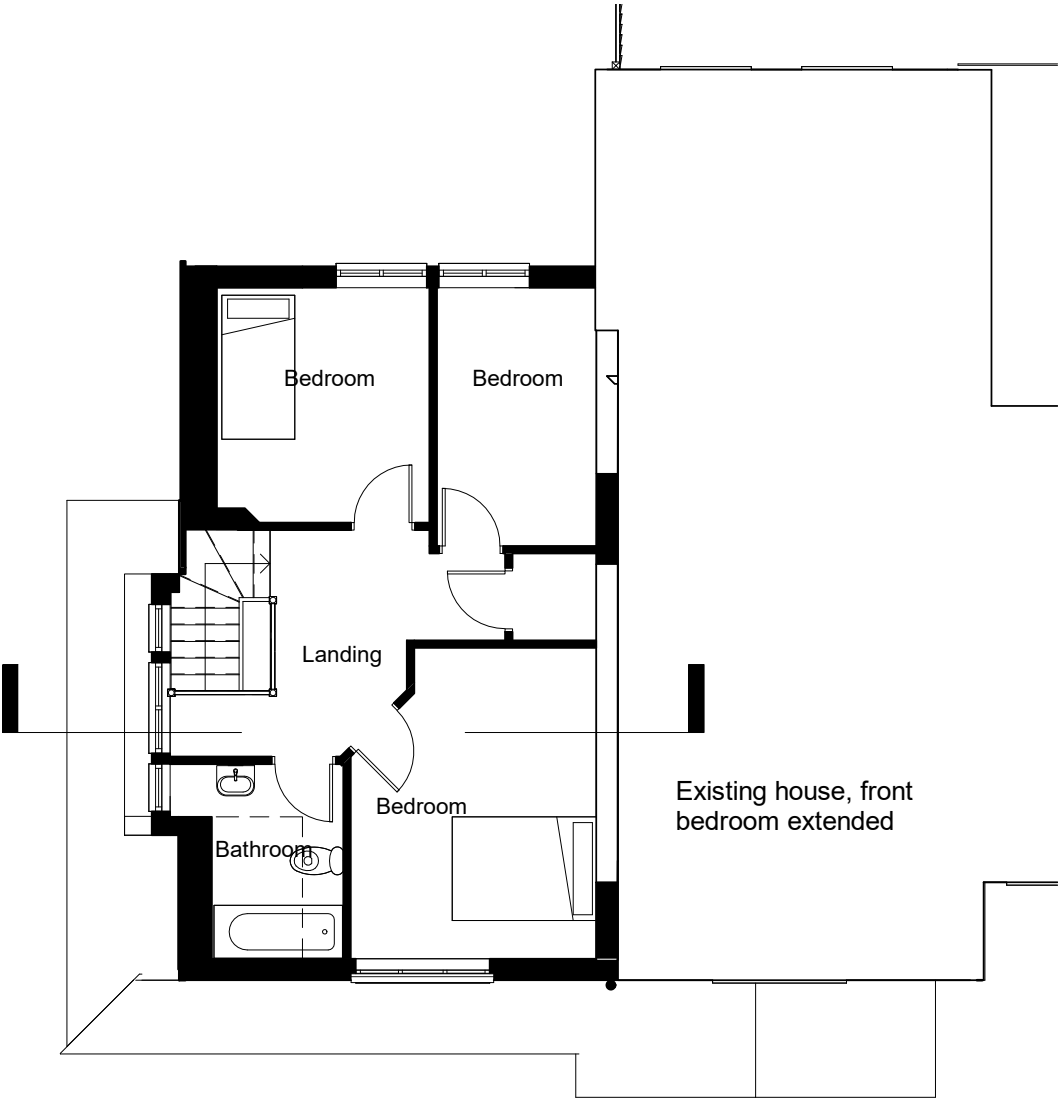

Proposed First Floor
1 : 100

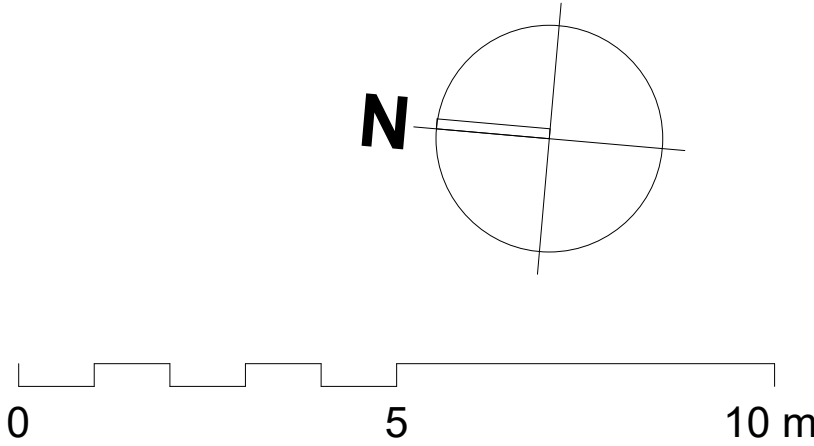

Drawings, as built for the Annex at
no. 15 The Crescent, St Ippolits

Site Plans, Floor Plans and Elevations

Job No. TC15
Drawing No. 10

Scale. 1:100
Sheet size. A2

Date August '25