



1. Manufacturers should not scale from this drawing
2. For structural dimensions and details see Structural Engineers' drawings.
3. All dimensions to be checked on site prior to commencement of any works or preparation of any shop drawings.
4. All errors in co-ordinates, levels and dimensions, are to be reported to the Architect.
5. All temporary works to be responsibility of the contractor.
6. This drawing to be read in conjunction with all relevant Architect's drawings and specifications and with other Consultant's Information.

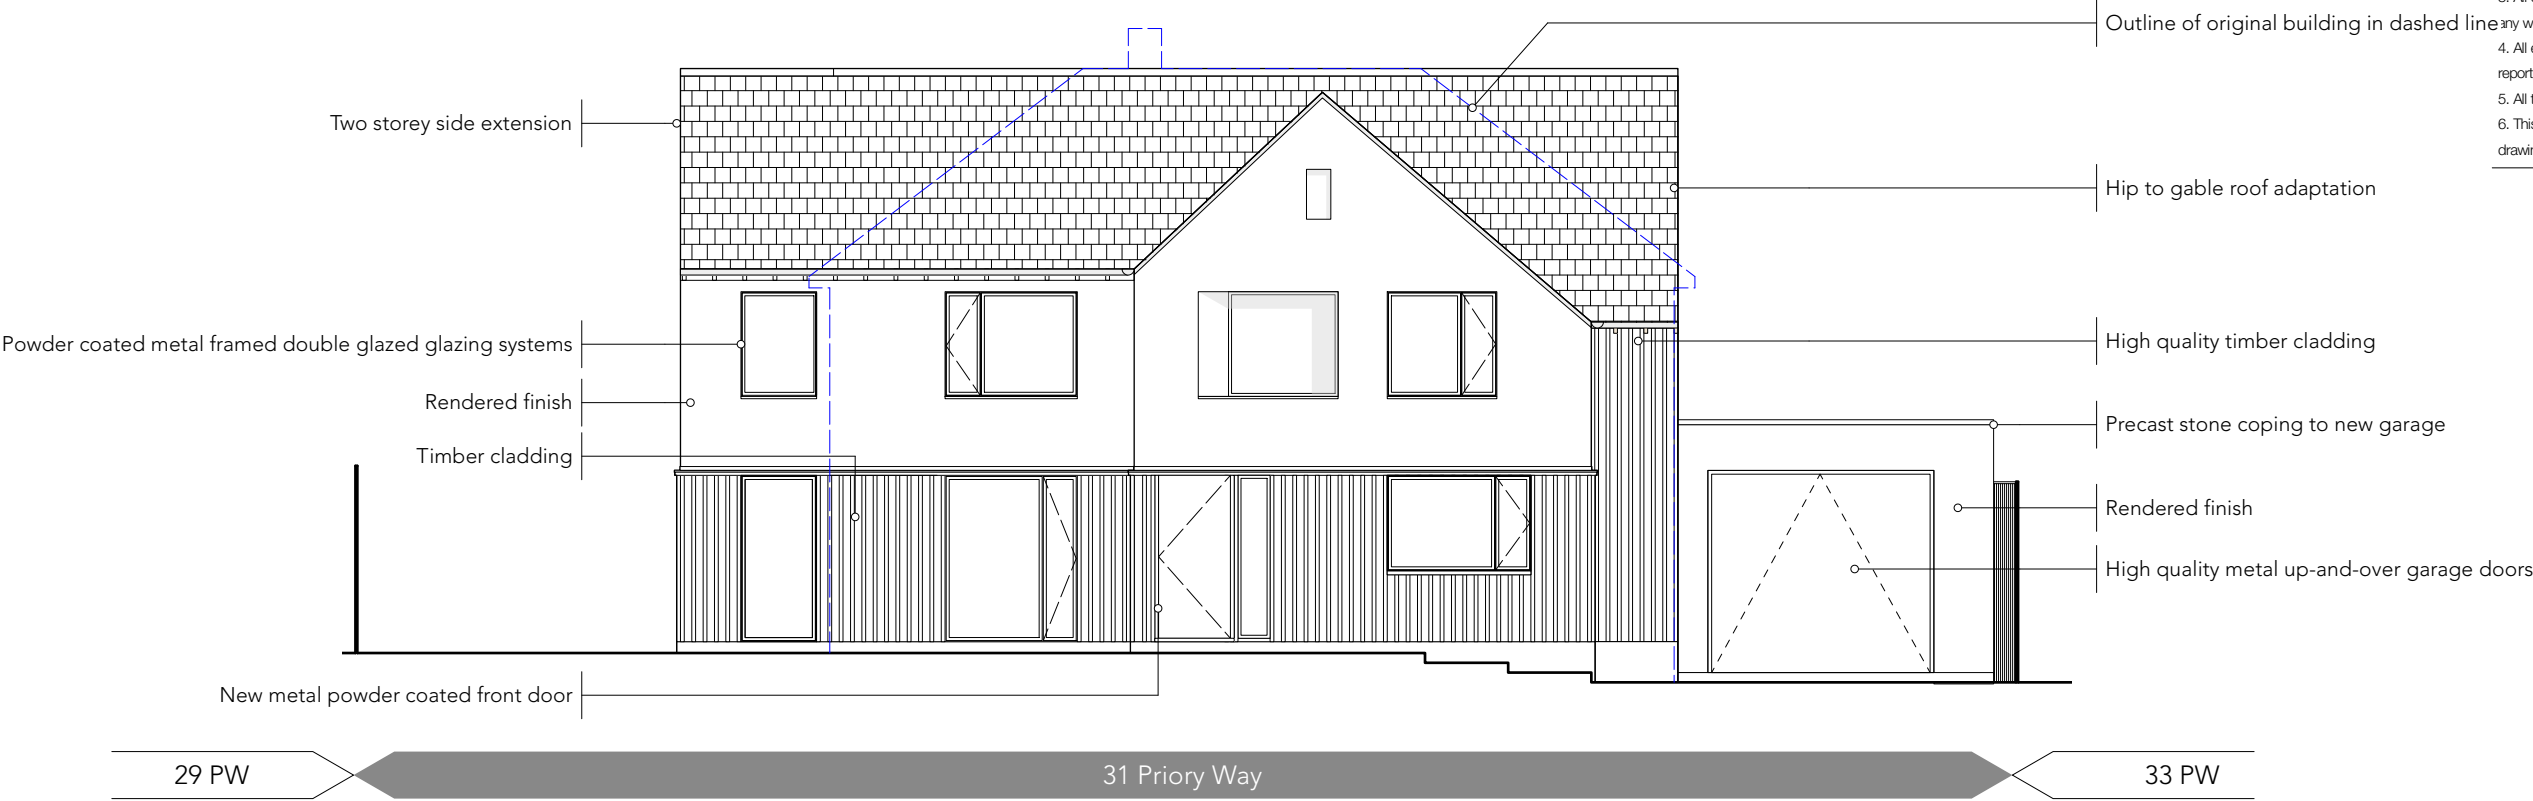

**As Built
Front Elevation**

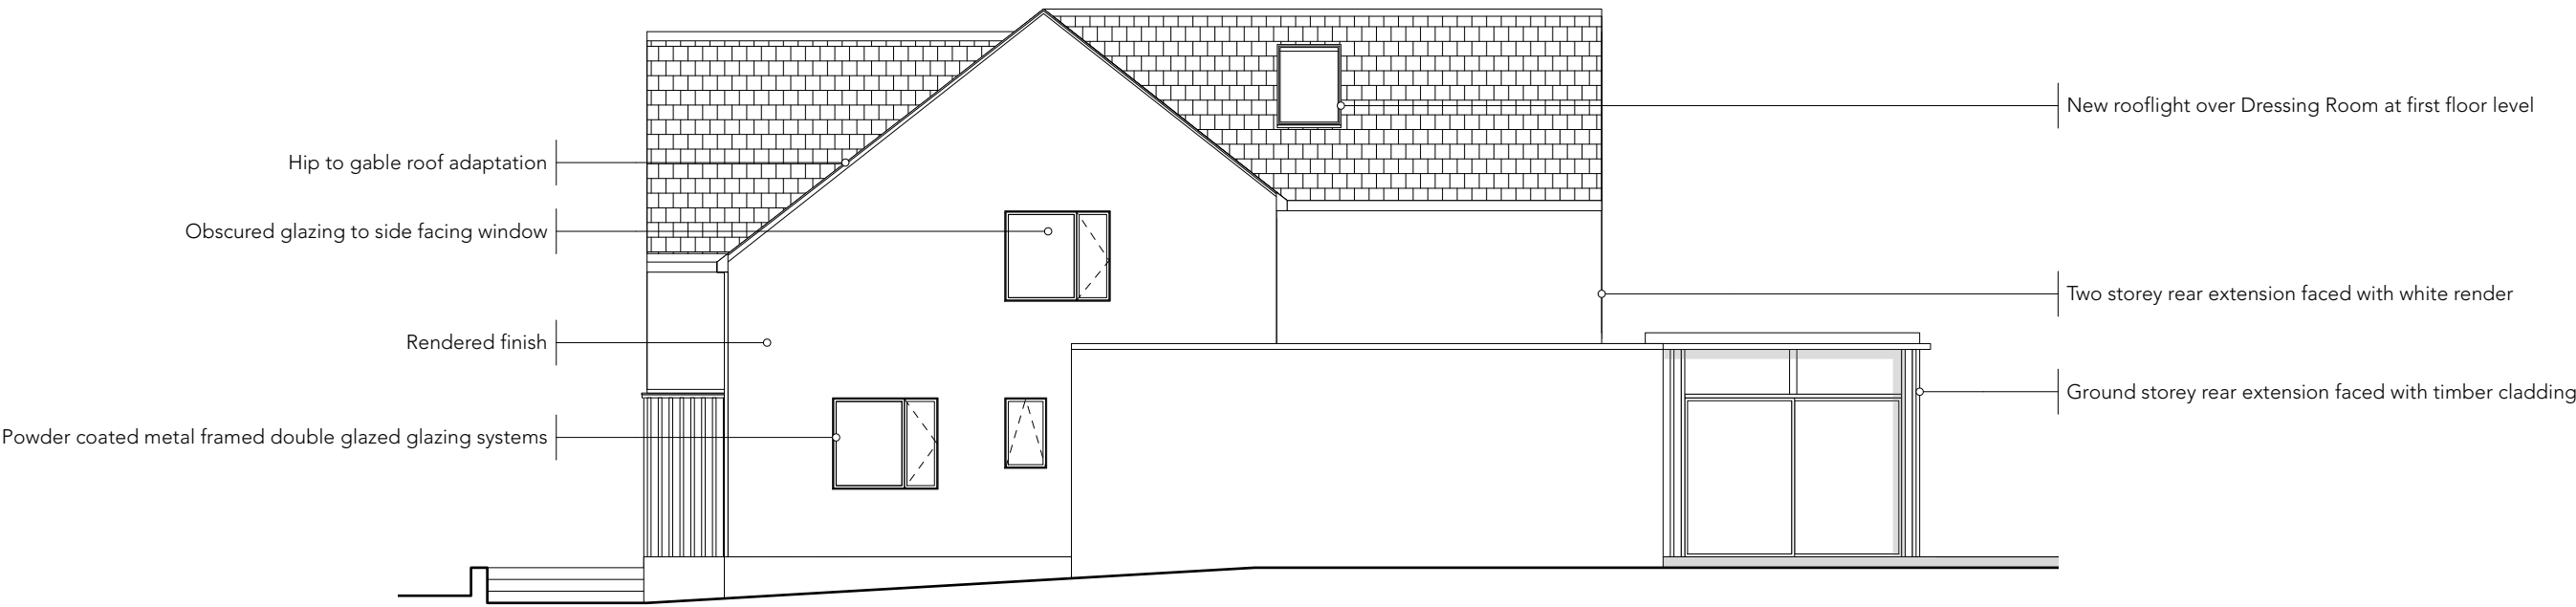

**As Built
Side Elevation (East)**

OWA			
RIBA CHARTERED PRACTICE 5 BLENHEIM STREET, LONDON W1 INFO@OW-A.CO.UK WWW.OW-A.CO.UK			
Site Address	31 Priory Way, Hitchin SG4 9BJ		
Project	Extension and Remodelling		
Drawing Title	As Built Elevations		
Drawing Number	D3_120_Rev A		
Status	PLANNING		
Date	Revision	Scale	
04/01/2023			1:100 @ A3