


- 1. Manufacturers should not scale from this drawing
- 2. For structural dimensions and details see Structural Engineers' drawings.
- 3. All dimensions to be checked on site prior to commencement of any works or preperation of any shop drawings.
- 4. All errors in co-ordinates, levels and dimensions, are to be reported to the Architect.
- 5. All temporary works to be responsibility of the contractor.
- 6. This drawing to be read in conjunction with all relevant Architect's drawings and specifications and with other Consultant's Information.

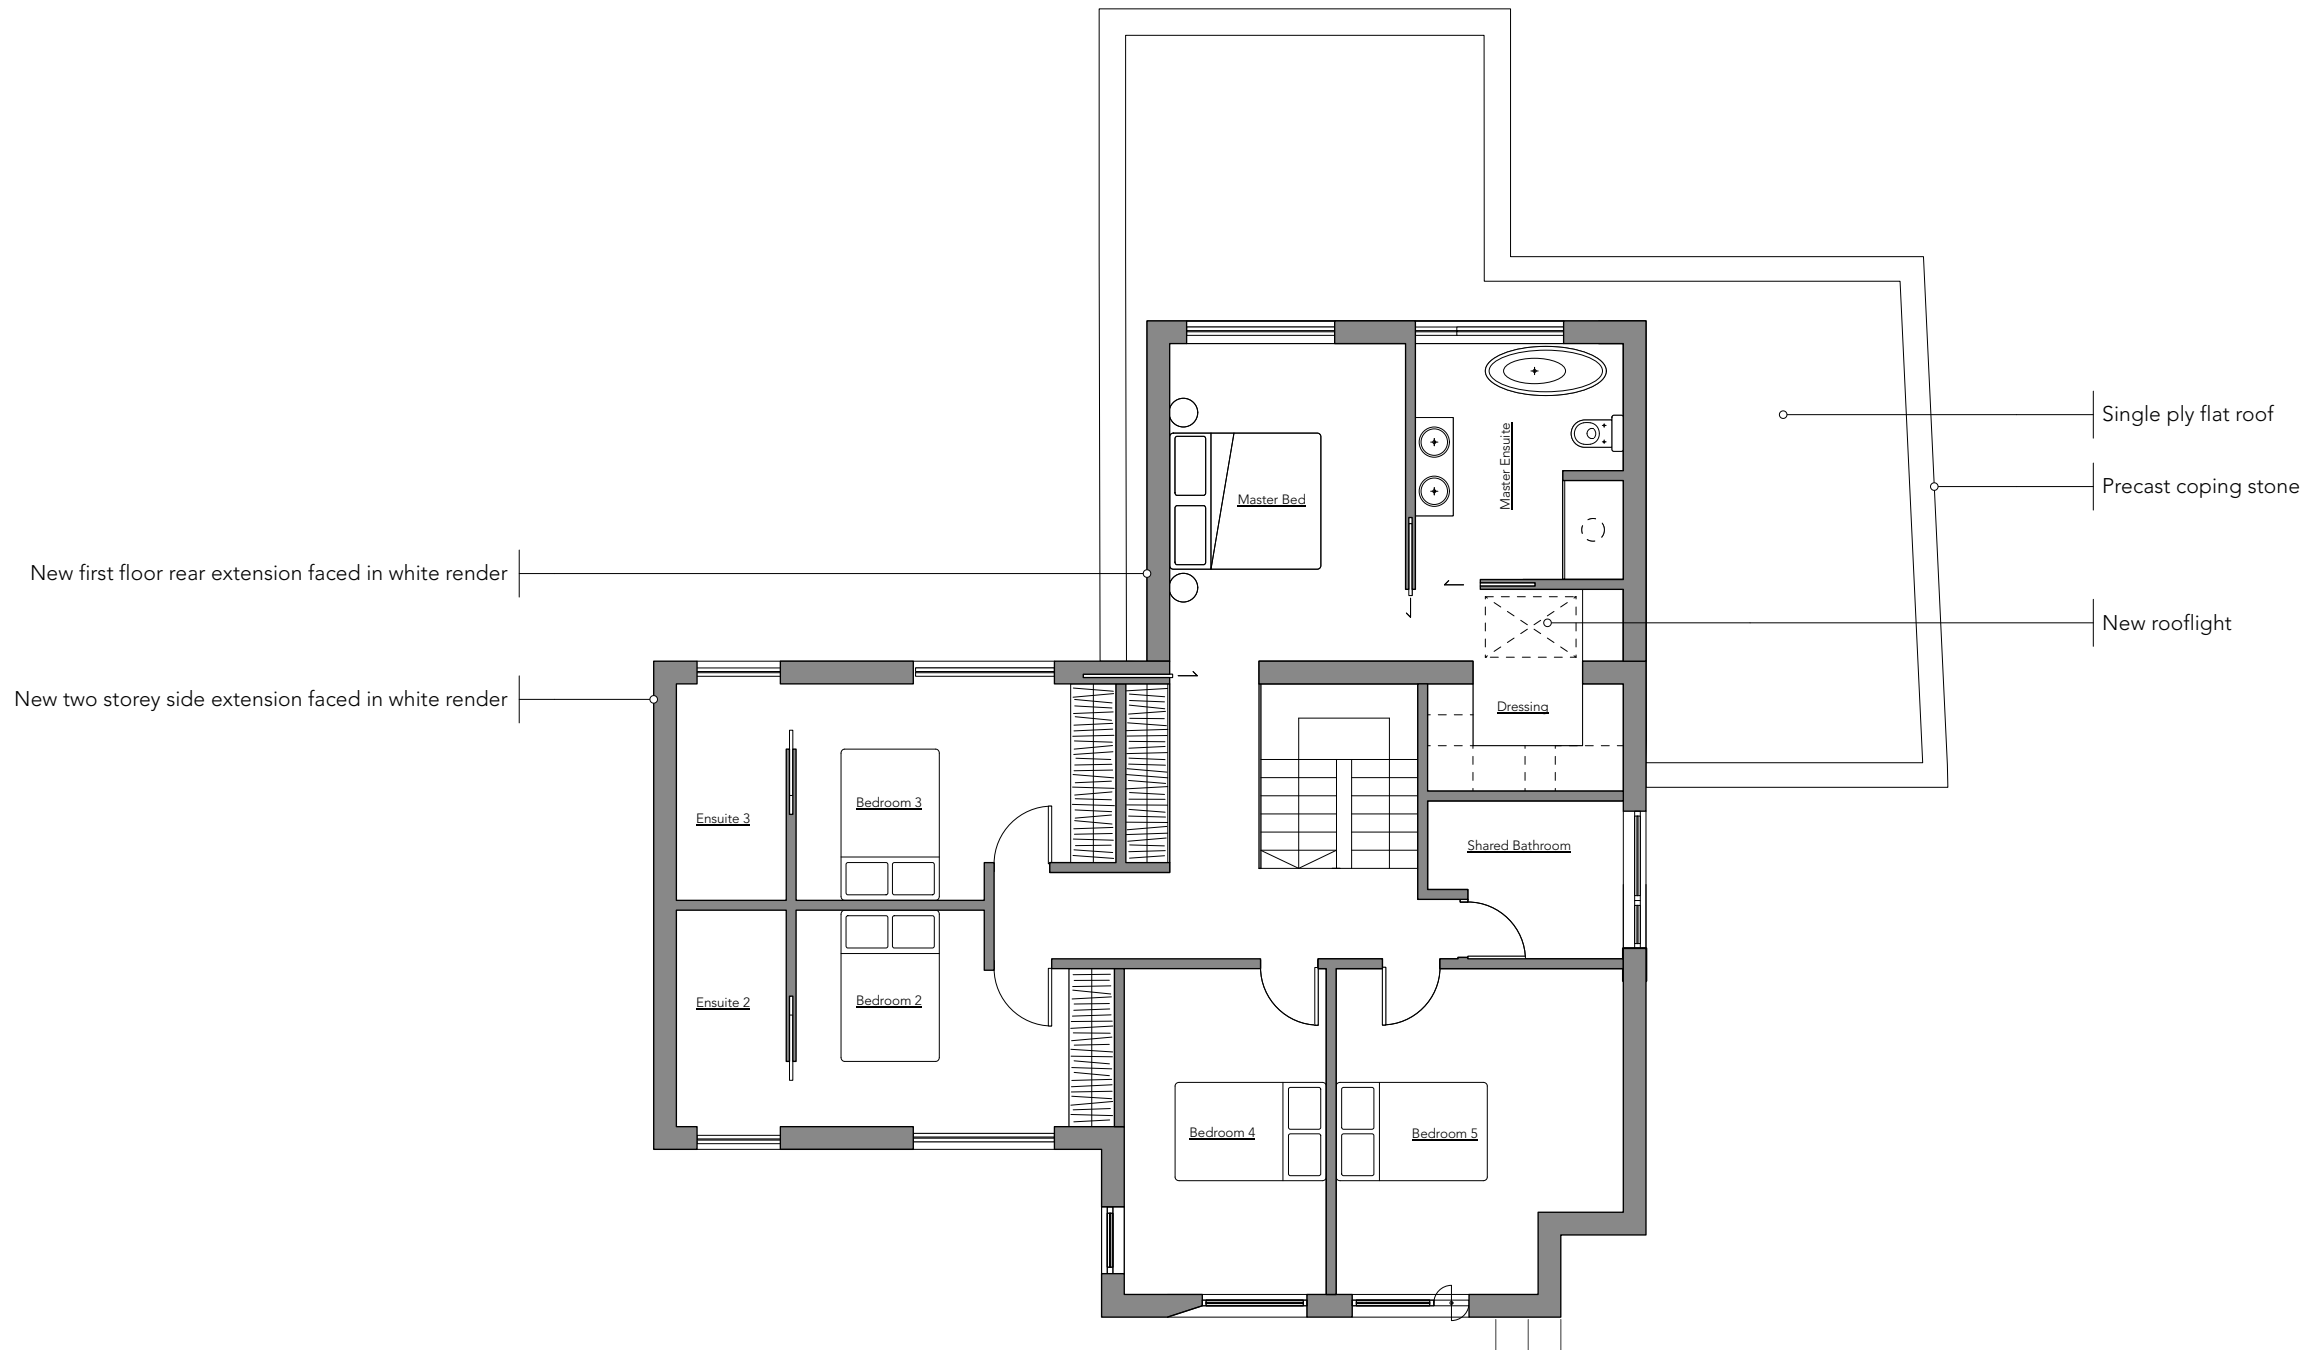

Proposed First Floor Plan

01234 M

OWA

RIBA CHARTERED PRACTICE

5 BLENHEIM STREET, LONDON W1

INFO@OW-A.CO.UK

WWW.OW-A.CO.UK

Site Address	31 Priory Way, Hitchin SG4 9BJ
Project	Extension and Remodelling
Drawing Title	As Built First Floor Plan
Drawing Number	D3_111_Rev A
Status	PLANNING
Date	04/01/2023
Revision	
Scale	1:100 @ A3