




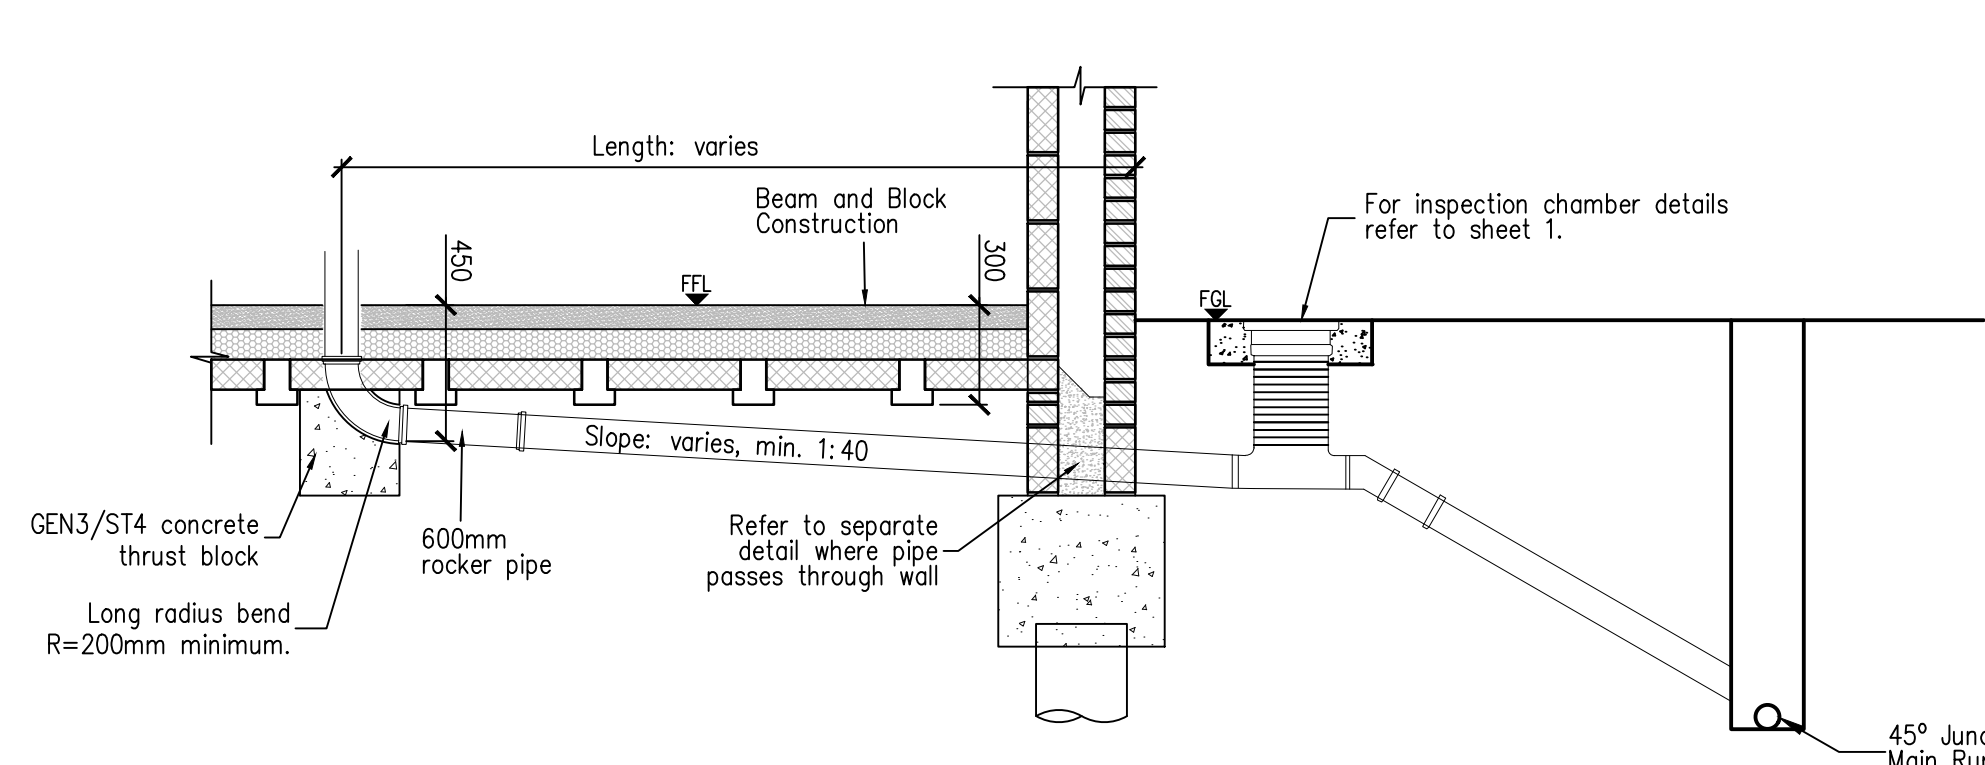


Typical details of drainage below beam and block floor passing over foundation
1:25

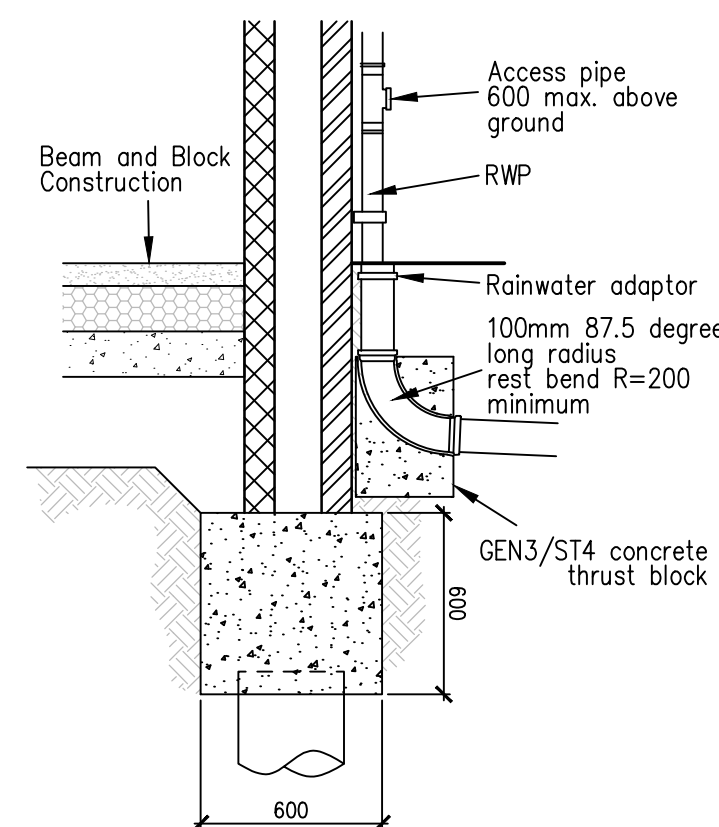


External RWP to Drain
1:25

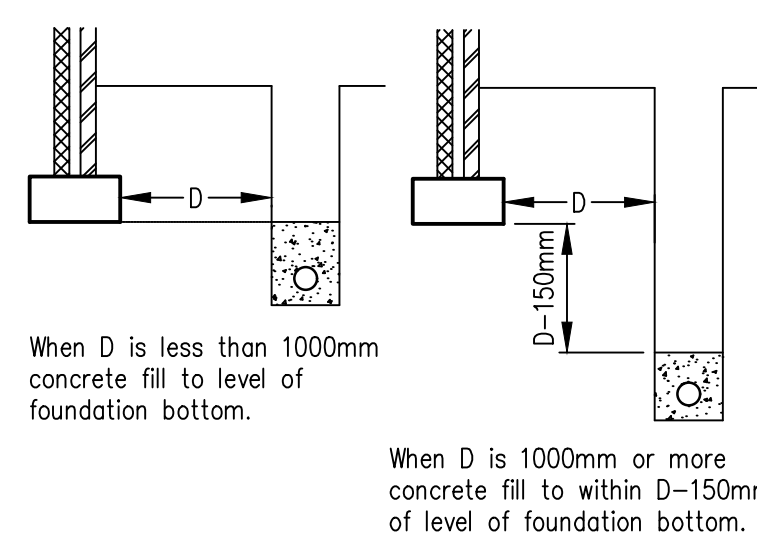


Concreting of Drains Laid Near Foundations
1:50

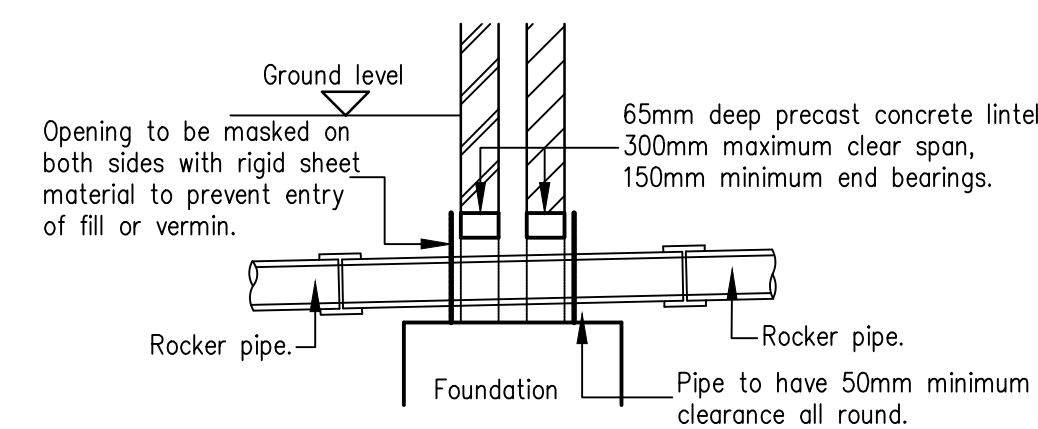

Detail Where Drain Passes Through Wall
1:20

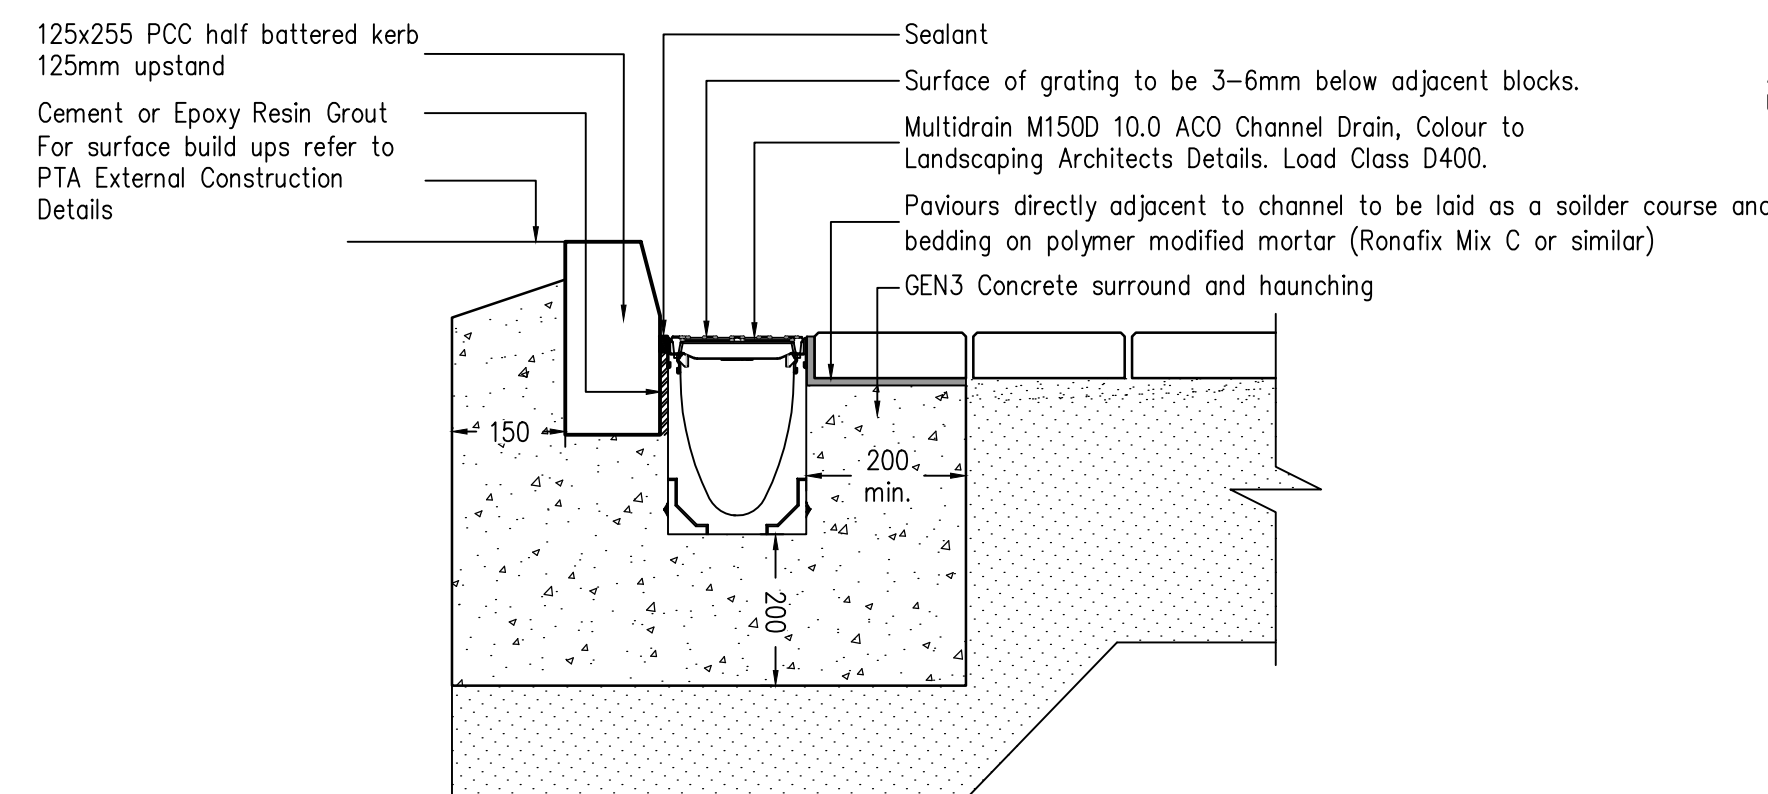


MultiDrain Typical Drainage Channel Detail
1:10

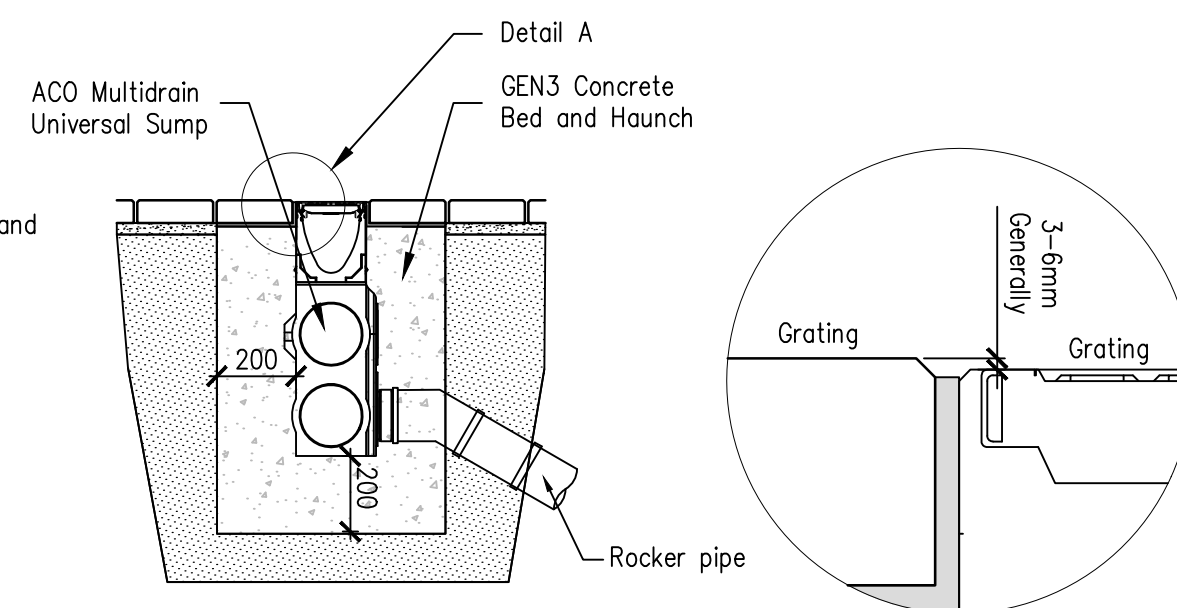


Multidrain External Channel Drain Sump Unit
1:20


Detail A

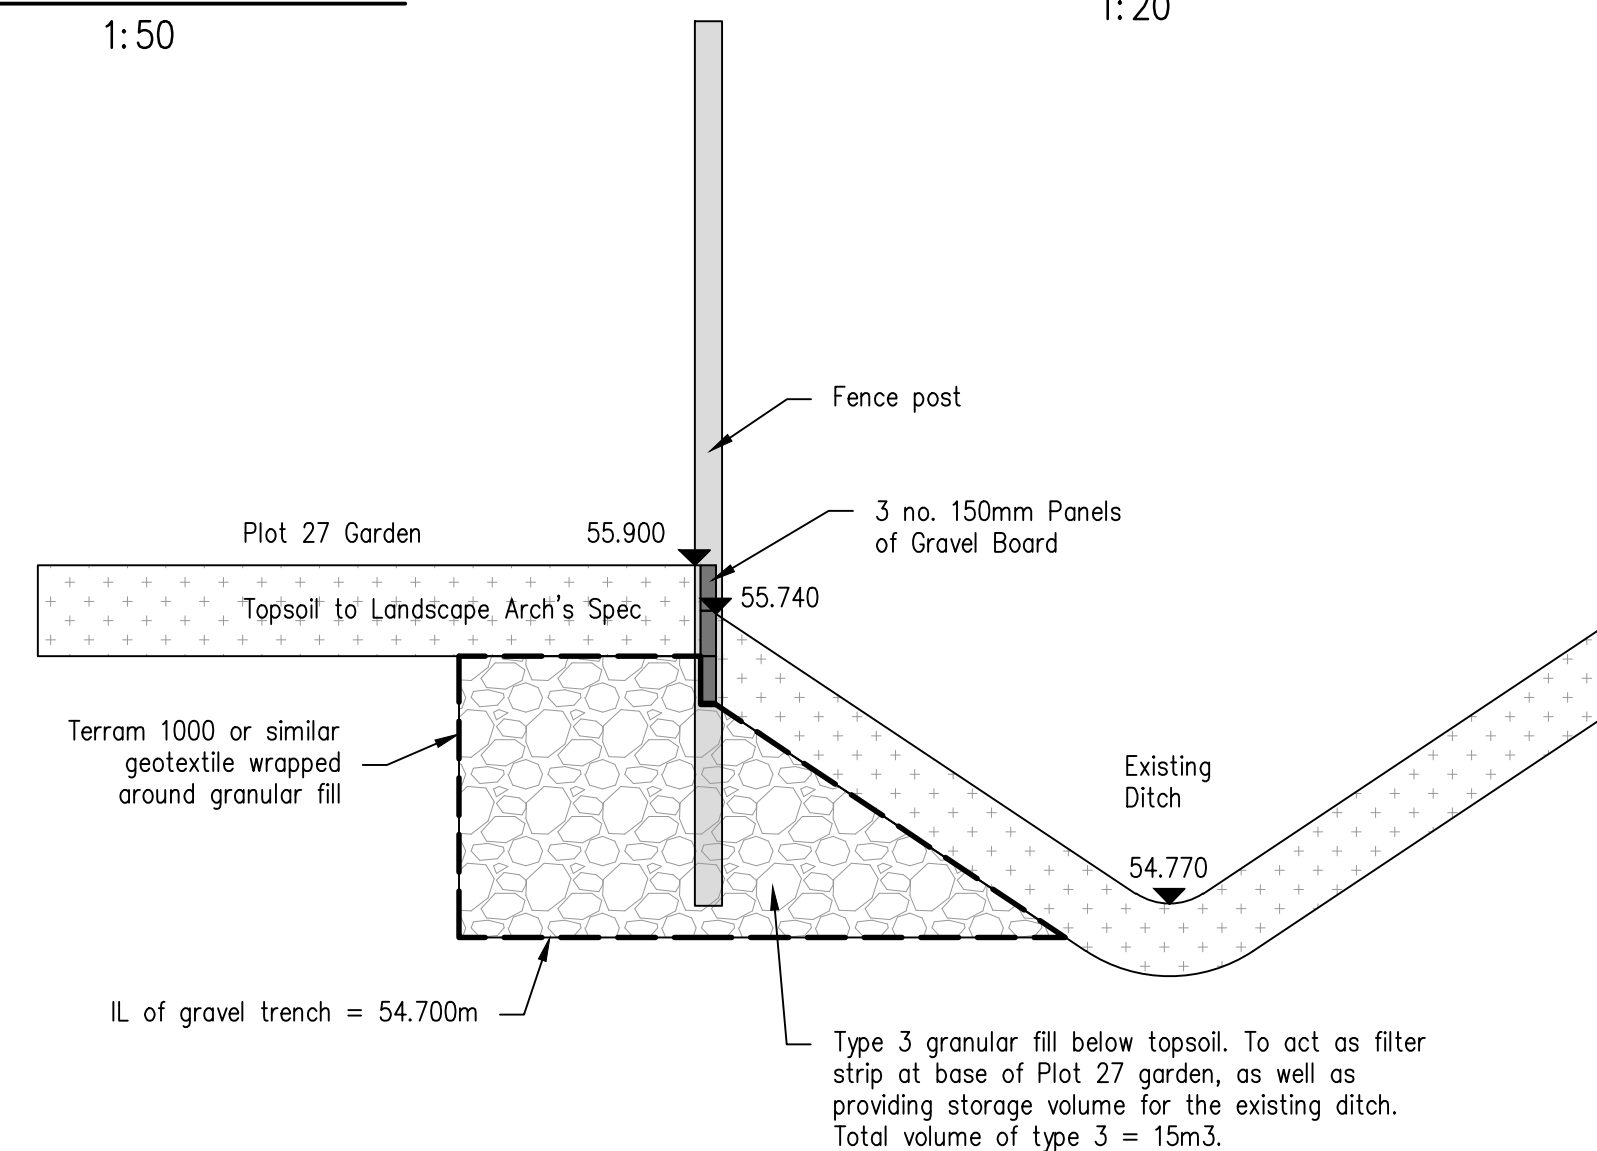


Plot 27 French Drain Detail
1:25

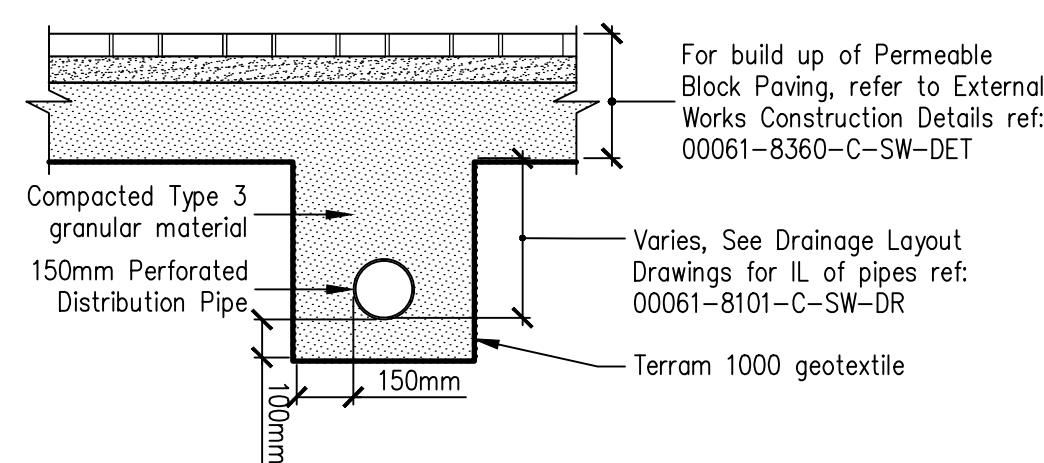


Permeable Block Paving Carrier Pipe Detail
1:20

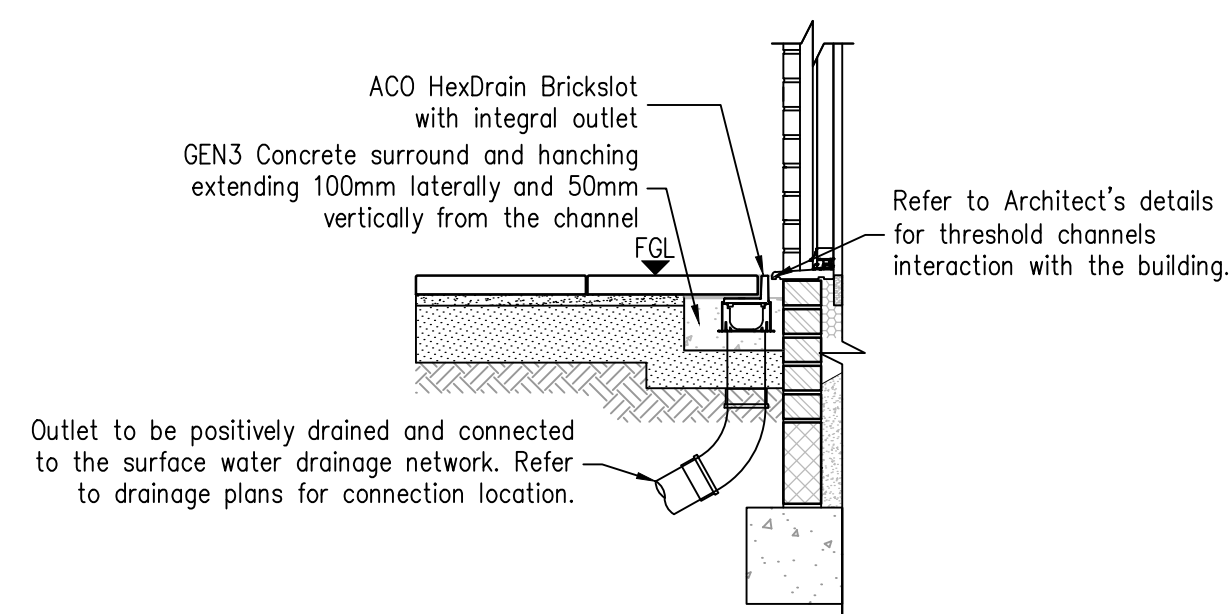


ACO HEXDrain Brickslot Front Threshold Drainage Channel Detail
1:20

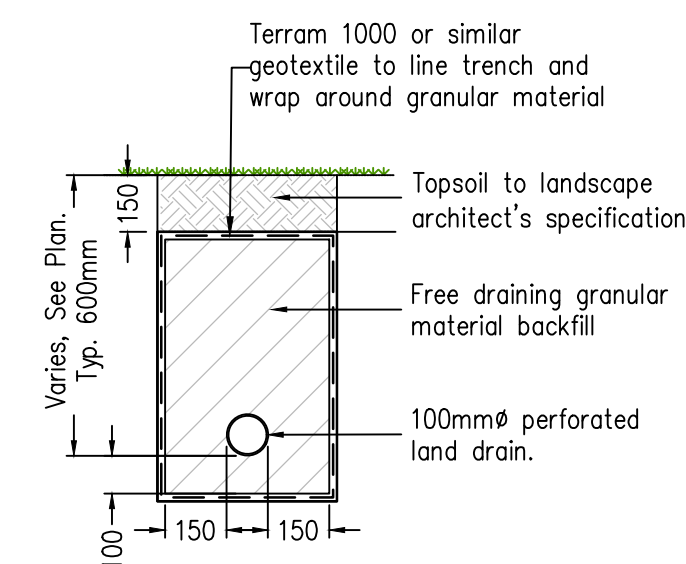


Land Drain Detail
1:20

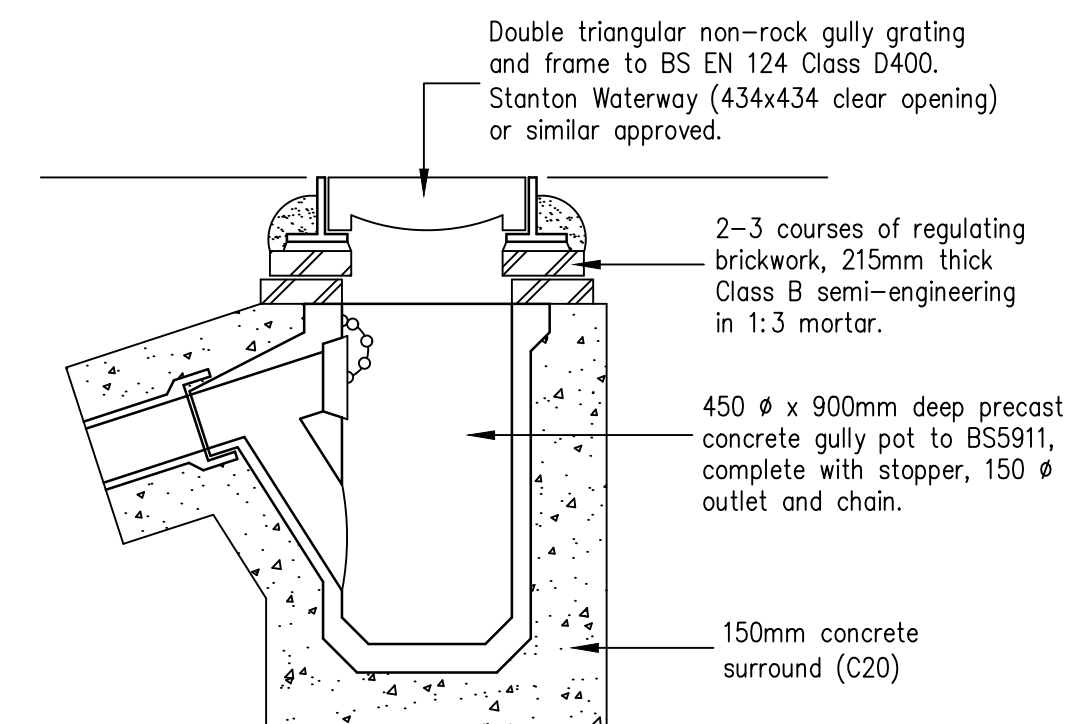

Gully Detail
1:20

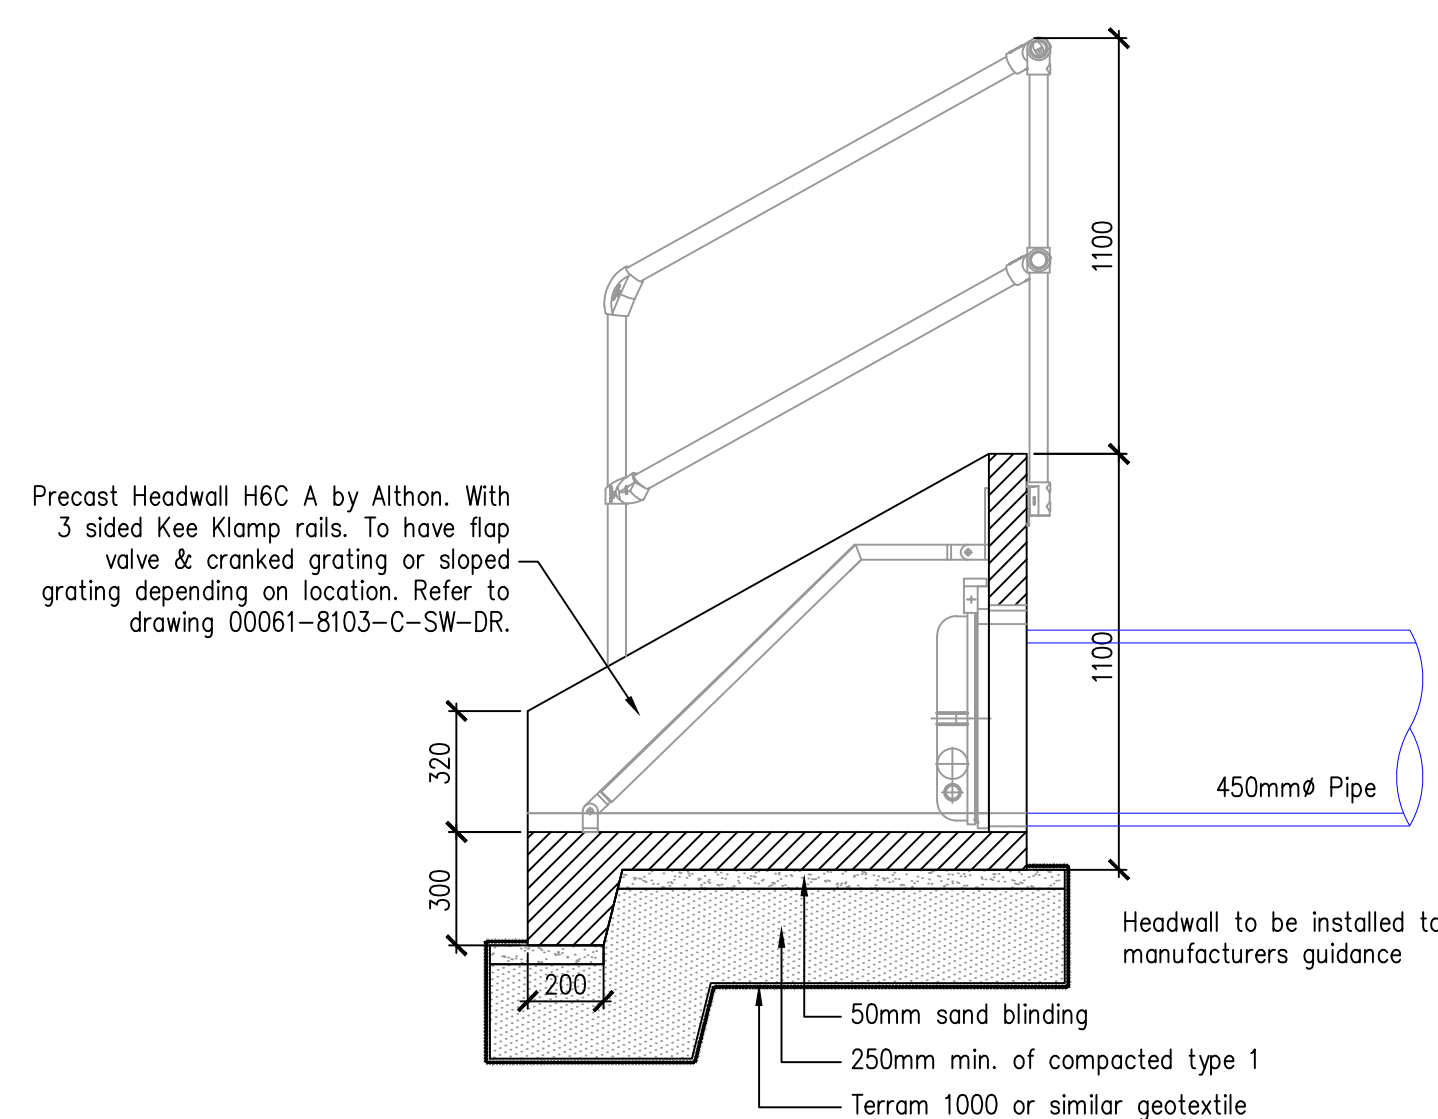

H6C A Headwall Detail
1:20

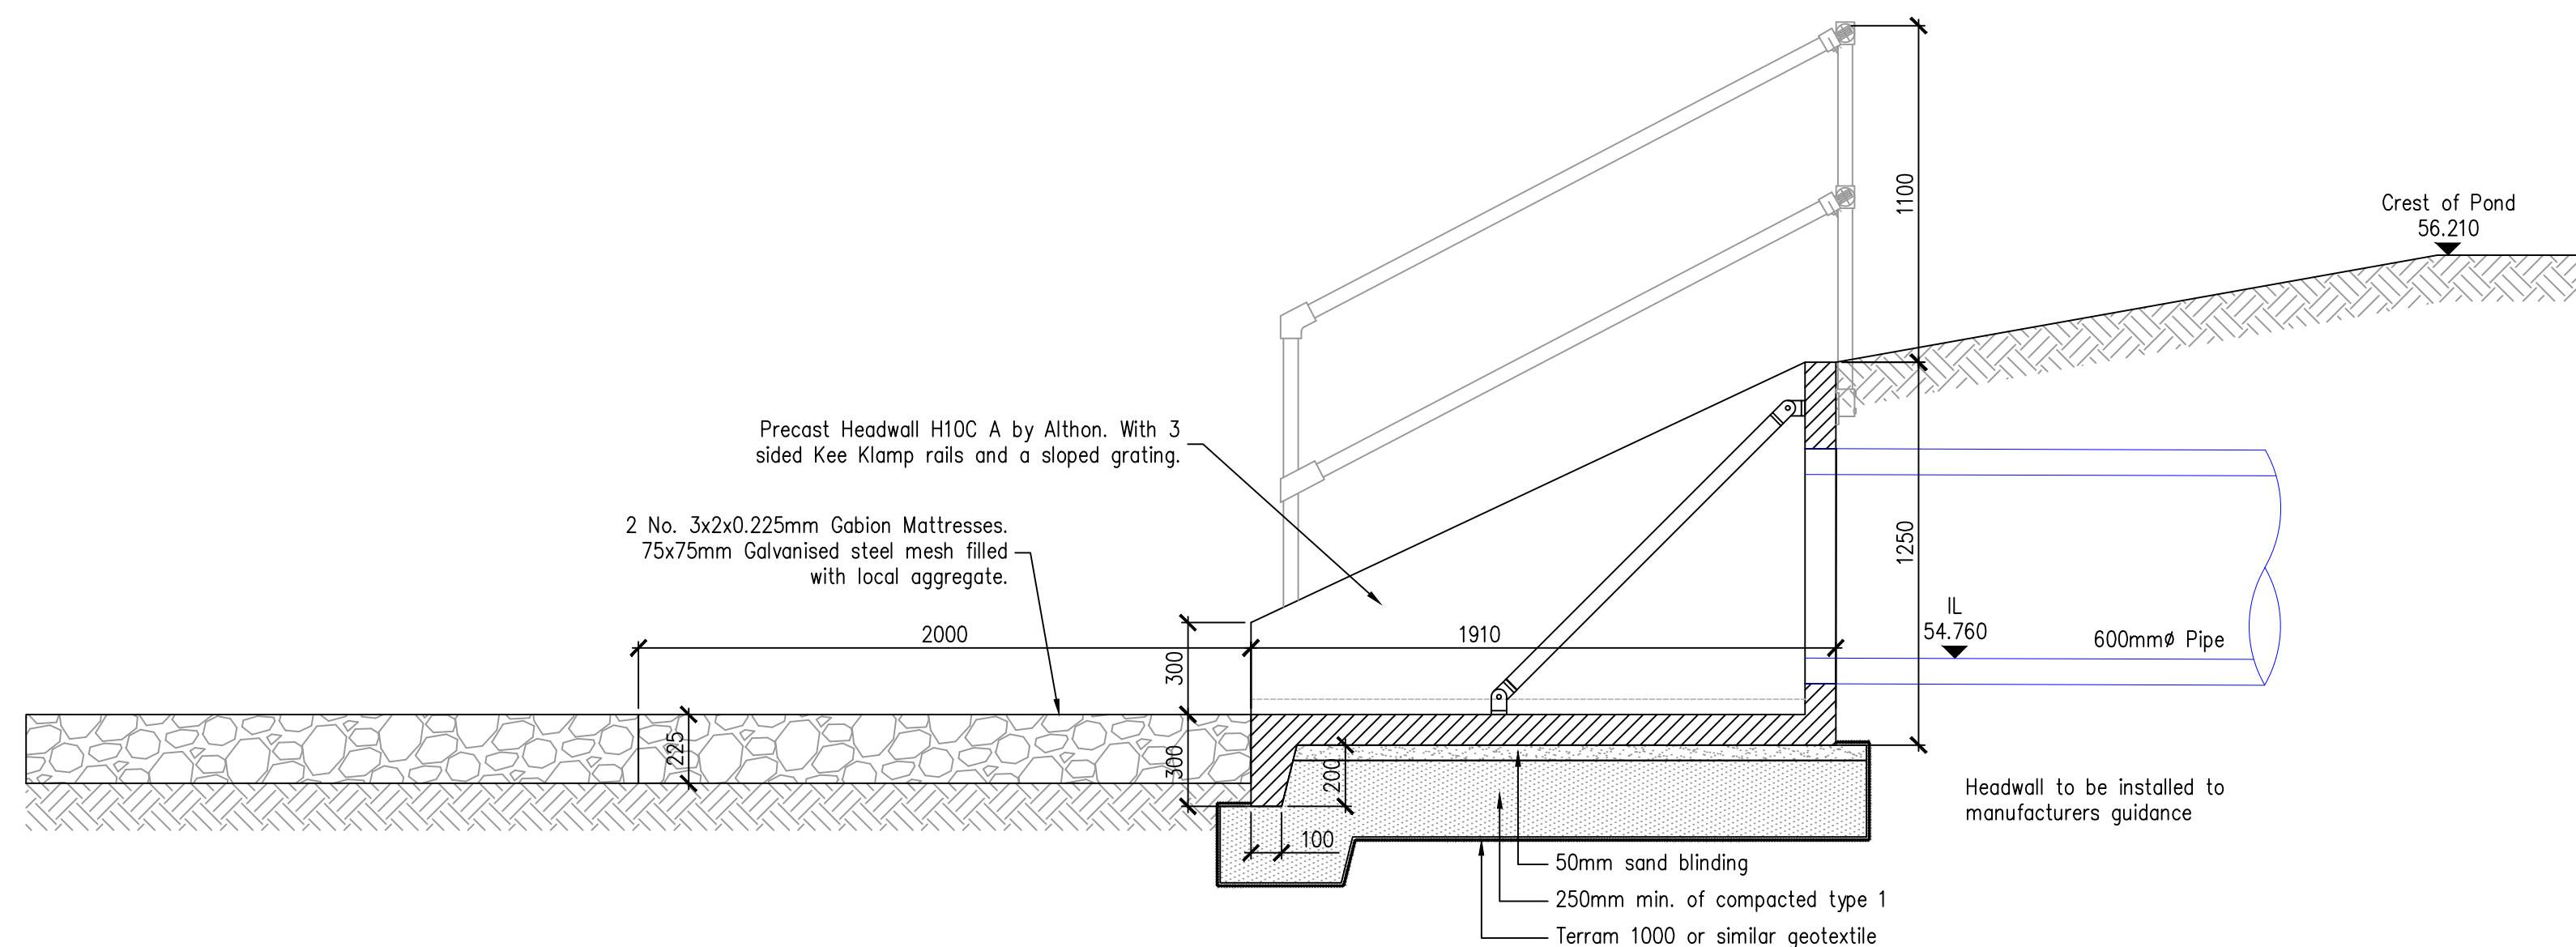

H10C A Headwall Section
1:20

Notes:

- Do not scale from this drawing.
- In case of any discrepancies in drawings, details or bills, refer to engineers for clarification: unilateral decisions by the Contractor will not be accepted.
- This drawing is to be read in conjunction with all related Architects, Consultants & Sub-Contractors drawings and specifications.
- The Contractor is advised that all design drawings and information are to be read concurrently and any discrepancies or omissions reported directly to PTA's Civil Engineering Department.

THIS IS A 'RECORD DRAWING'. IT IS THE ISSUE OF A CONSTRUCTION DRAWING, WHICH INCLUDES THE INFORMATION THAT THE CONTRACTOR HAS SUPPLIED FORMALLY TO PTA TO SHOW THE CONTRACTOR'S "AS-BUILT" INFORMATION. THIS INFORMATION HAS NOT BEEN VERIFIED BY PTA. PTA HAVE RELIED UPON THE CONTRACTORS OBLIGATION TO CONSTRUCT GENERALLY IN ACCORDANCE WITH PTA'S DESIGN.

© Powell Tolner & Associates Ltd.

The contents of this drawing may not be reproduced in whole or in part without the prior written permission of Powell Tolner & Associates.

DRAWING STATUS

FOR CONSTRUCTION

REV	DESCRIPTION	BY	DATE	CHK'D
C03	Record Issue	TA	25.11.24	AH
C02	Land Drain Detail Added	TA	28.02.24	AH
C01	Issued for Construction	TA	21.12.22	AH
P02	Details Added	TA	28.02.22	AH
P01	First Issue	SBH	22.10.21	TA

DATE	DRAWN	CHECKED DO	CHECKED ENG	PTA PROJ No
Oct/2021	TA	TA	AH	9607
SCALE	DRG SIZE	REVISION		
As Shown	A1	C03		

PROJECT TITLE

Bedford Road, Ickleford
Hertfordshire

Drainage Construction Details
Sheet 2 of 2

DATE	DRAWN	CHECKED DO	CHECKED ENG	PTA PROJ No
Oct/2021	TA	TA	AH	9607
SCALE	DRG SIZE	REVISION		
As Shown	A1	C03		

00061-8132 -C- SW -DET

Consulting Civil & Structural Engineers

pta
29 Red Lion Street
Chesham
Bucks.
HP5 1EJ
Tel. 01494 772721

www.ptaconsult.co.uk