


SURFACE WATER MANHOLE SCHEDULE										
MANHOLE NAME	COVER LEVEL [m AOD]	INVERT LEVEL [m AOD]	MANHOLE DEPTH [m]	SUMP DEPTH [m]	INTERNAL DIMENSIONS [m]	EASTINGS [m]	NORTHINGS [m]	COVER SIZE [mm]	COVER GRADE	MANHOLE TYPE
SW43	59.821	59.050 59.100 IN 59.100 IN 59.050 OUT	0.771	0.000	0.450ø	517684.601	231109.350	450x450 Recessed	B125	PIC
SW44	59.378	58.450 58.450 IN 58.500 IN 58.500 IN 58.500 IN 58.450 OUT	0.928	0.000	0.450ø	517692.708	231086.717	450x450 Recessed	B125	PIC
SW45	59.194	56.900 56.900 IN 57.125 IN 56.900 OUT	2.294	0.000	1.200ø	517690.870	231081.427	600x600	D400	PC Ring
SW46	58.481	57.800 57.800 IN 57.800 IN 57.800 OUT	0.681	0.000	0.450ø	517688.077	231067.694	450x450	D400	PIC
SW47	57.847	57.025 57.025 IN 57.025 IN 57.025 OUT	0.822	0.000	0.450ø	517694.173	231049.908	450x450 Recessed	B125	PIC
SW48	58.107	56.875 56.875 IN 56.875 IN 56.875 IN 56.875 IN 56.875 OUT	1.232	0.000	0.450ø	517687.668	231060.979	450x450 Recessed	B125	PIC
SW49	58.211	56.400 56.675 IN 56.675 IN 56.400 IN 56.400 OUT	1.811	0.000	1.200ø	517684.081	231063.785	600x600	D400	PC Ring
SW50	57.160	56.450 56.500 IN 56.450 OUT	0.710	0.000	0.450ø	517671.849	231022.811	450x450	A15	PIC
SW51	57.288	56.200 56.200 IN 56.250 IN 56.200 OUT	1.088	0.000	0.450ø	517661.638	231045.333	450x450 Recessed	B125	PIC
SW52	56.744	56.025 56.075 IN 56.025 OUT	0.719	0.000	0.450ø	517656.871	231015.142	450ø	A15	PIC
SW53	56.878	55.750 55.750 IN 55.800 IN 55.750 OUT	1.128	0.000	0.450ø	517645.749	231039.688	450x450	B125	PIC
SW54	57.008	55.625 55.700 IN 55.700 IN 55.625 OUT	1.383	0.000	0.600ø	517651.868	231042.257	600x600 (Restricted to 350ø)	D400	PIC
SW55	56.998	55.375 55.450 IN 55.600 IN 55.375 OUT	1.623	0.000	1.350ø	517650.115	231046.410	600x600	D400	PC Ring
SW56	56.772	55.334 55.700 IN 55.700 IN 55.334 IN 55.700 OUT	1.439	0.000	0.450ø	517624.471	231035.309	450ø	B125	PIC
SW57	56.748	55.110 55.410 IN 55.260 IN 55.110 OUT	1.638	0.000	1.500ø	517613.744	231037.880	600x600	D400	PC Ring
SW58	56.629	55.700 55.700 IN 55.700 OUT	0.929	0.000	0.450ø	517616.996	231026.998	450ø	B125	PIC
SW59	56.316	55.575 55.575 IN 55.575 IN 55.575 IN 55.575 IN 55.575 OUT	0.741	0.000	0.450ø	517606.748	231022.493	450ø	B125	PIC
SW60	56.248	55.700 55.700 IN 55.700 IN 55.700 IN 55.700 IN 55.700 OUT	0.548	0.000	0.450ø	517594.940	231017.731	450ø	B125	PIC
SW61	56.370	55.035 55.035 IN 55.555 IN 55.035 OUT	1.335	0.000	1.500ø	517602.319	231025.642	600x600 Recessed	B125	PC Ring
SW61b	56.229	55.700 55.700 IN 55.700 IN 55.700 IN 55.700 OUT	0.529	0.000	0.450ø	517598.955	231020.623	450x450 Recessed	B125	PIC
SW62	56.150	54.935 54.935 IN 55.435 IN 54.935 OUT	1.215	0.000	1.500ø	517600.758	230994.825	600x600	B125	PC Ring

SURFACE WATER MANHOLE SCHEDULE										
MANHOLE NAME	COVER LEVEL [m AOD]	INVERT LEVEL [m AOD]	MANHOLE DEPTH [m]	SUMP DEPTH [m]	INTERNAL DIMENSIONS [m]	EASTINGS [m]	NORTHINGS [m]	COVER SIZE [mm]	COVER GRADE	MANHOLE TYPE
SW63	56.210	54.875 54.875 IN 54.875 OUT	1.335	0.000	1.500ø	517584.670	230984.597	600x600	D400	PC Ring
SW64	56.000	54.310 54.810 IN 54.810 OUT	1.690	0.500	1.500ø	517589.947	230965.113	600x600	D400	PC Ring Catchpit
SW65	55.770	54.190 54.690 IN 54.690 OUT	1.580	0.500	1.350ø	517574.478	230922.572	600x600	D400	PC Ring Flow Control

Notes:

- Do not scale from this drawing.
- In case of any discrepancies in drawings, details or bills, refer to engineers for clarification: unilateral decisions by the Contractor will not be accepted.
- This drawing is to be read in conjunction with all related Architects, Consultants & Sub-Contractors drawings and specifications.
- The Contractor is advised that all design drawings and information are to be read concurrently and any discrepancies or omissions reported directly to PTA's Civil Engineering Department.

THIS IS A 'RECORD DRAWING'. IT IS THE ISSUE OF A CONSTRUCTION DRAWING, WHICH INCLUDES THE INFORMATION THAT THE CONTRACTOR HAS SUPPLIED FORMALLY TO PTA TO SHOW THE CONTRACTOR'S "AS-BUILT" INFORMATION. THIS INFORMATION HAS NOT BEEN VERIFIED BY PTA. PTA HAVE RELIED UPON THE CONTRACTORS OBLIGATION TO CONSTRUCT GENERALLY IN ACCORDANCE WITH PTA'S DESIGN.

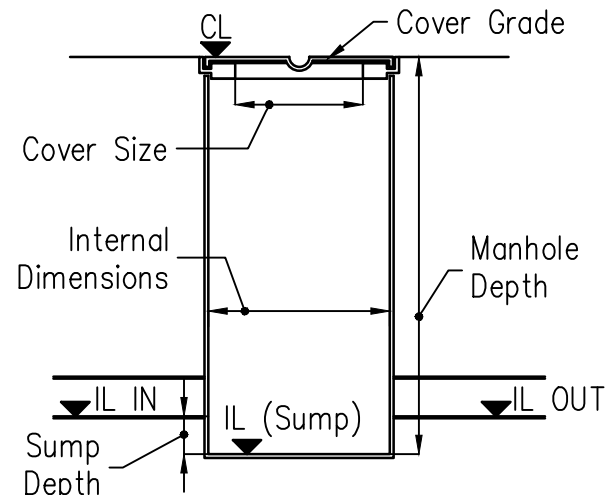

Manhole Schedule
Explanatory Detail

© Powell Tolner & Associates Ltd.
The contents of this drawing may not be reproduced in whole or in part without the prior written permission of Powell Tolner & Associates.

DRAWING STATUS
FOR CONSTRUCTION

C03	Record Issue	TA	25.11.24	AH
C02	Updated to Revised Layout of Plot 25-27	TA	15.06.23	AH
C01	Issued for Construction	TA	21.12.22	AH
P03	Clouded Manholes Updated	TA	08.09.22	AH
P02	Updated to Revised Drainage Layout	TA	13.05.22	AH
P01	First Issue	TA	08.04.22	AH

REV	DESCRIPTION	BY	DATE	CHK'D

PROJECT TITLE
**Bedford Road, Ickleford
Hertfordshire**

DRAWING TITLE
**Surface Water Manhole
Schedule Sheet 2 of 2**

DATE	Apr 2022	CHECKED DO	CHECKED ENG	PTA PROJ No
DRAWN	TA	TA	AH	9607
SCALE	N/A			
DWG SIZE	A1			
				REVISION
				C03

DRAWING No
00061 -8152 -C- SW - DR

Consulting Civil & Structural Engineers

pta

29 Red Lion Street
Chesham
Bucks.
HP5 1EJ
Tel. 01494 772721

www.ptaconsult.co.uk