


FOUL WATER MANHOLE SCHEDULE									
MANHOLE NAME	COVER LEVEL [m AOD]	INVERT LEVEL [m AOD]	MANHOLE DEPTH [m]	INTERNAL DIMENSIONS [m]	EASTINGS [m]	NORTHINGS [m]	COVER SIZE [mm]	COVER GRADE	MANHOLE TYPE
FW82	59.795	59.125 59.125 IN 59.125 IN 59.125 OUT	0.670	0.300ø	517767.332	231106.720	300ø	A15	PIC
FW83	59.796	59.125 59.125 IN 59.125 IN 59.125 OUT	0.671	0.300ø	517764.592	231105.197	300ø	A15	PIC
FW84	59.797	59.125 59.125 IN 59.125 IN 59.125 OUT	0.672	0.300ø	517763.273	231104.603	300ø	A15	PIC
FW85	59.824	59.125 59.125 IN 59.125 IN 59.125 OUT	0.699	0.300ø	517760.733	231102.318	300ø	A15	PIC
FW86	59.552	58.300 58.300 IN 58.300 IN 58.300 IN 58.300 OUT	1.252	0.450ø	517767.949	231111.774	450x450	D400	PIC
FW87	59.623	59.000 59.000 IN 59.000 IN 59.000 IN 59.000 OUT	0.623	0.450ø	517785.038	231086.862	450x450	D400	PIC

- Notes:**
- Do not scale from this drawing.
 - In case of any discrepancies in drawings, details or bills, refer to engineers for clarification: unilateral decisions by the Contractor will not be accepted.
 - This drawing is to be read in conjunction with all related Architects, Consultants & Sub-Contractors drawings and specifications.
 - The Contractor is advised that all design drawings and information are to be read concurrently and any discrepancies or omissions reported directly to PTA's Civil Engineering Department.

THIS IS A 'RECORD DRAWING'. IT IS THE ISSUE OF A CONSTRUCTION DRAWING, WHICH INCLUDES THE INFORMATION THAT THE CONTRACTOR HAS SUPPLIED FORMALLY TO PTA TO SHOW THE CONTRACTOR'S "AS-BUILT" INFORMATION. THIS INFORMATION HAS NOT BEEN VERIFIED BY PTA. PTA HAVE RELIED UPON THE CONTRACTORS OBLIGATION TO CONSTRUCT GENERALLY IN ACCORDANCE WITH PTA'S DESIGN.

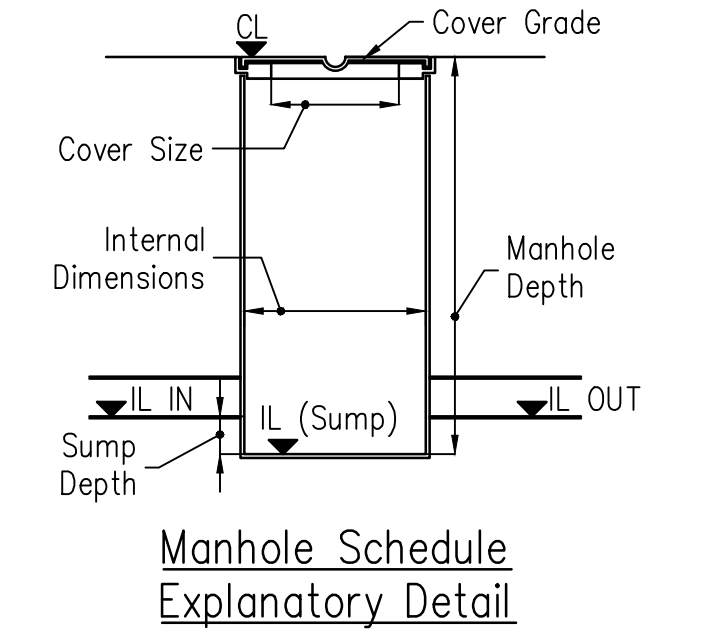

© Powell Tolner & Associates Ltd.
The contents of this drawing may not be reproduced in whole or in part without the prior written permission of Powell Tolner & Associates.

DRAWING STATUS

FOR CONSTRUCTION

C02	Record Issue	TA	25.11.24	AH
C01	Issued for Construction	TA	21.12.22	AH
P03	Clouded Chambers Updated	TA	08.09.22	AH
P02	Updated to Revised Drainage Layout	TA	13.05.22	AH
P01	First Issue	TA	08.04.22	AH
REV	DESCRIPTION	BY	DATE	CHK'D

PROJECT TITLE

Bedford Road, Ickleford
Hertfordshire

DRAWING TITLE

Foul Water Manhole Schedule
Sheet 3 of 3

DATE	Apr 2022	CHECKED DO	CHECKED ENG	PTA PROJ No
DRAWN	TA	TA	AH	9607
SCALE	N/A			REVISION
DWG SIZE	A1			C02

DRAWING No

00061-8163 -C- SW - DR

Consulting Civil & Structural Engineers



29 Red Lion Street
Chesham
Bucks.
HP5 1EJ
Tel. 01494 772721

www.ptaconsult.co.uk