




CAN BE SCALED FOR PLANNING PURPOSES ONLY
All dimensions to be verified on site

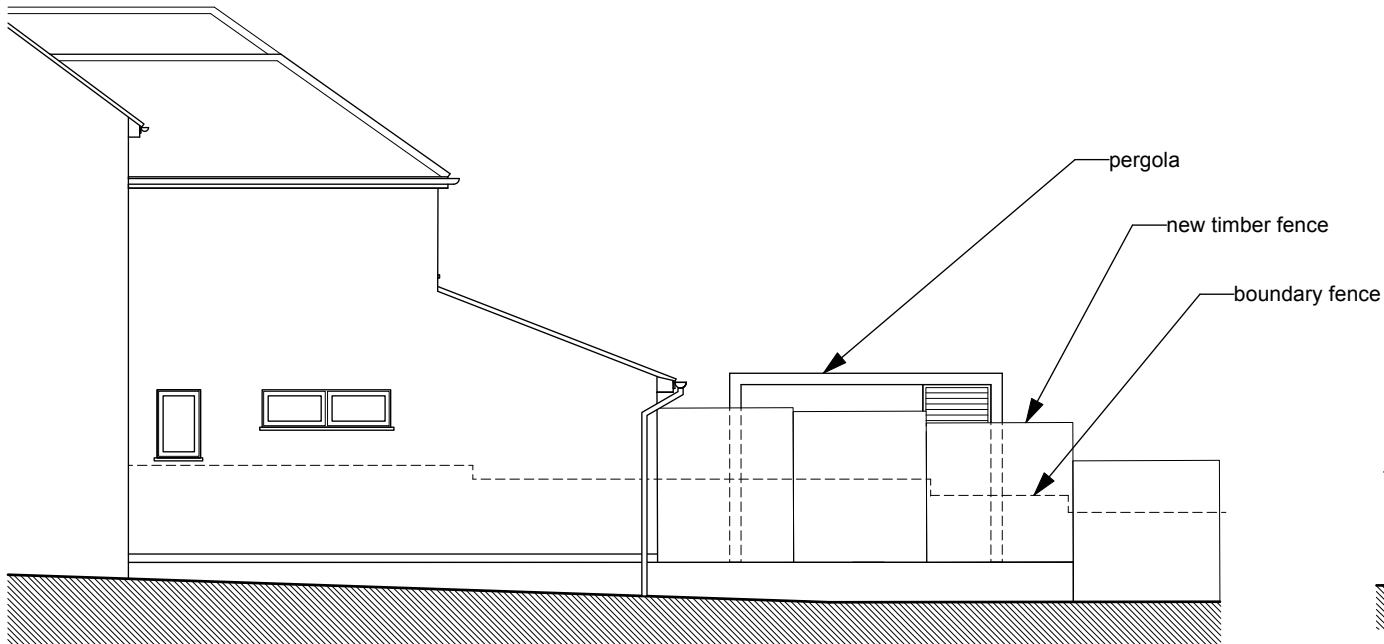


As-built East Elevation (1:100)

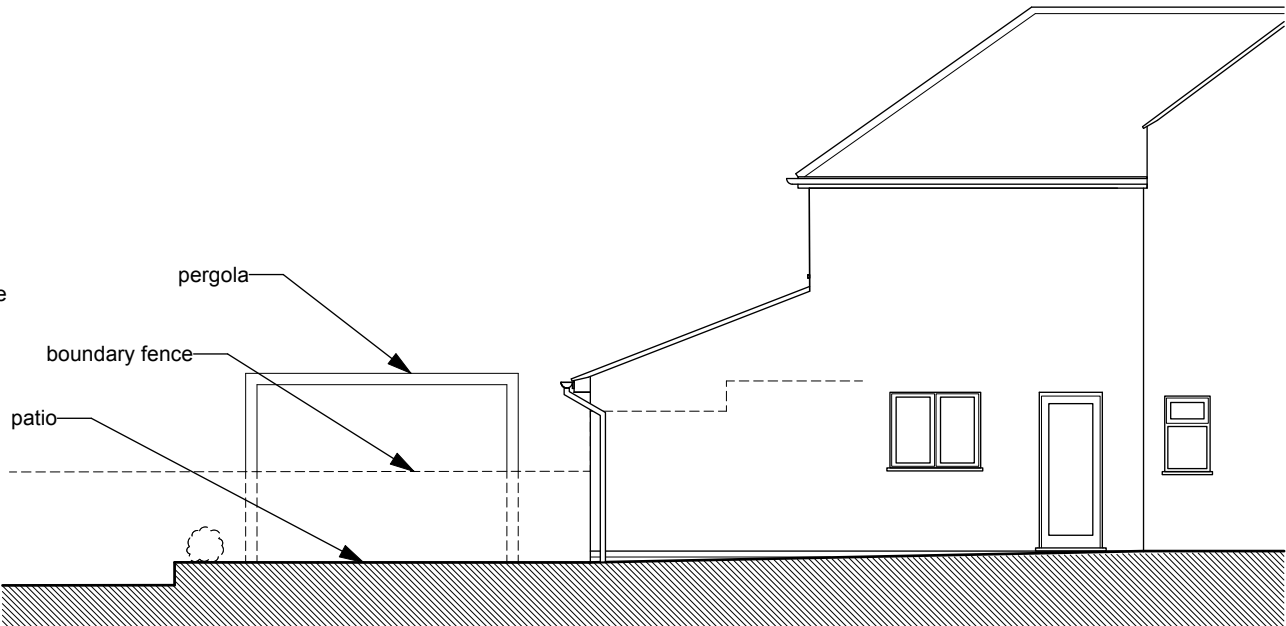

As-built West Elevation (1:100)

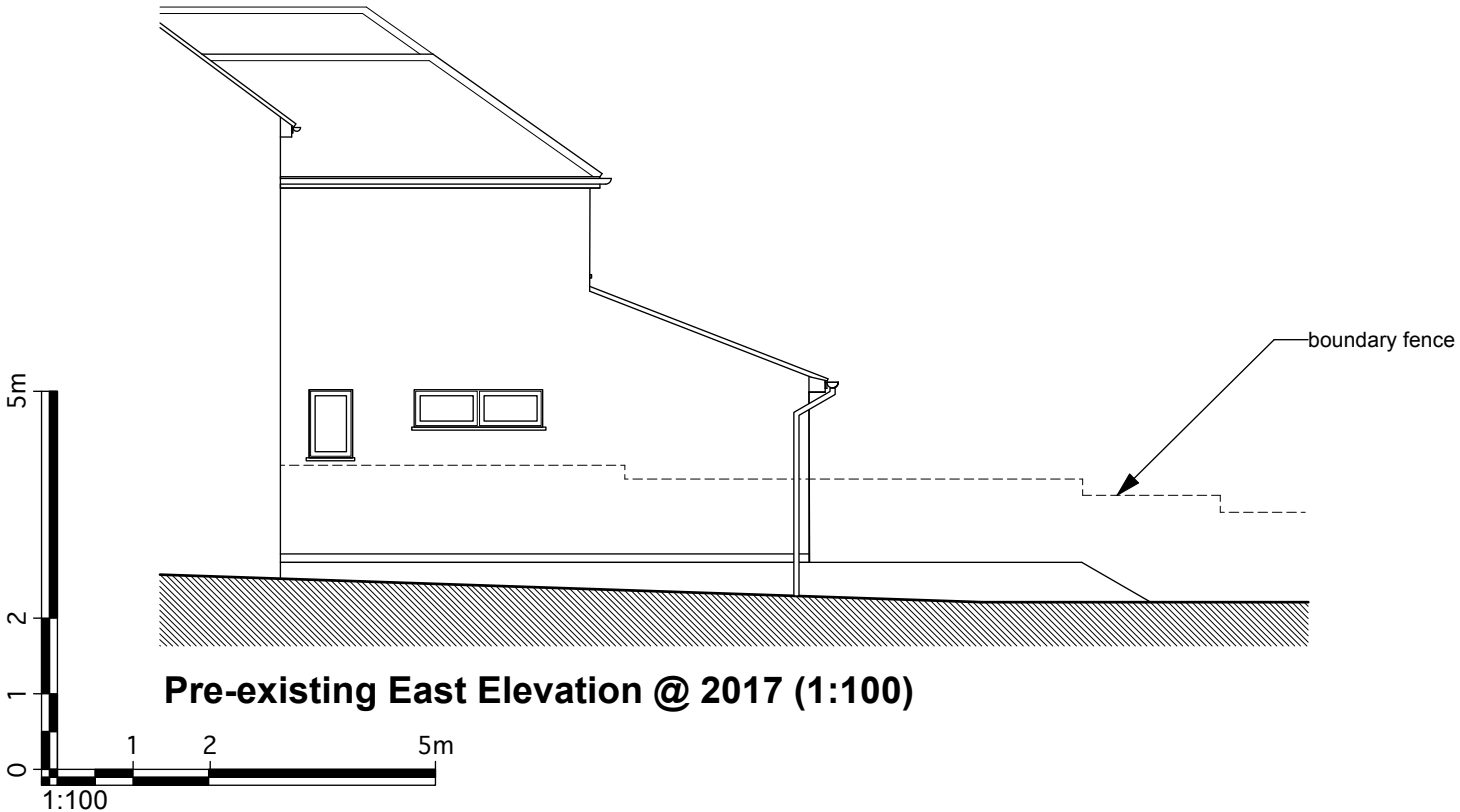

Pre-existing East Elevation @ 2017 (1:100)

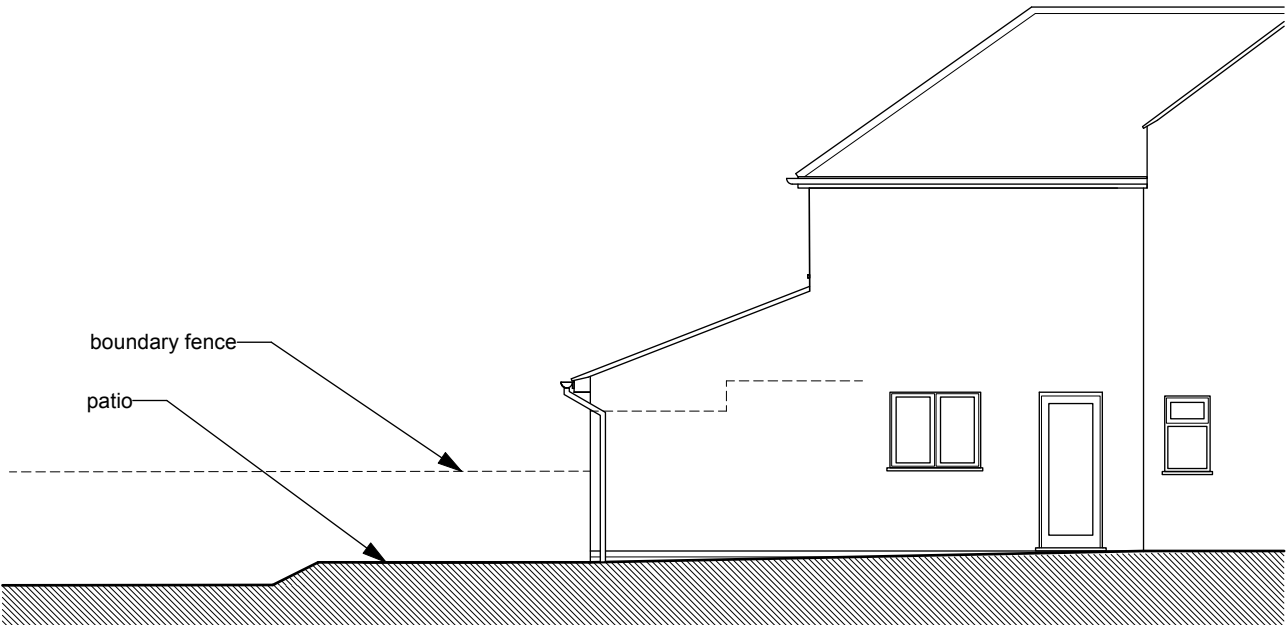

Pre-existing West Elevation @ 2017 (1:100)

FOR PLANNING APPLICATION PURPOSES ONLY

This drawing has been produced for Mr and Mrs Turner for the project/site named below and is submitted as part of a planning/permitted development application relating to this site name only and is not intended for use by any other person or organisation or for any other purpose.

revision	description	date	project 10 West Hill, Hitchin	title Pre-existing and As-Built Elevations 2
			job no. 372/2	dwg. no./rev/status PL005
			scale 1:100 @ A3	date August 2025
Nigel Cox Architects				
© Nigel Cox Architects 13 Mornington, Welwyn, Herts AL6 0AJ 07849 886755 nigelcoxarchitects@gmail.com				

© Nigel Cox Architects 13 Mornington Welwyn Herts AL6 0AJ 07849 886755 nigelcoxarchitects@gmail.com