




CAN BE SCALED FOR PLANNING PURPOSES ONLY
All dimensions to be verified on site

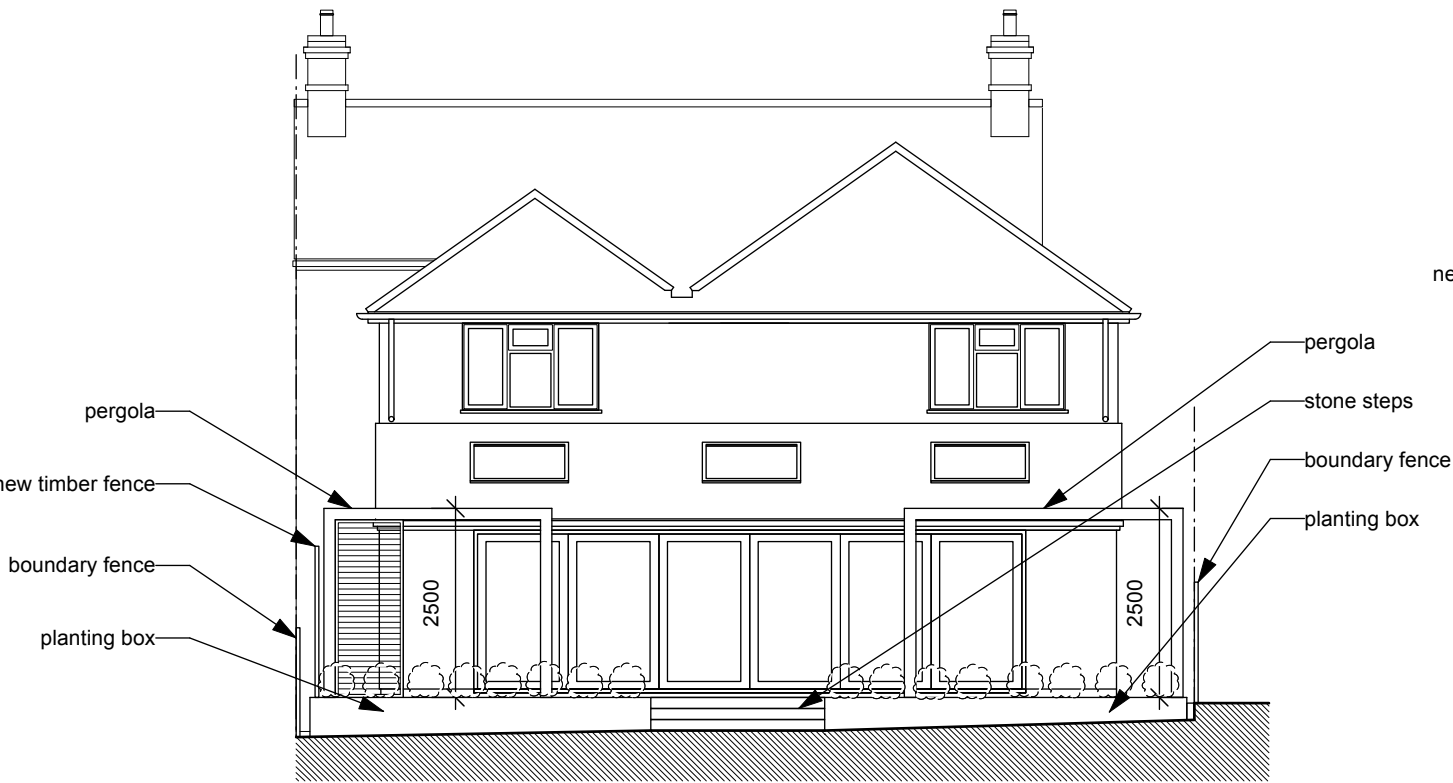


As-built North Elevation (1:100)

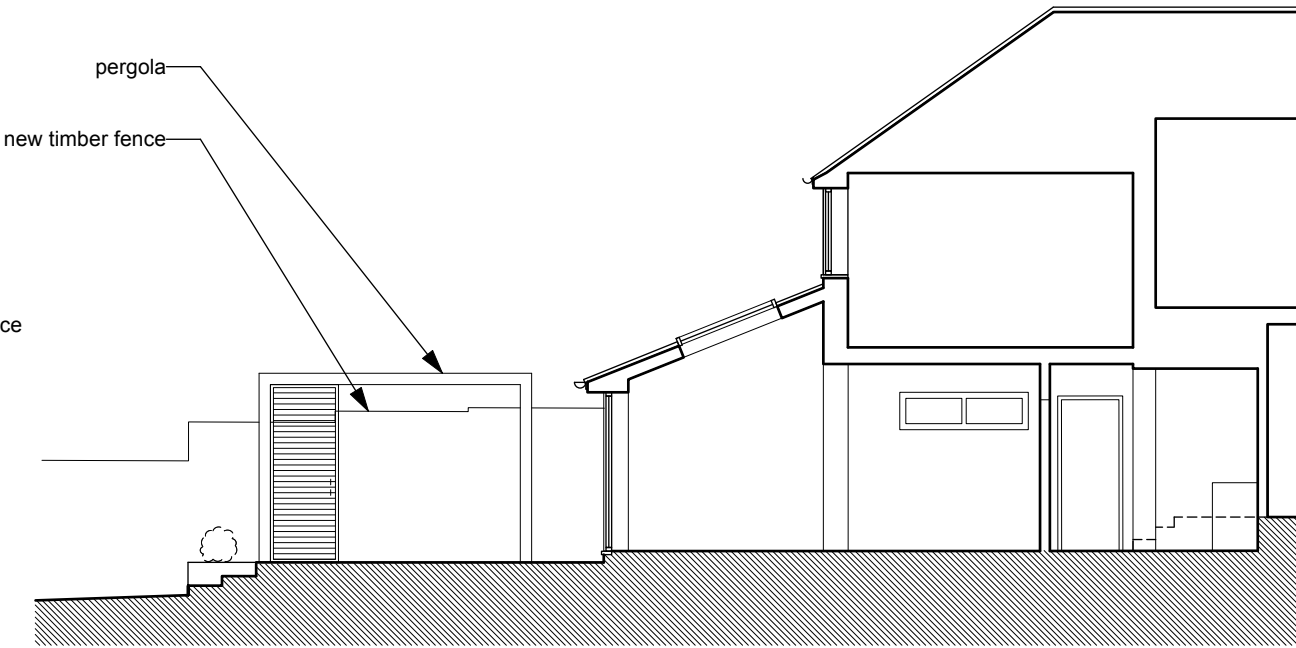

As-built Section through House and Patio (1:100)

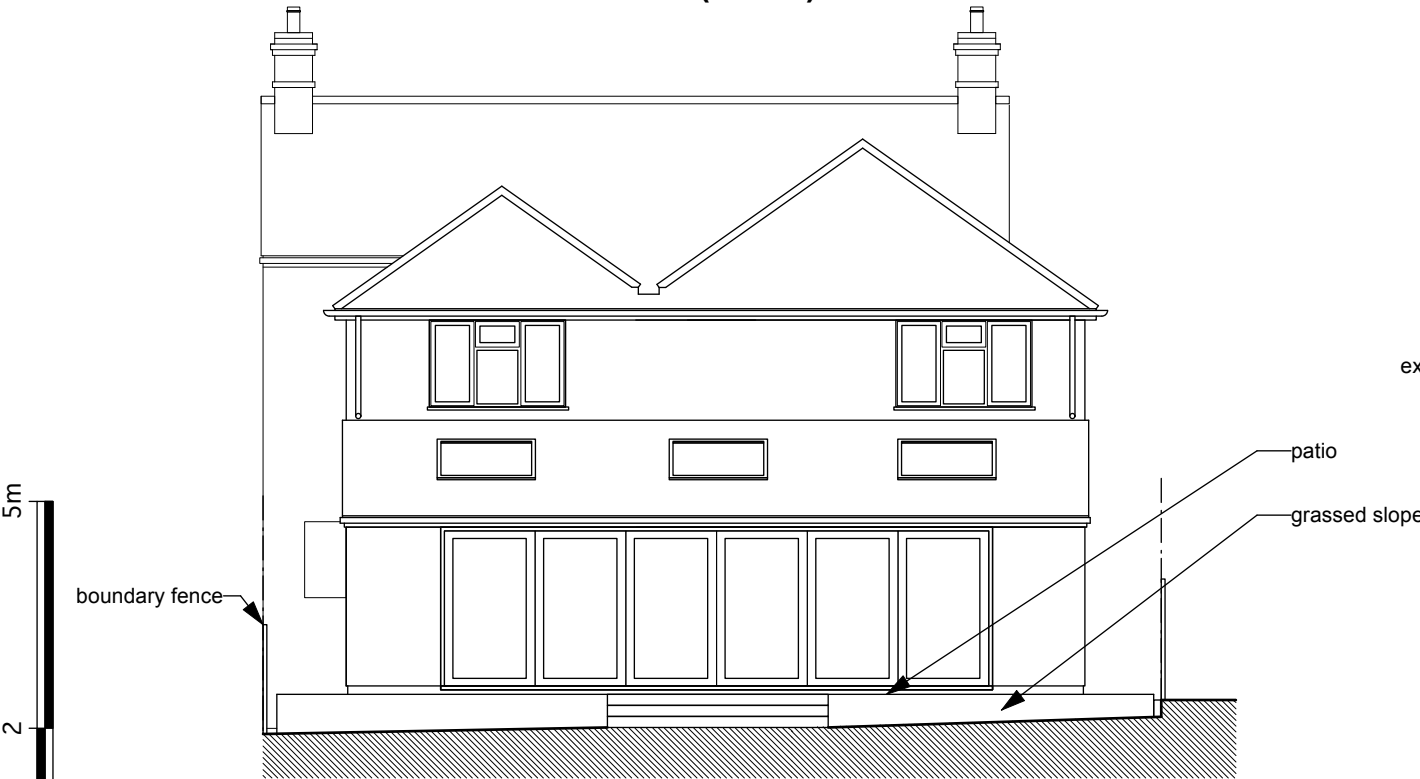

Pre-existing North Elevation @ 2017 (1:100)

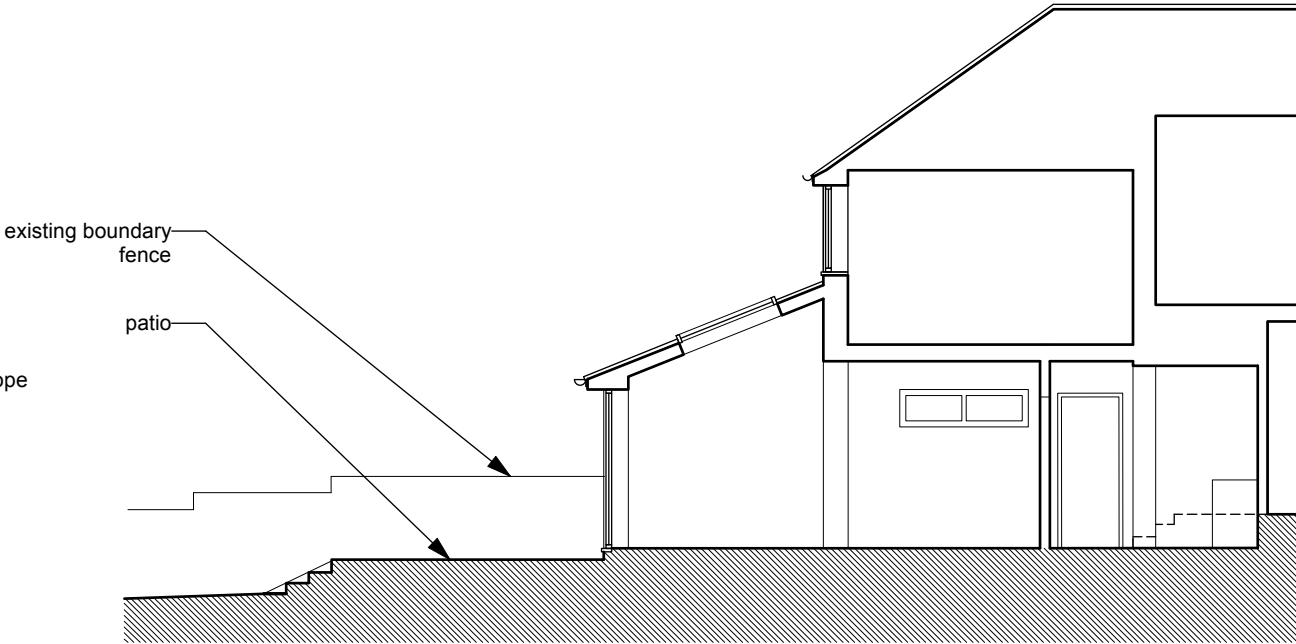

Pre-existing Section through House and Patio @ 2017 (1:100)

FOR PLANNING APPLICATION PURPOSES ONLY

This drawing has been produced for Mr and Mrs Turner for the project/site named below and is submitted as part of a planning/permitted development application relating to this site name only and is not intended for use by any other person or organisation or for any other purpose.

revision	description	date
----------	-------------	------

project	10 West Hill, Hitchin	title	Pre-existing and As-Built Elevations 1
job no.	372/2	dwg. no./rev/status	PL004
scale	1:100 @ A3	date	August 2025
Nigel Cox Architects			