




CAN BE SCALED FOR PLANNING PURPOSES ONLY
All dimensions to be verified on site

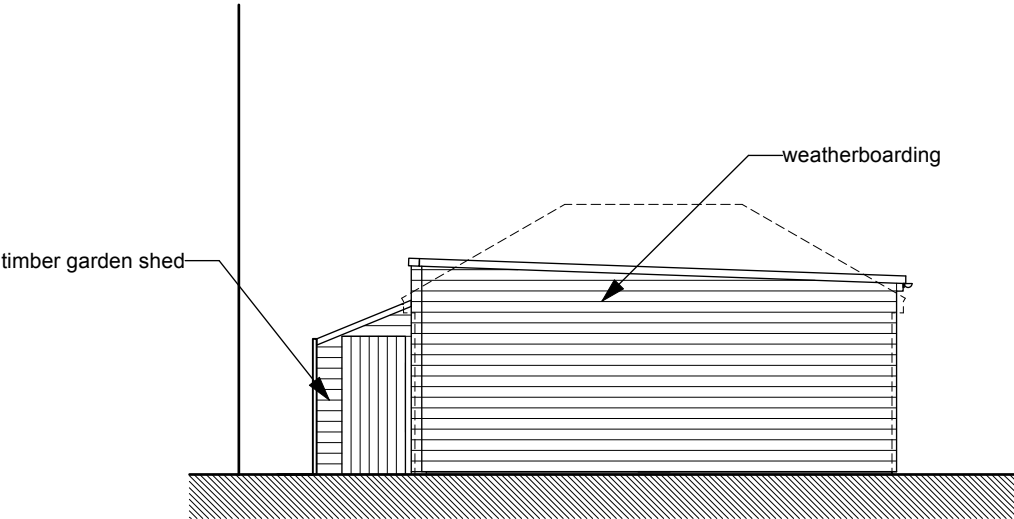


As-built West Elevation (1:100)

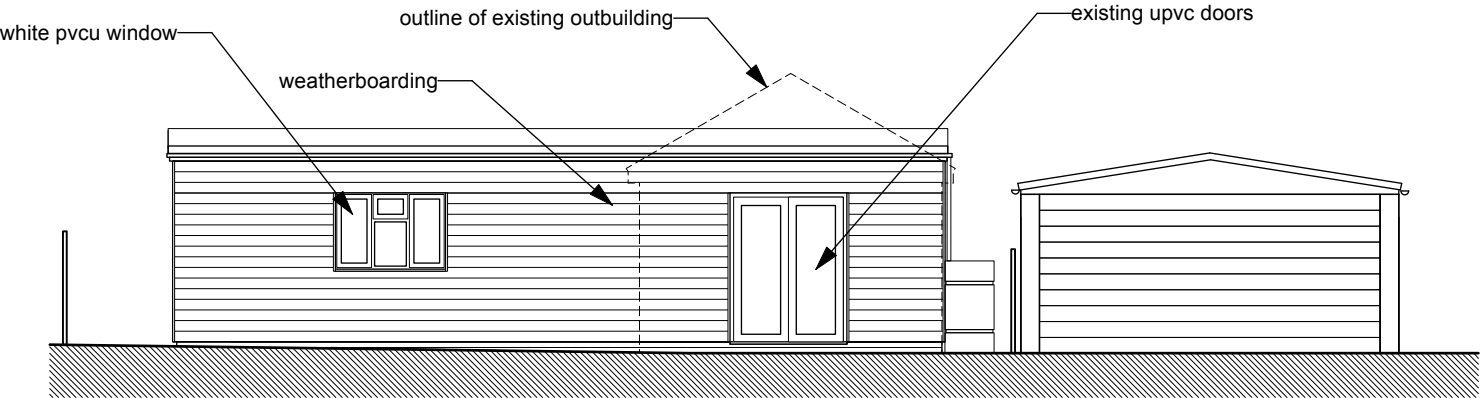


As-built South Elevation (1:100)

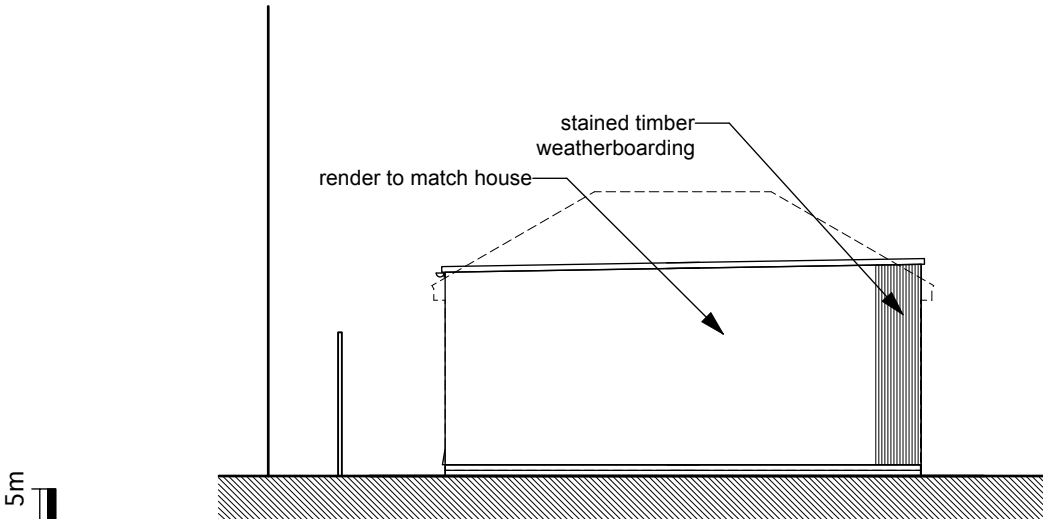

Pre-existing West Elevation (1:100)

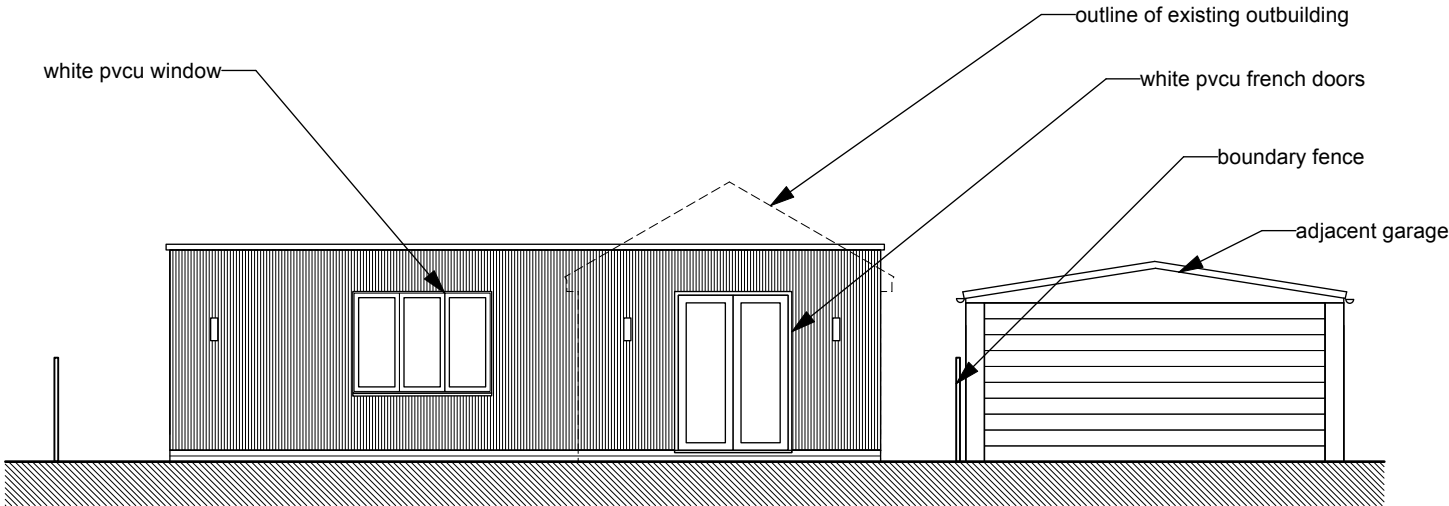

Pre-existing South Elevation (1:100)

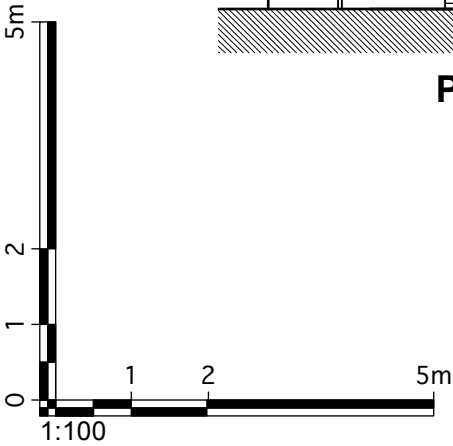

FOR PLANNING APPLICATION PURPOSES ONLY

This drawing has been produced for Mr and Mrs Turner for the project/site named below and is submitted as part of a planning/permitted development application relating to this site name only and is not intended for use by any other person or organisation or for any other purpose.

revision	description	date
----------	-------------	------

project	10 West Hill, Hitchin	title	Approved & As-built Elevations 2
job no.	372/3	dwg. no./rev/status	PL0006
scale	1:100 @ A3	date	August 2025

Nigel Cox Architects

© Nigel Cox Architects 13 Mornington Welwyn Herts AL6 0AJ 07849 886755 nigelcoxarchitects@gmail.com