


CAN BE SCALED FOR PLANNING PURPOSES ONLY  
All dimensions to be verified on site




As-built Front Elevation (1:100)

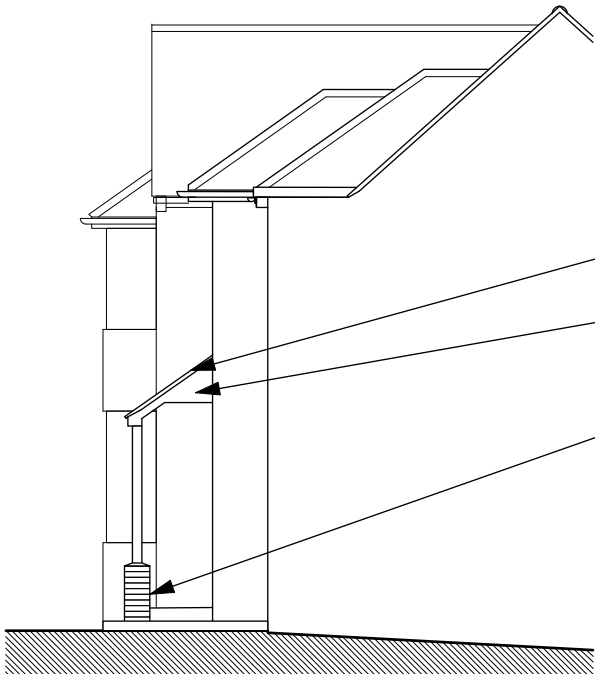

As-built Side Elevation (1:100)



Pre-existing Front Elevation (1:100)

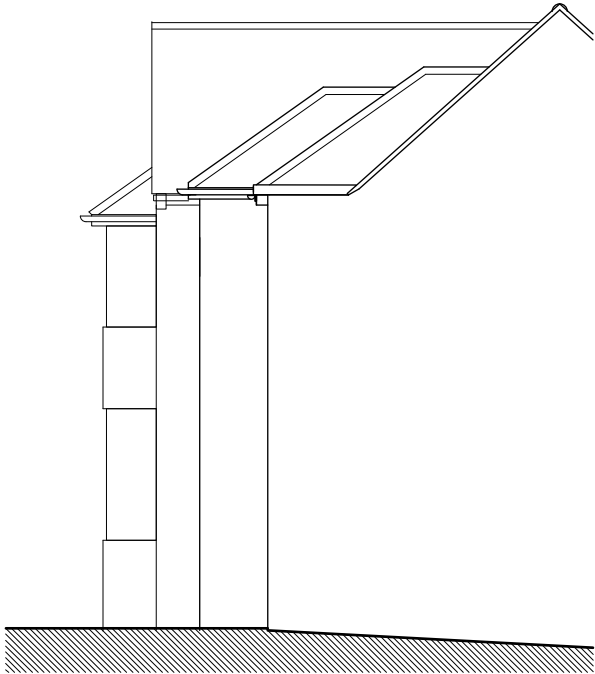

Pre-existing Side Elevation (1:100)

FOR PLANNING APPLICATION PURPOSES ONLY

This drawing has been produced for Mr and Mrs Turner for the project/site named below and is submitted as part of a planning/permitted development application relating to this site name only and is not intended for use by any other person or organisation or for any other purpose.

revision

description

date

project 10 West Hill, Hitchin

title Pre-existing and As-Built Elevations

job no. 372/4

dwg. no./rev/status PL004

scale 1:100 @ A3

date August 2025

Nigel Cox Architects

© Nigel Cox Architects 13 Mornington Welwyn Herts AL6 0AJ 07849 886755 nigelcoxarchitects@gmail.com