
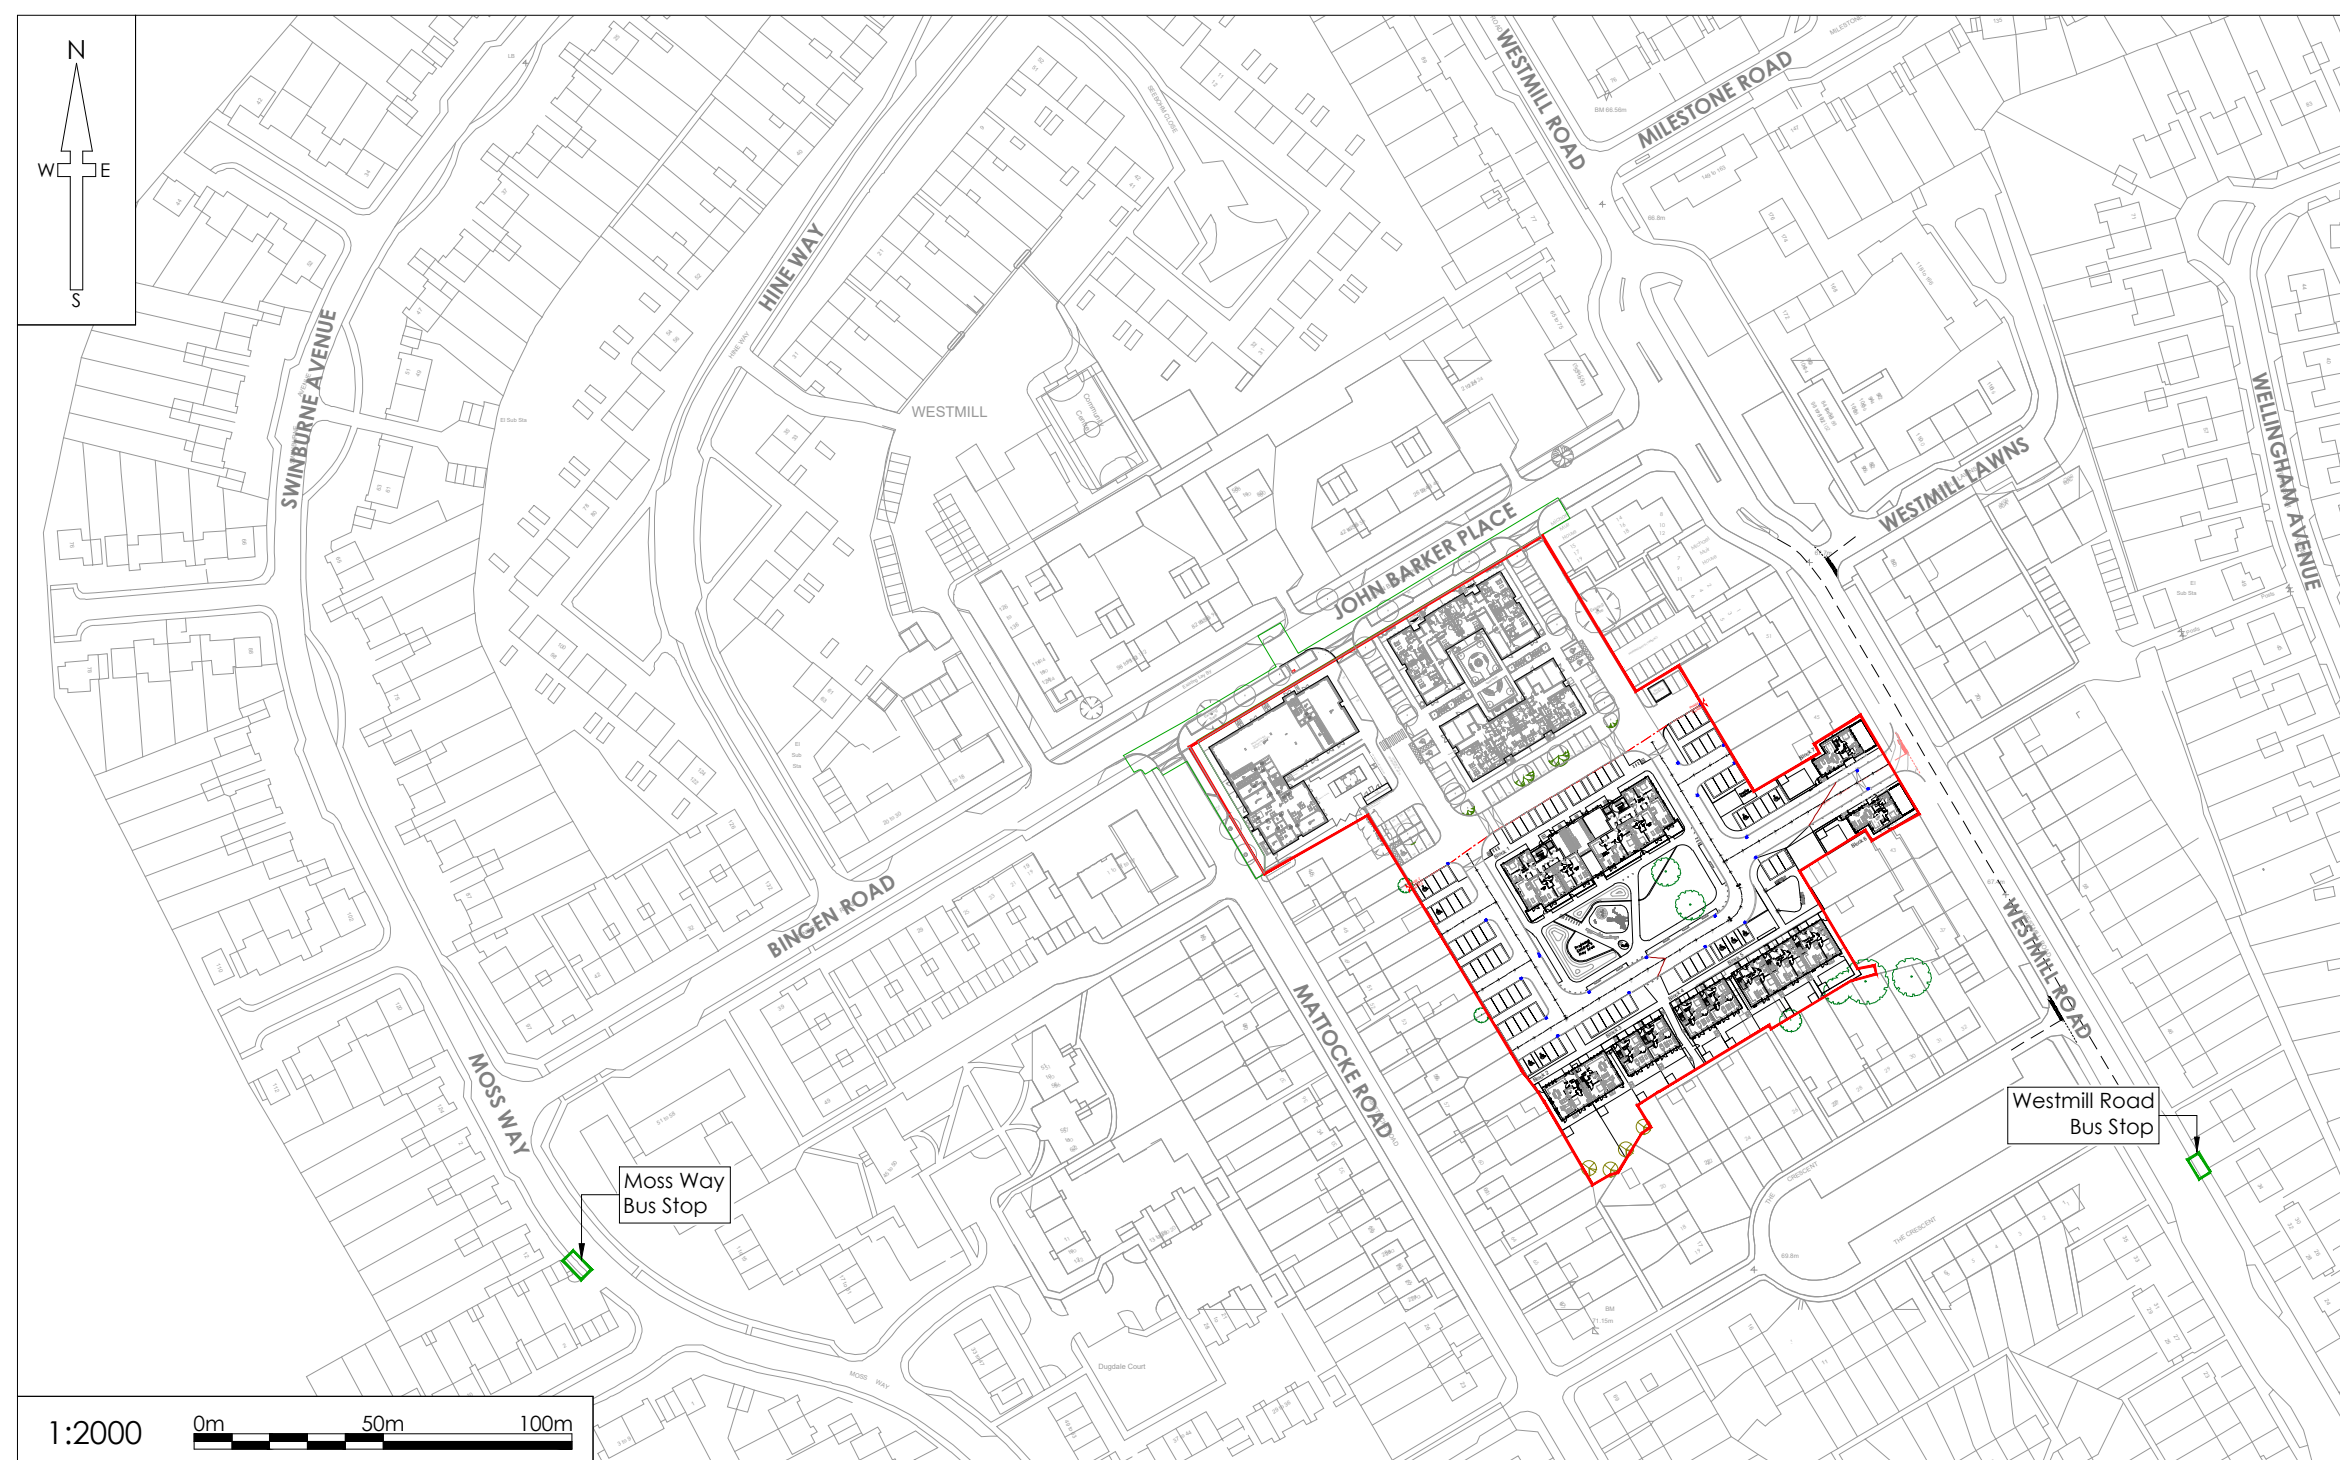
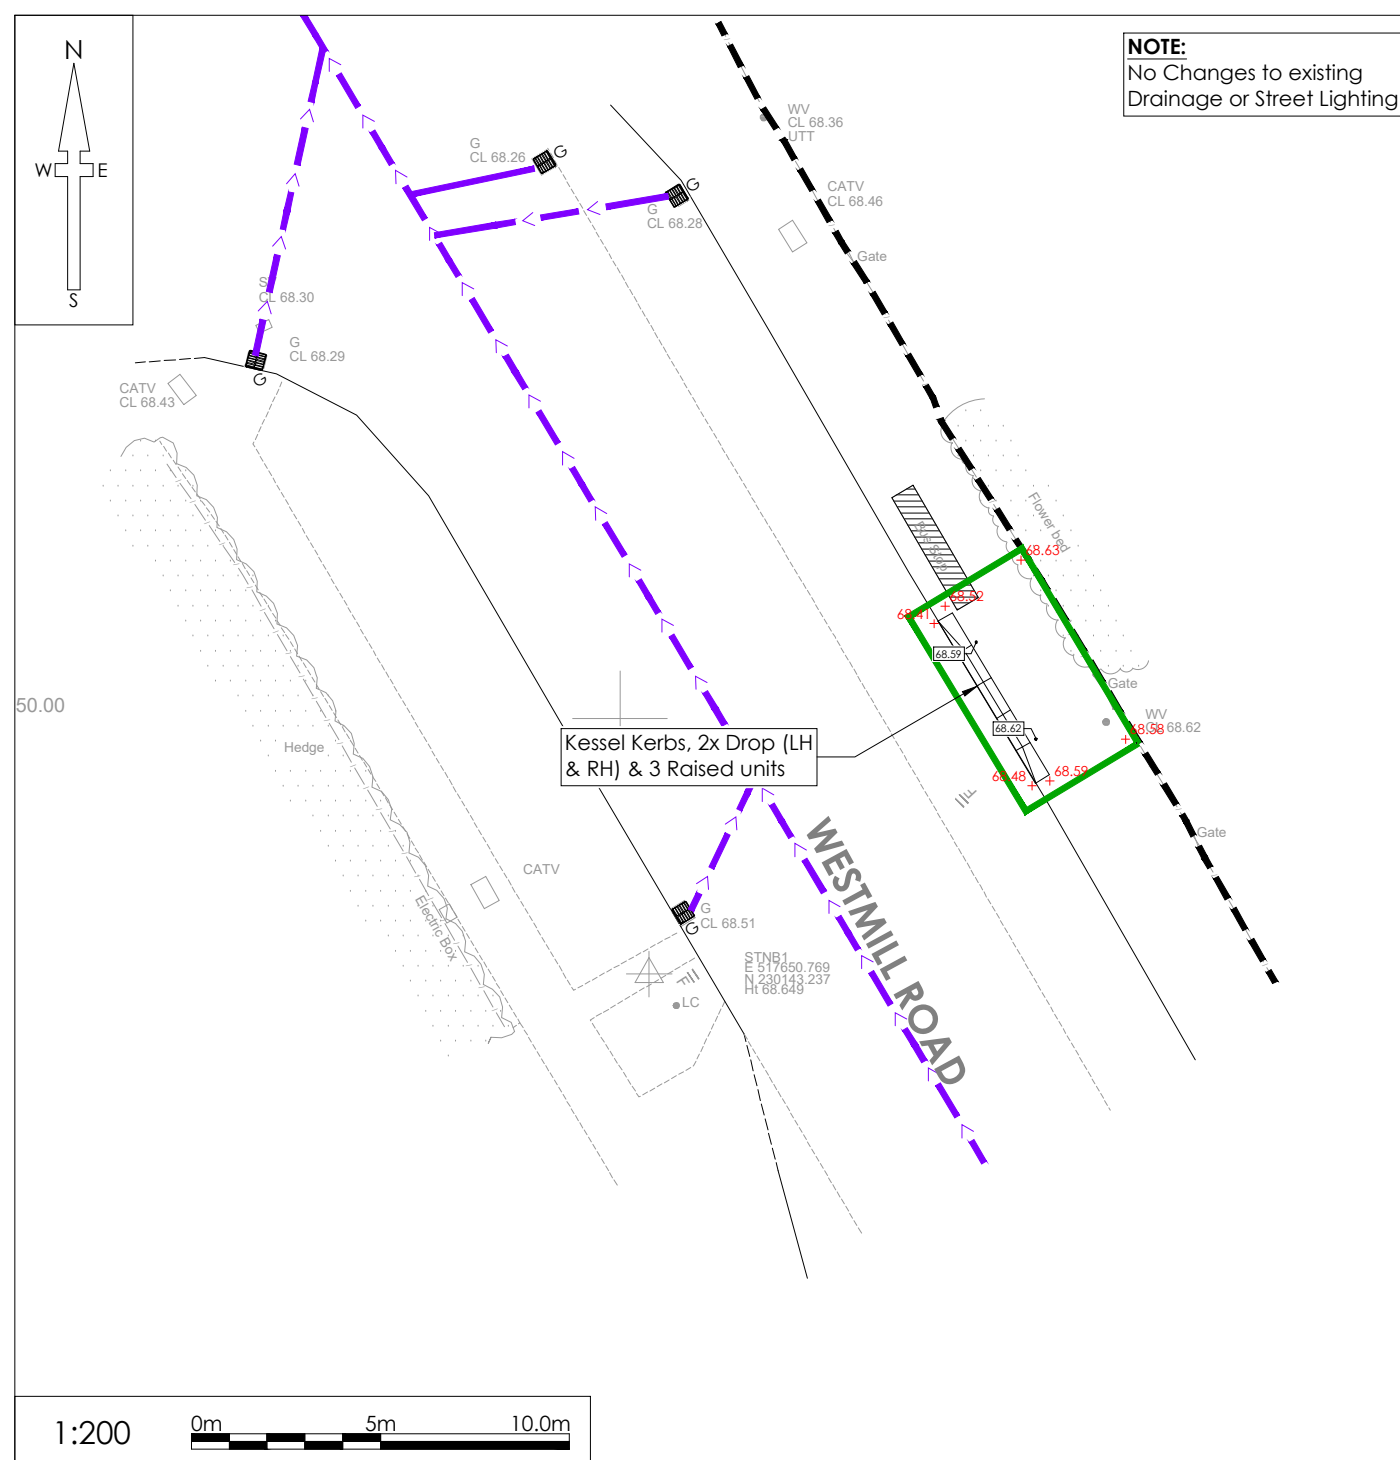
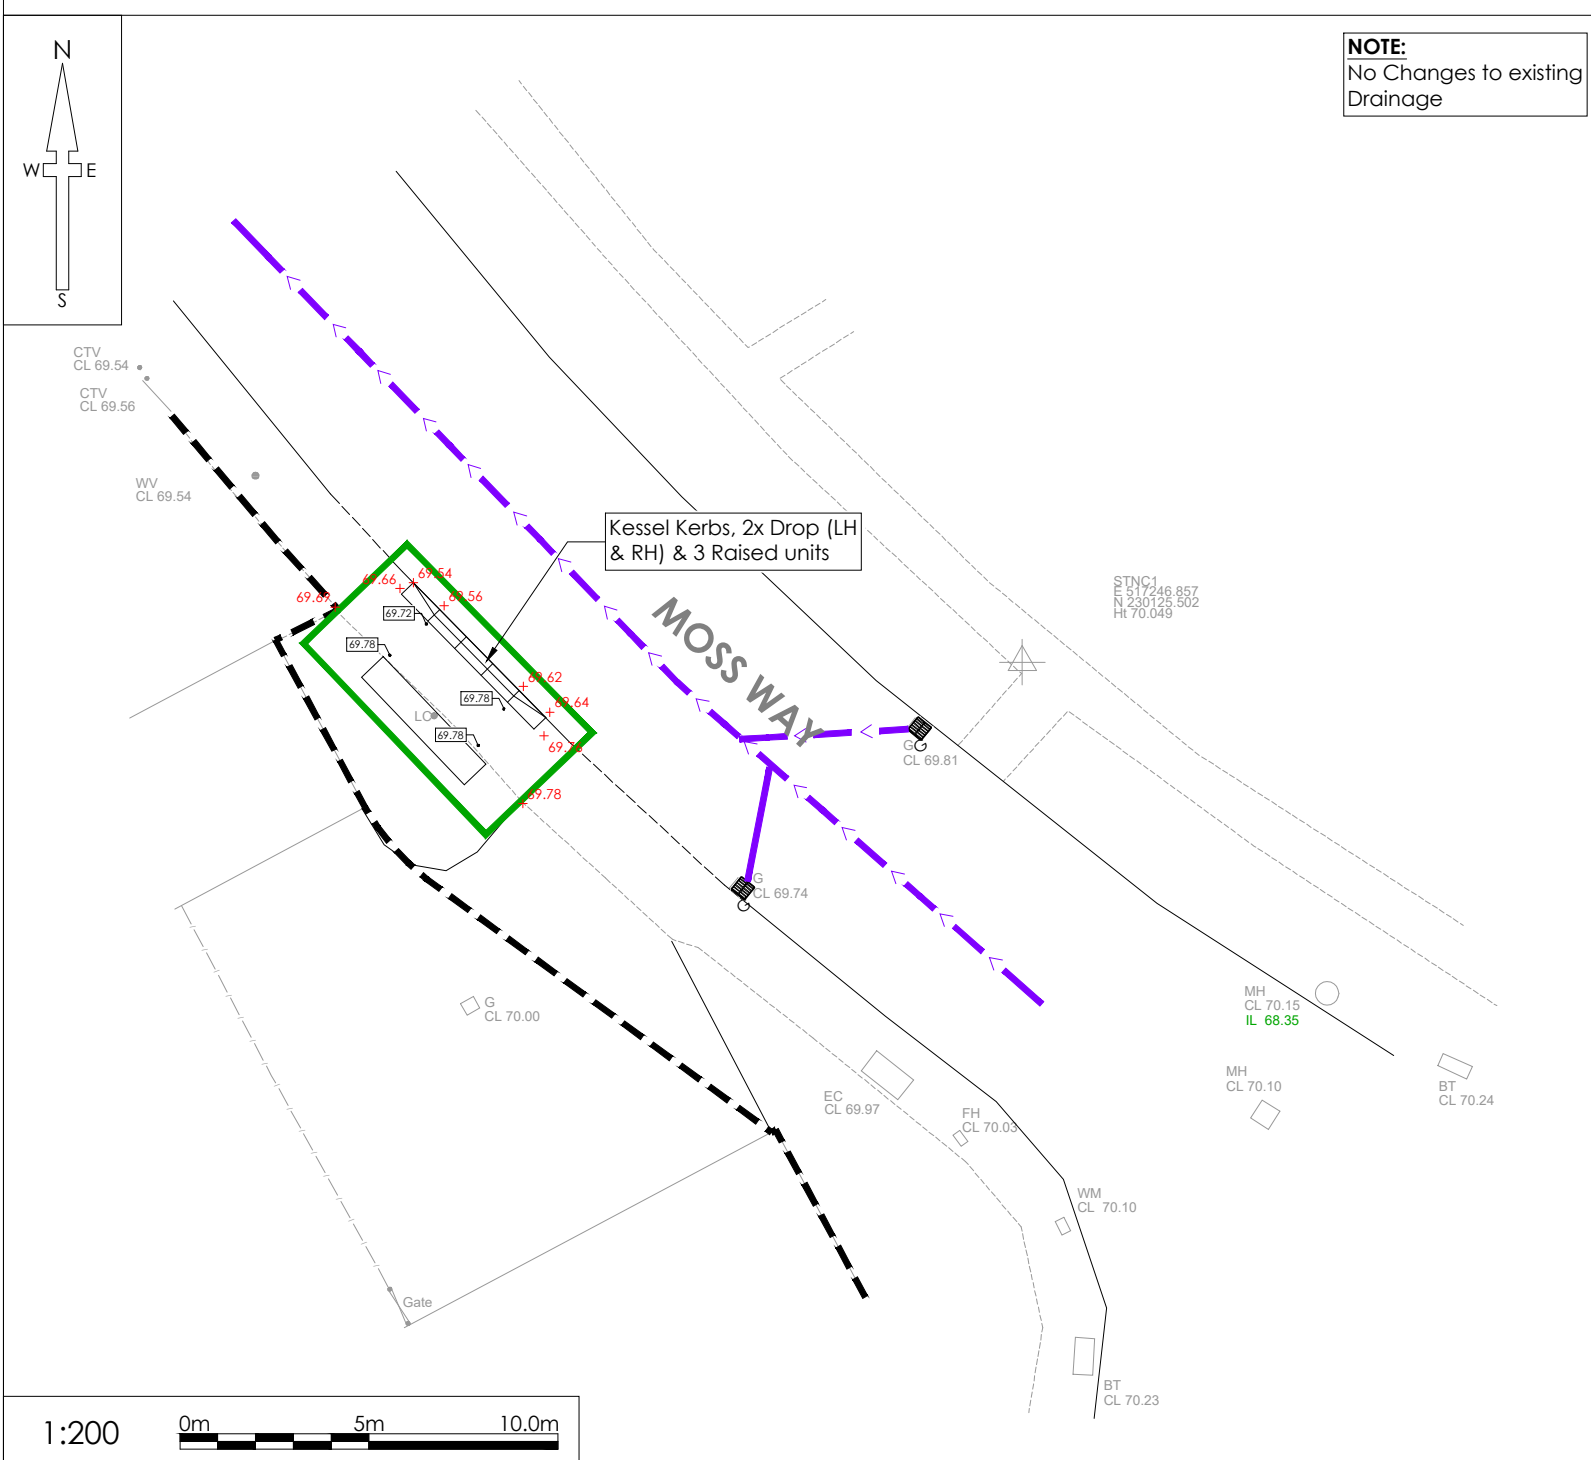


NOTES

1. All dimensions and levels are in metres unless otherwise noted
2. This drawing is to be read in conjunction with the relevant Architect's/Engineer's drawings, specifications and CDM documentation
3. This drawing has been produced electronically and may have been photo reduced or enlarged when copied. Work to figured dimensions only (DO NOT SCALE). All dimensions to be checked on site. Any errors or omissions to be reported to the engineer immediately.
4. This drawing contains coloured lines / information that may not be clear if reproduced in black and white.
5. Digital copies of this plan can only be considered accurate if supplied directly by Infrastruct CS Ltd.

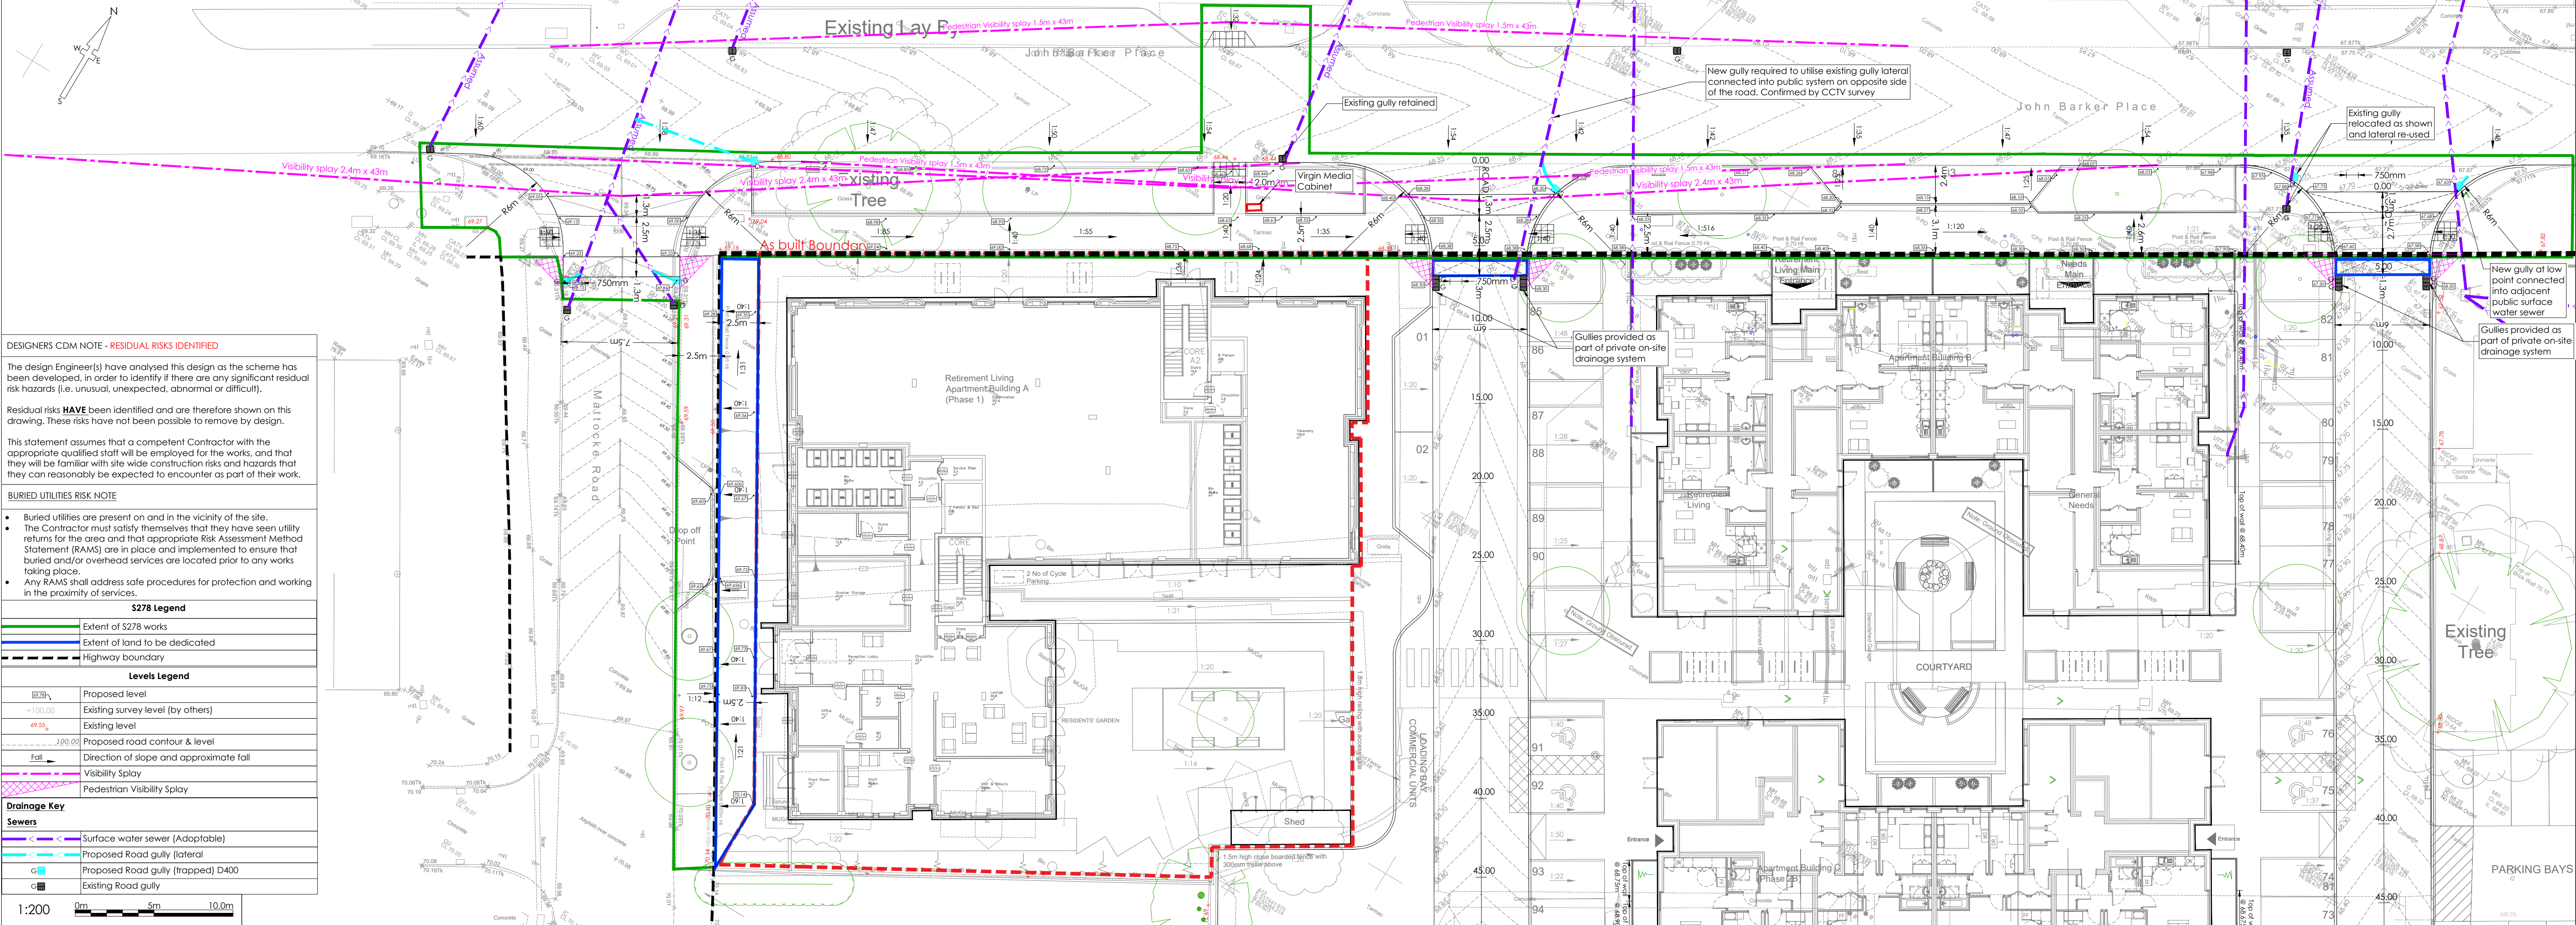

AB	NJ	TST	As built issue	17/12/24
REV	DRAWN	CHECK	REVISION COMMENTS	ISSUE DATE
DRAWING TITLE	Section 278 - Levels, Drainage & Visibility Splays - John Barker Place			SHEET NO. 1
PROJECT	John Barker Place Hitchin Hertfordshire			
CLIENT	Settle Group			
SCALE @ A1	1:200			ENGINEER
PROJECT NUMBER	4121	STATUS	AS BUILT	TST
PROJECT	MW201113	ORIGIN VOLUME	LEVEL	DRAFT
ICS	00	ZZ	DR	SNN
00	00	00	00	APPROVED
00	00	00	00	TST
00	00	00	00	NO. REVISION
00	00	00	00	0501 AB