


EXISTING FRONT ELEVATION (RETROSPECTIVE)

RETROSPECTIVE ADVERTISEMENT CONSENT - 26 HIGH STREET, HITCHIN SG5 1AT

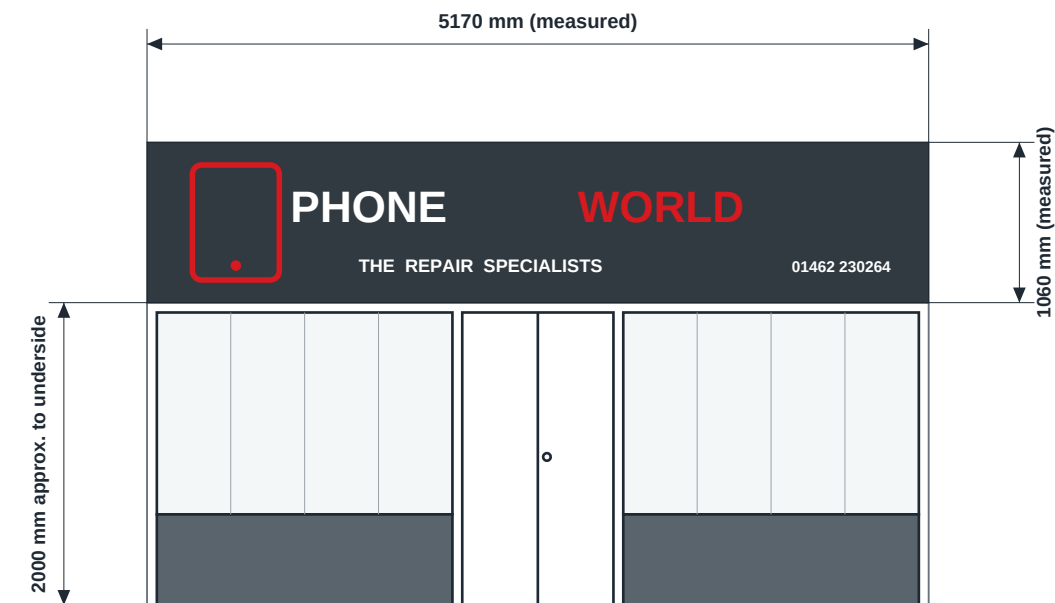

GROUND-FLOOR FRONT ELEVATION

Scale 1:50 at A3



REFERENCE PHOTOGRAPH - AS INSTALLED (NOT TO SCALE)

DRAWING NOTES

1. Dimensions are in millimetres. Do not scale dimensions from this drawing; use figured dimensions and the metric scale bar.
2. Fascia dimensions are based on client measurements: 5170 mm wide x 1060 mm high; underside approximately 2000 mm above ground.
3. Existing fascia is a shallow powder-coated aluminium tray, approximately 50 mm projection, with applied raised lettering and logo.
4. Colours: dark grey / anthracite background with white and red lettering. Sign is entirely non-illuminated.
5. Shopfront detail outside the measured fascia is diagrammatic and based on the dated front-elevation photograph.
6. This drawing records the existing as-installed condition for retrospective consent.

METRIC SCALE BAR - 1:50



IMPORTANT: PRINT AT 100% / ACTUAL SIZE ON A3. If resized, rely on the metric scale bar.

PHONE WORLD

26 High Street, Hitchin, Hertfordshire, SG5 1AT

Advertisement Consent - Application 26/01932/AD

DRAWING TITLE

Existing Front Elevation (Retrospective)

DRAWING REF

DR-01

STATUS

FOR VALIDATION - AS INSTALLED

SCALE / SHEET

1:50 @ A3

REV / DATE

P01 / 14.08.2026