




AERIAL VIEW OF THE SITE PROPOSAL IN ITS CONTEXT

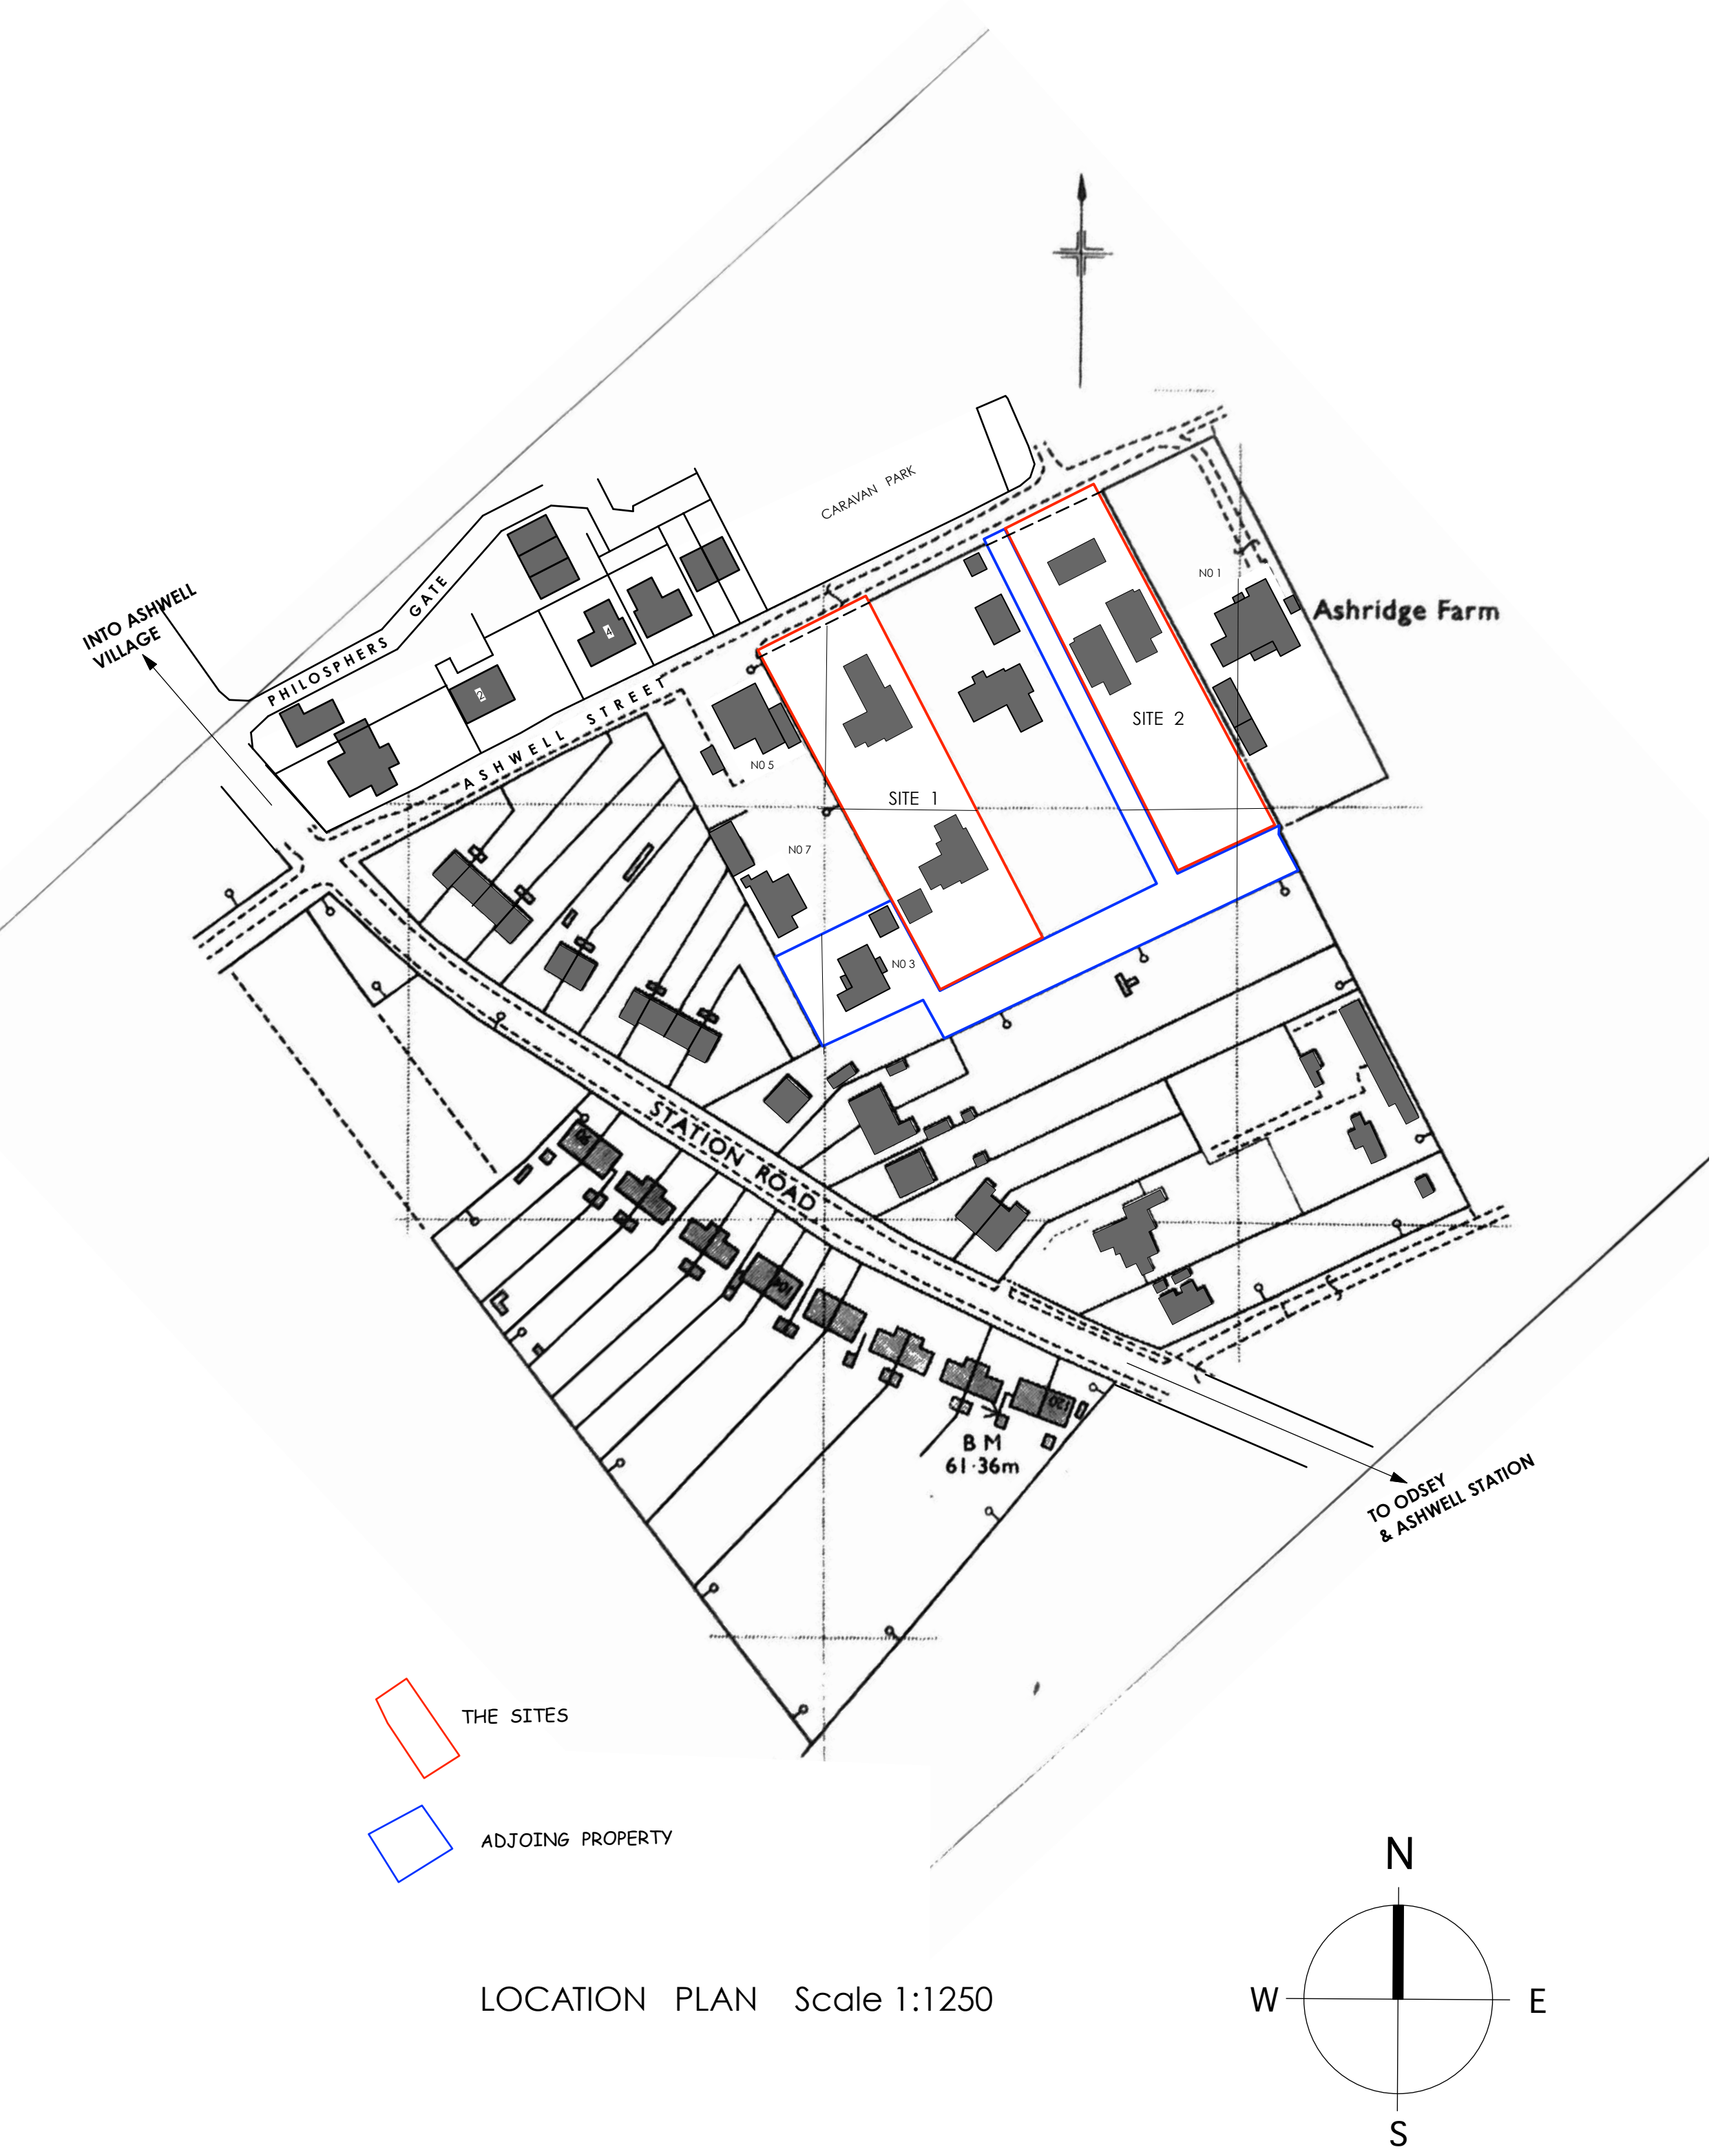

LOCATION PLAN Scale 1:1250

Rev P: 5/11/25. 'Red Line' moved out to road edge. PLANNING DRAWING

Project: PROPOSED NEW HOUSES IN THE RUDDERY, ASHWELL STREET, ASHWELL, HERTS			
Drawing title:	Scale:	1: 1250	Drawing Number:
	Date:	July 2025	
LOCATION PLAN 1:1250 AERIAL VIEW			303-A1- 01P.1