





AS BUILT (NORTH FACING FRONT) ELEVATION 1:100

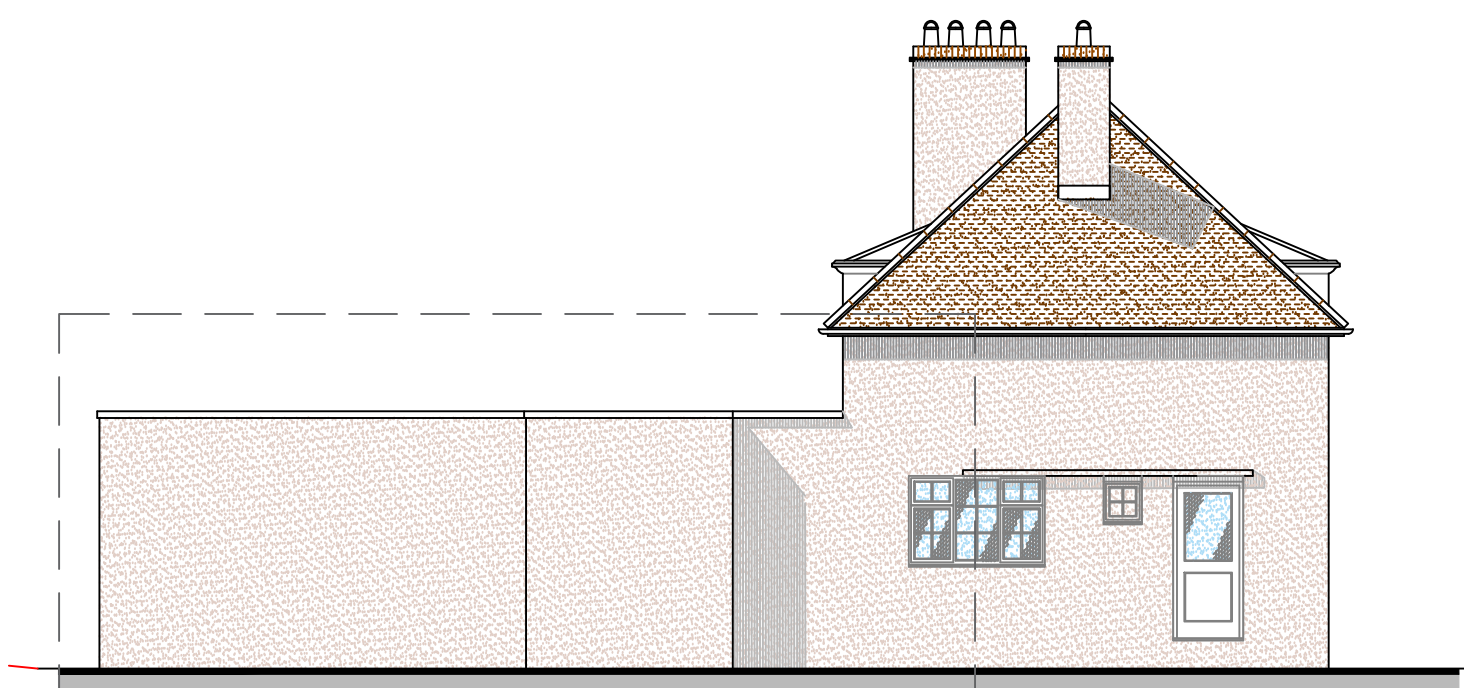


AS BUILT (EAST FACING SIDE) ELEVATION 1:100

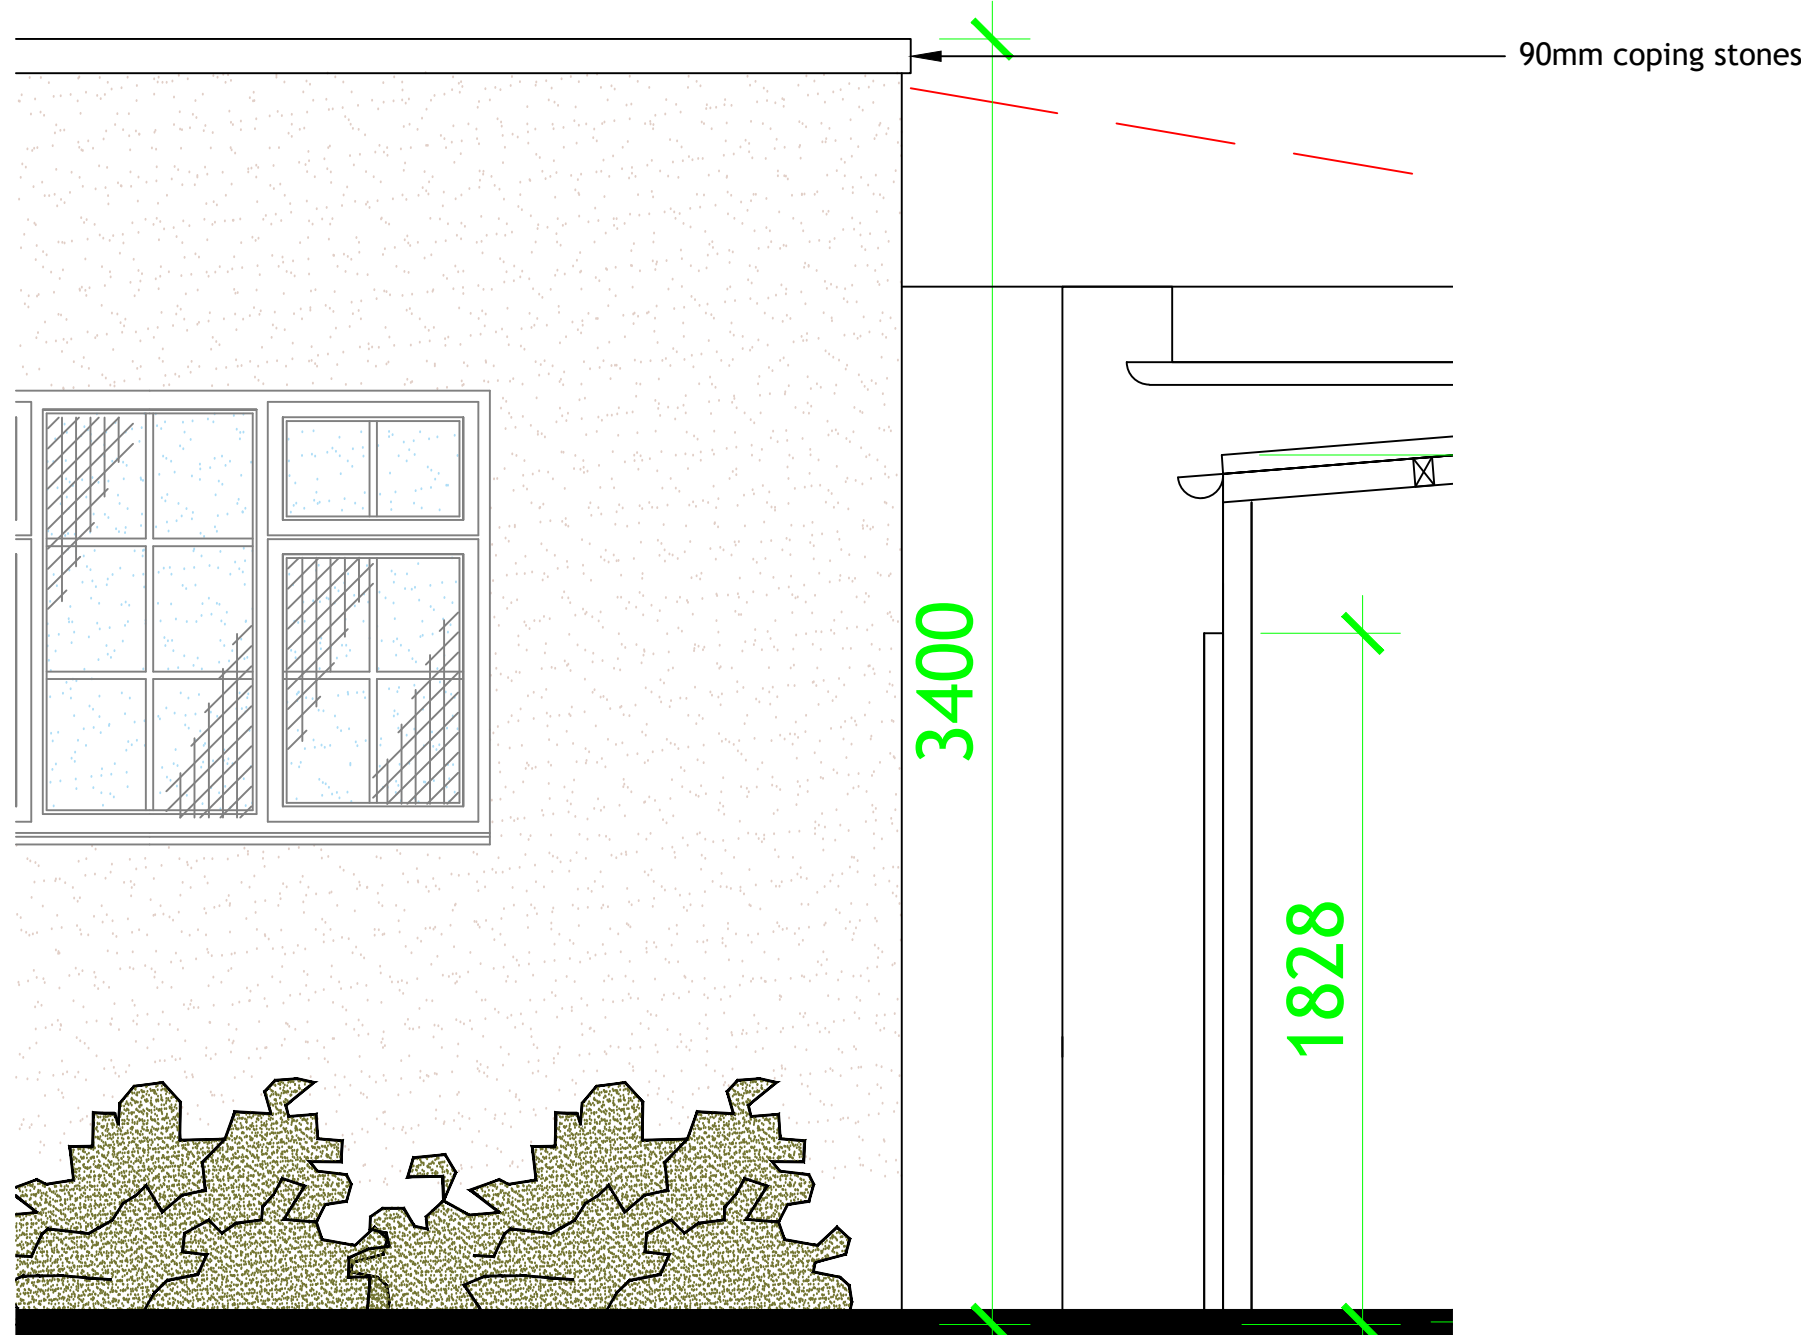


AS BUILT PARTIAL SOUTH REAR ELEVATION [EXISTING] 1:20




AS BUILT (SOUTH FACING REAR) ELEVATION 1:100

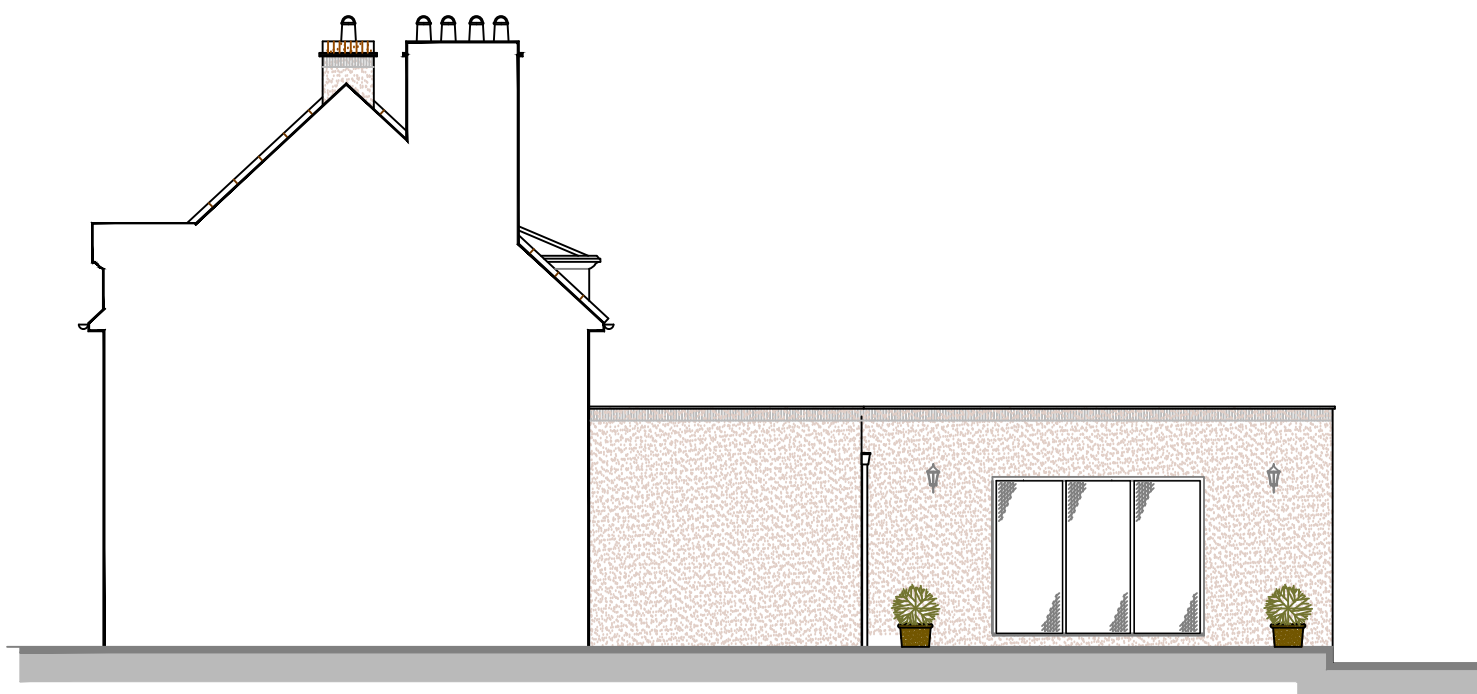



AS BUILT (WEST FACING SIDE) ELEVATION 1:100

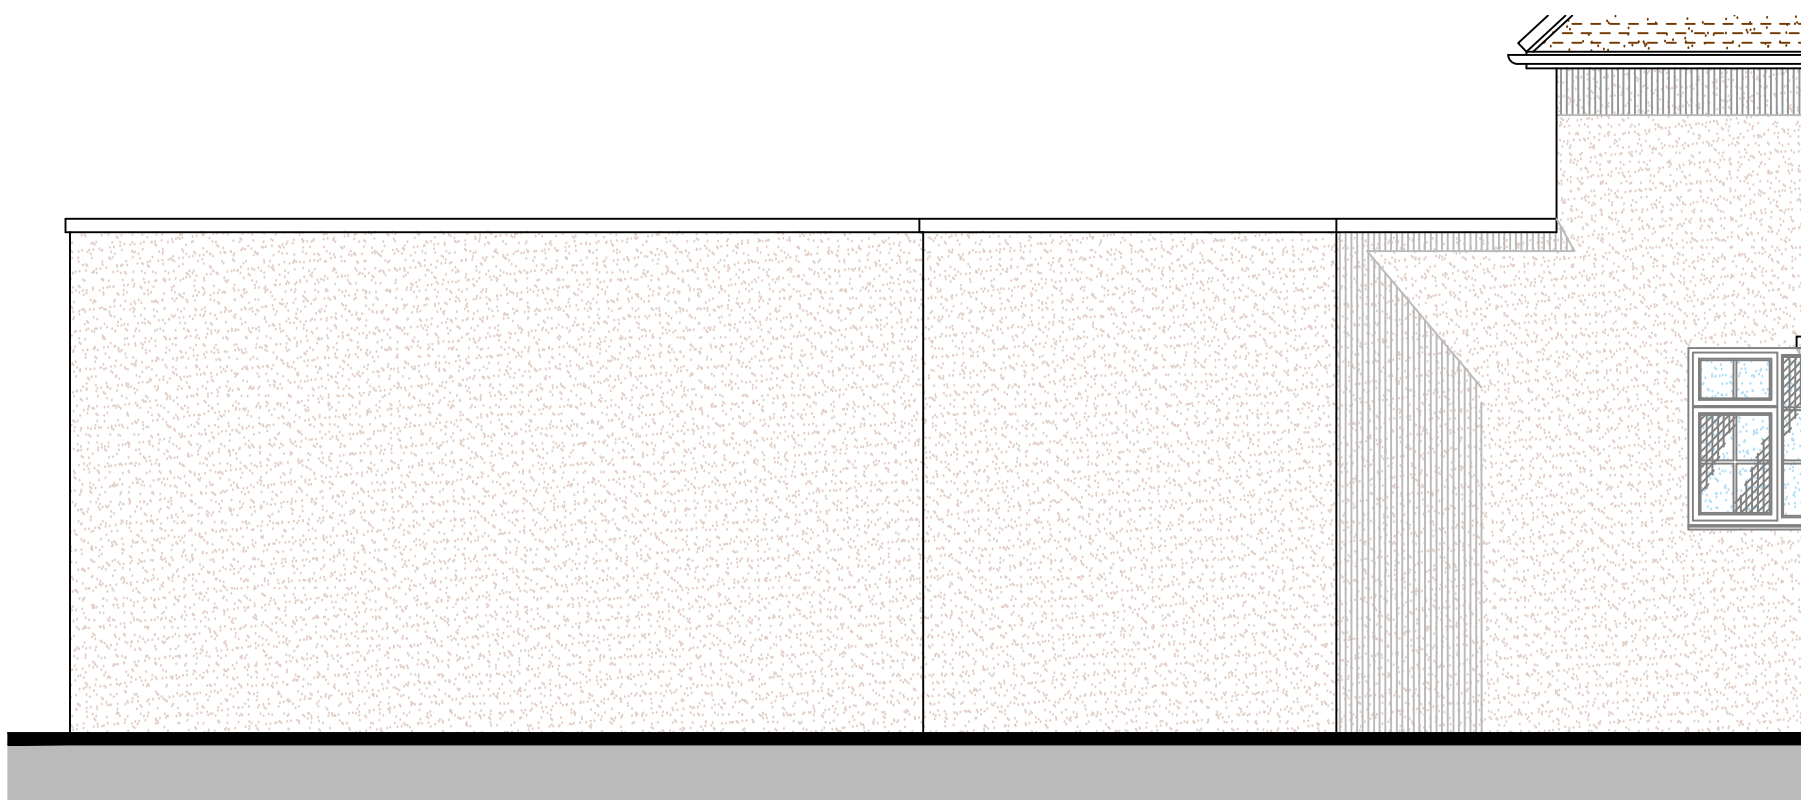

AS BUILT PARTIAL (EAST FACING SIDE) ELEVATION 1:50

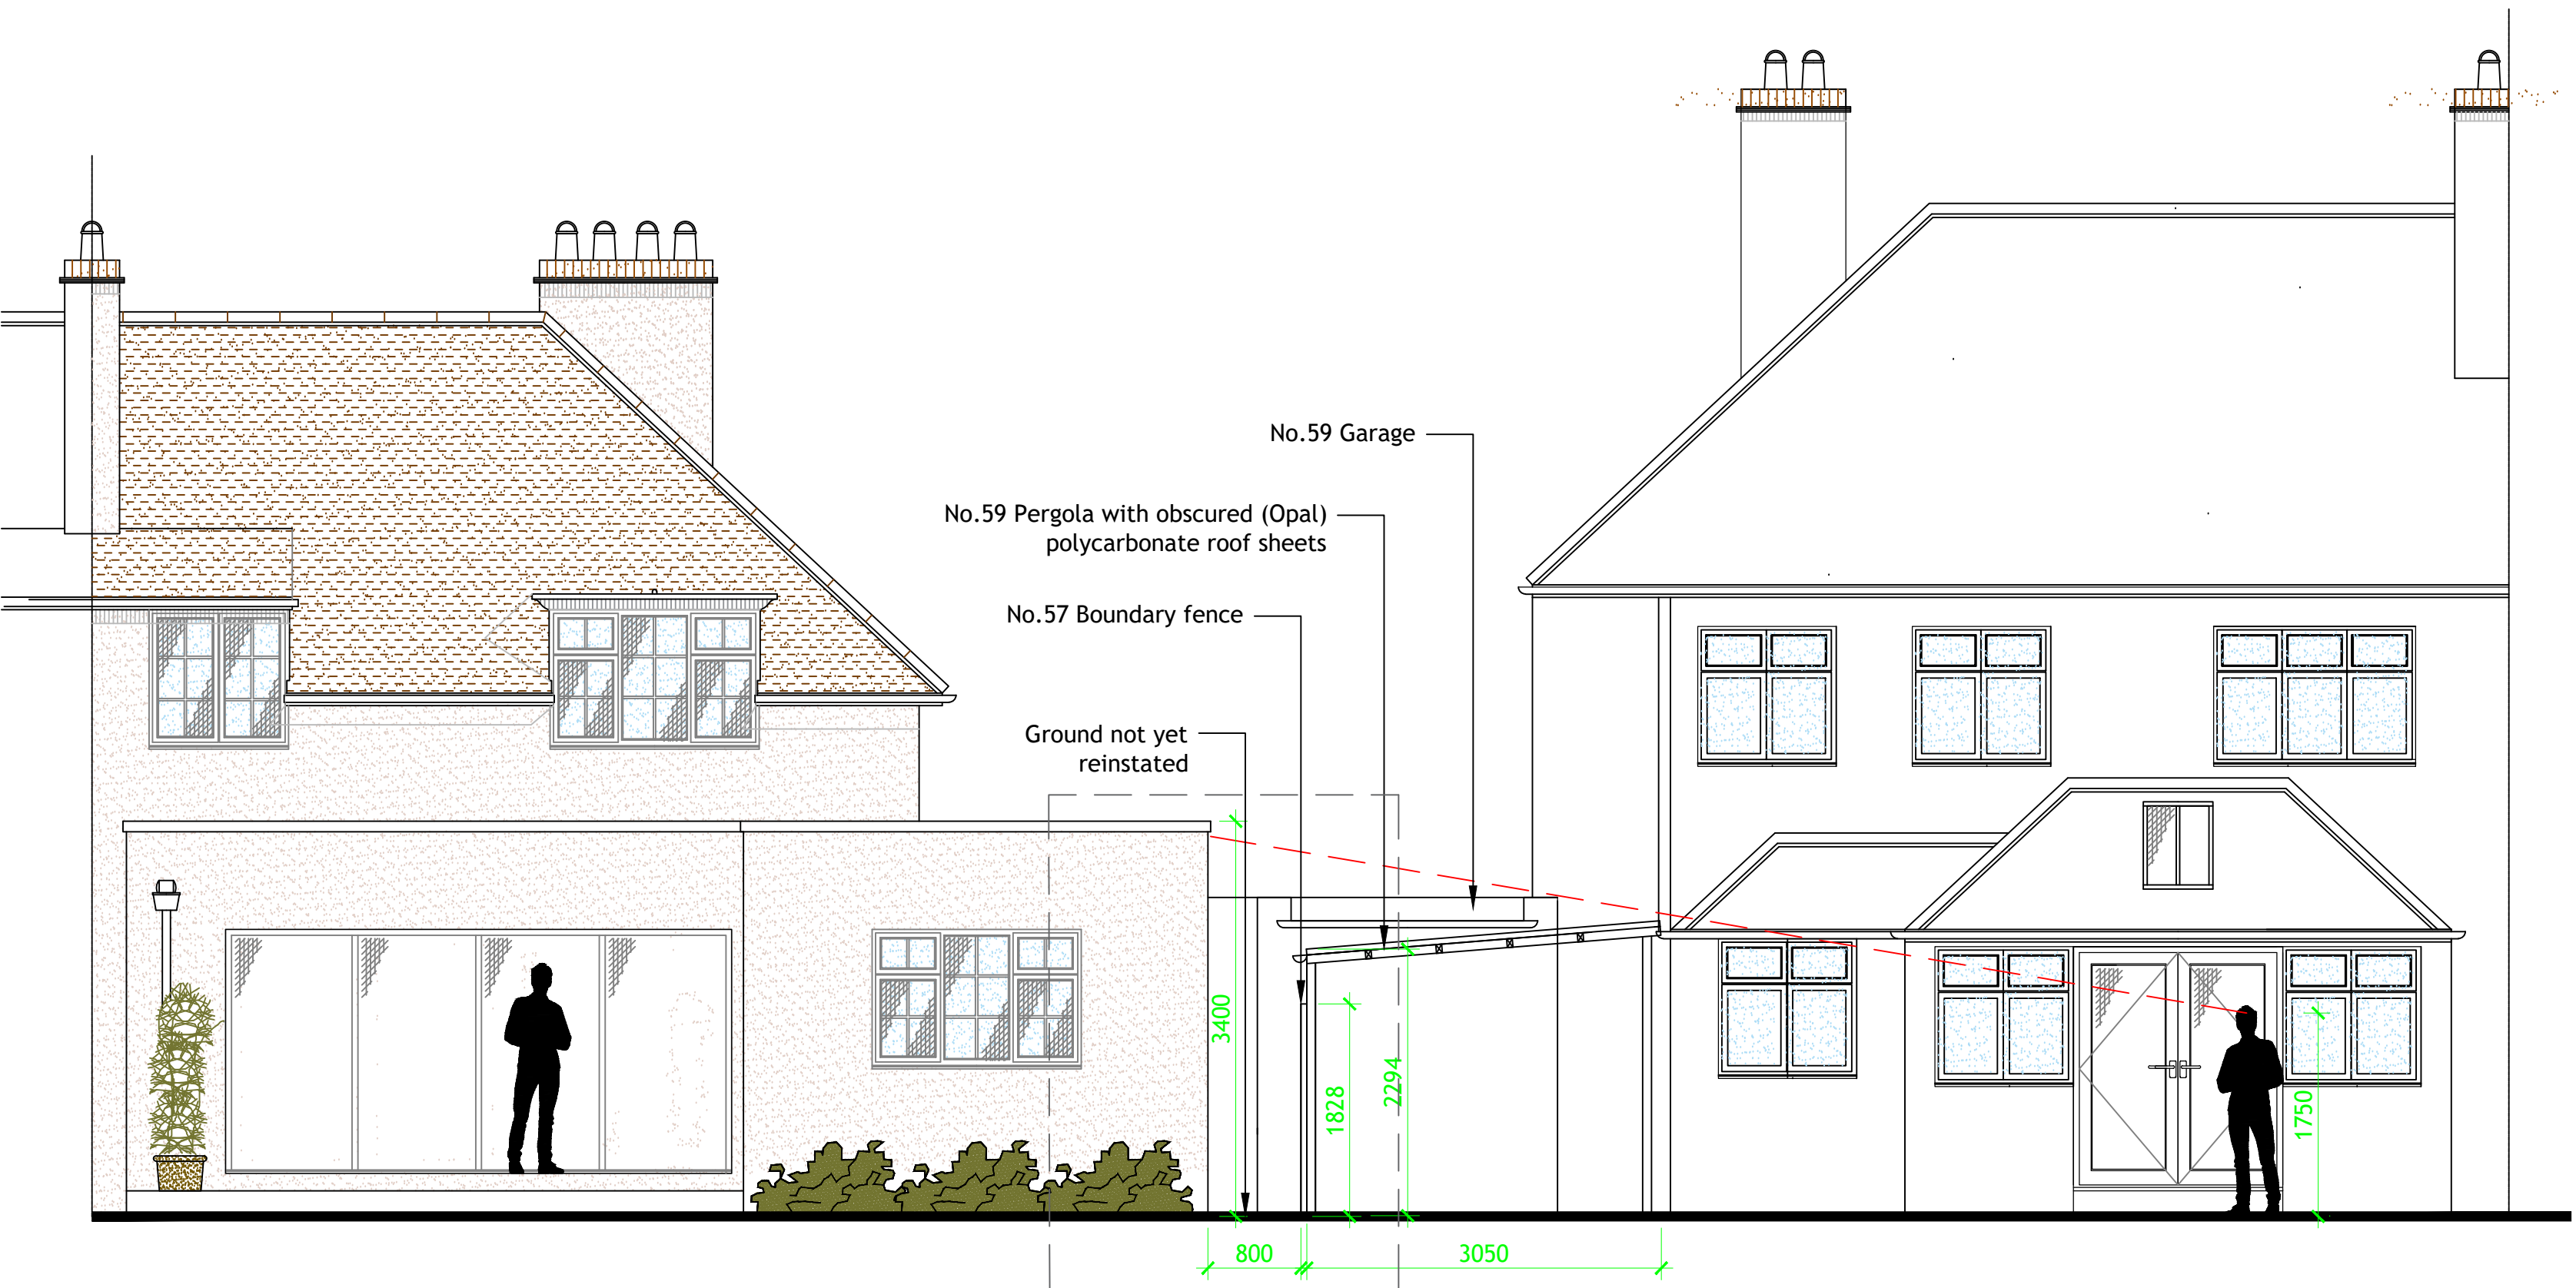

AS BUILT SECTION A-B [SOUTH REAR ELEVATION] 1:50

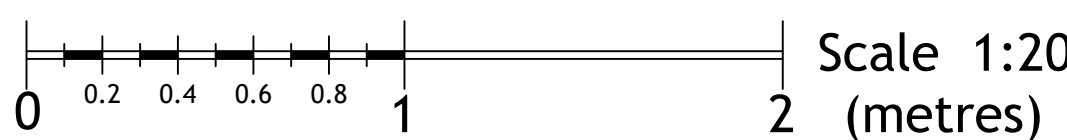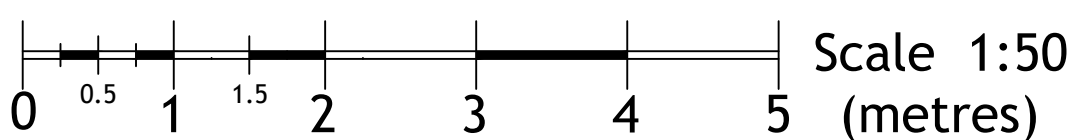

NOTES:
ALL LEVELS, ANGLES AND DIMENSIONS TO BE CHECKED ON
SITE PRIOR TO COMMENCEMENT OF WORKS.

THIS DRAWING IS TO BE READ IN CONJUNCTION WITH ALL
RELEVANT STRUCTURAL ENGINEERS AND MECHANICAL AND
ELECTRICAL ENGINEERS DRAWINGS, DETAILS AND
SPECIFICATIONS.

Revisions:

Status:
AS BUILT ISSUE
Client:
Mr David Savage

Project:
57 Gernon Road
Letchworth Garden City
SG6 3HS
Rear Extension & Associated Works

Title:
As Built Elevations &
Section

Scale @A1: Date: Drawn: Checked:
1:20/50/100 05/12/25 CC CC

Drawing no.: Revision:
BA / CC_2025_AS_BUILT_ELE /