

NOTES:
ALL LEVELS, ANGLES AND DIMENSIONS TO BE CHECKED ON
SITE PRIOR TO COMMENCEMENT OF WORKS.

THIS DRAWING IS TO BE READ IN CONJUNCTION WITH ALL
RELEVANT STRUCTURAL ENGINEERS AND MECHANICAL AND
ELECTRICAL ENGINEERS DRAWINGS, DETAILS AND
SPECIFICATIONS.


Revisions:

KEY

57 Gernon Road site boudary.
Note that only part of rear
garden shown. Additional 6.3m
length not shown in drawing.

Status:
AS BUILT ISSUE
Client:
Mr David Savage
Project:
57 Gernon Road
Letchworth Garden City
SG6 3HS
Rear Extension & Associated Works

Title:
As Built Ground Floor Plan &
Part Existing Garden
Scale @A1: Date: Drawn: Checked:
1:50 05/12/25 CC CC
Drawing no.: Revision:
BA / CC_2025_AS_BUILT_GF /

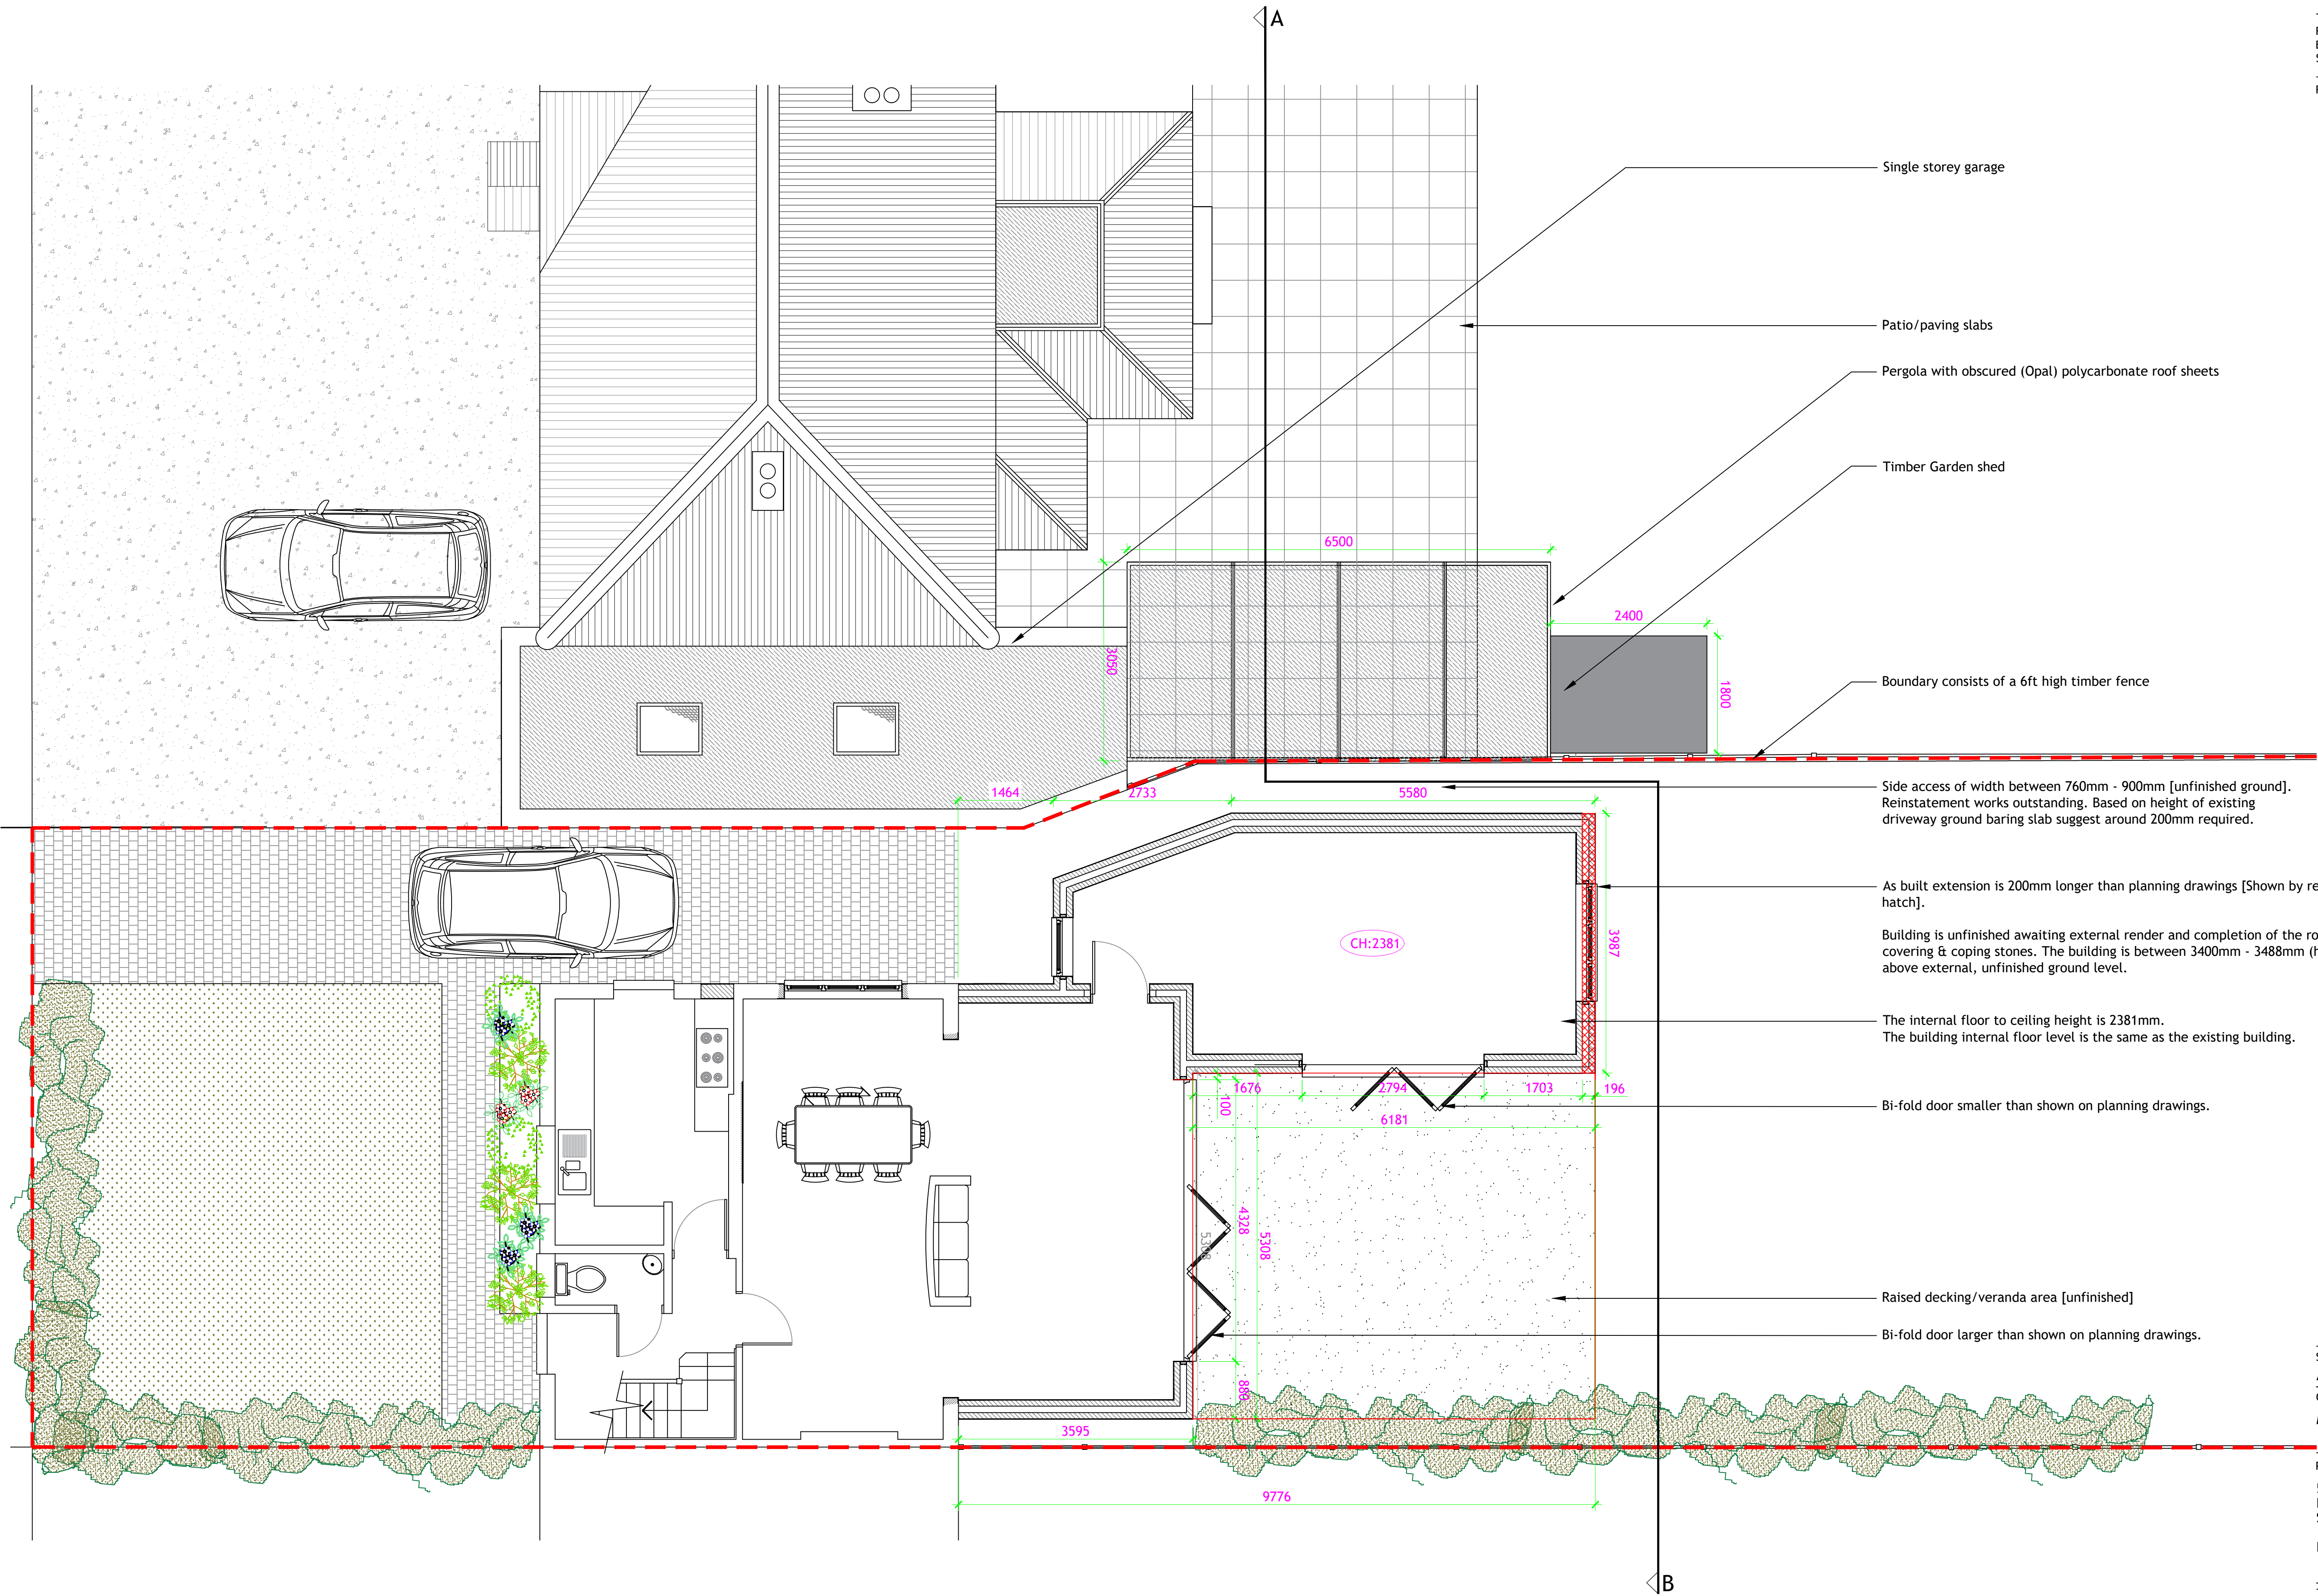

AS BUILT GROUND FLOOR PLAN 1:50
Scale 1:50
0 0.5 1 1.5 2 3 4 5 (metres)