

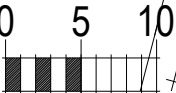


+

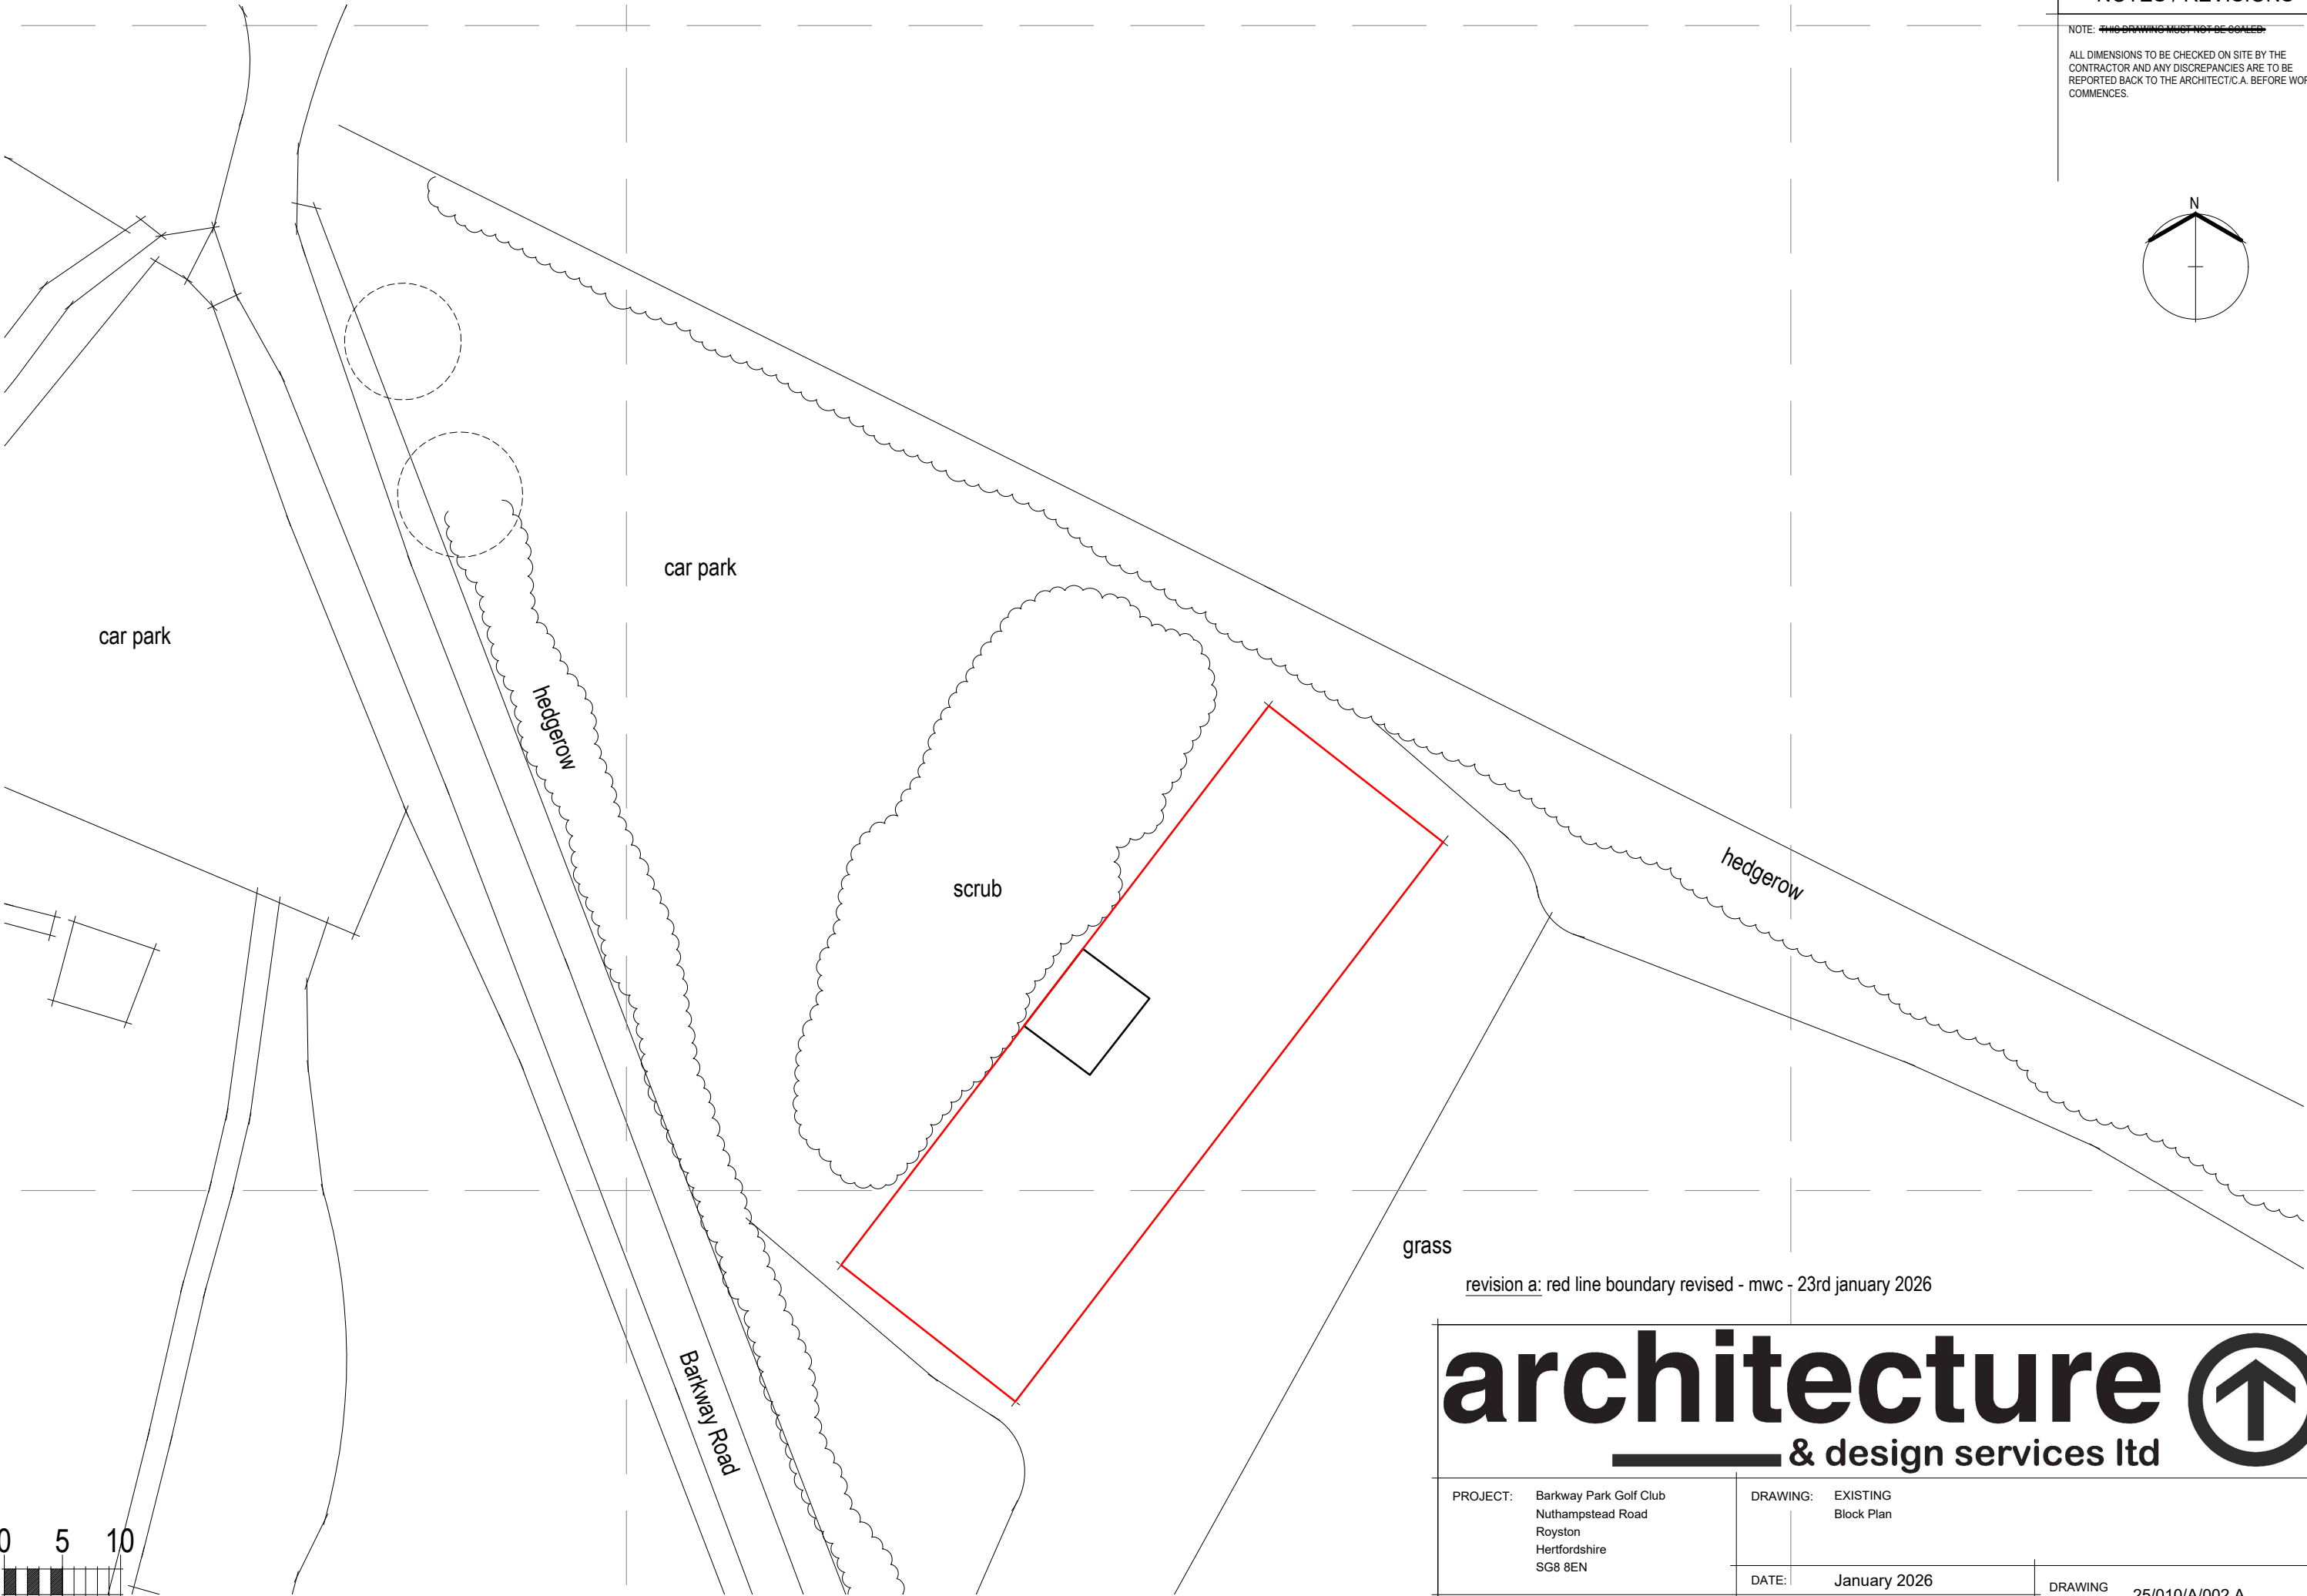

NOTES / REVISIONS

NOTE: ~~THIS DRAWING MUST NOT BE COPIED~~
ALL DIMENSIONS TO BE CHECKED ON SITE BY THE CONTRACTOR AND ANY DISCREPANCIES ARE TO BE REPORTED BACK TO THE ARCHITECT/C.A. BEFORE WORK COMMENCES.

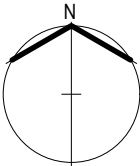

revision a: red line boundary revised - mwc - 23rd january 2026

architecture

& design services ltd

PROJECT:	Barkway Park Golf Club Nuthampstead Road Royston Hertfordshire SG8 8EN	DRAWING:	EXISTING Block Plan
DATE:	January 2026	DRAWING NUMBER:	25/010/A/002 A
DRAWN BY:	os	CHECKED:	mwc
SCALE:	1/500	at A3	