

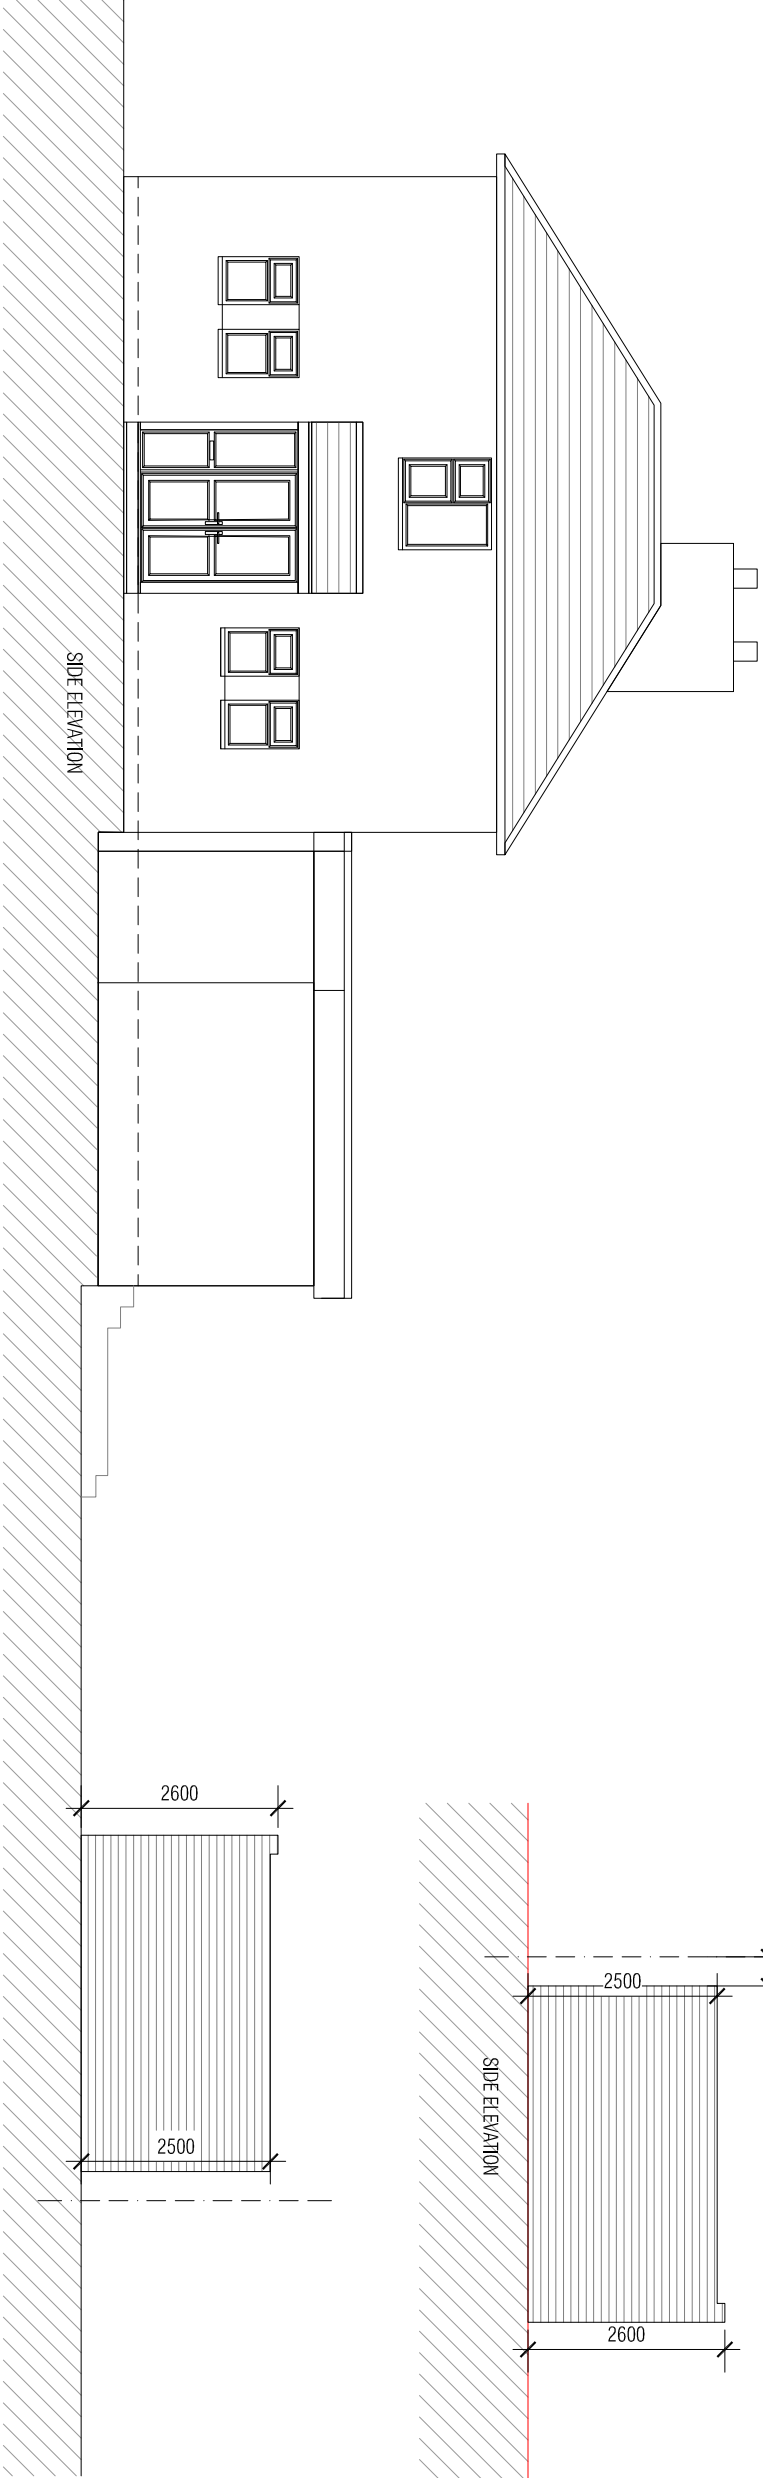
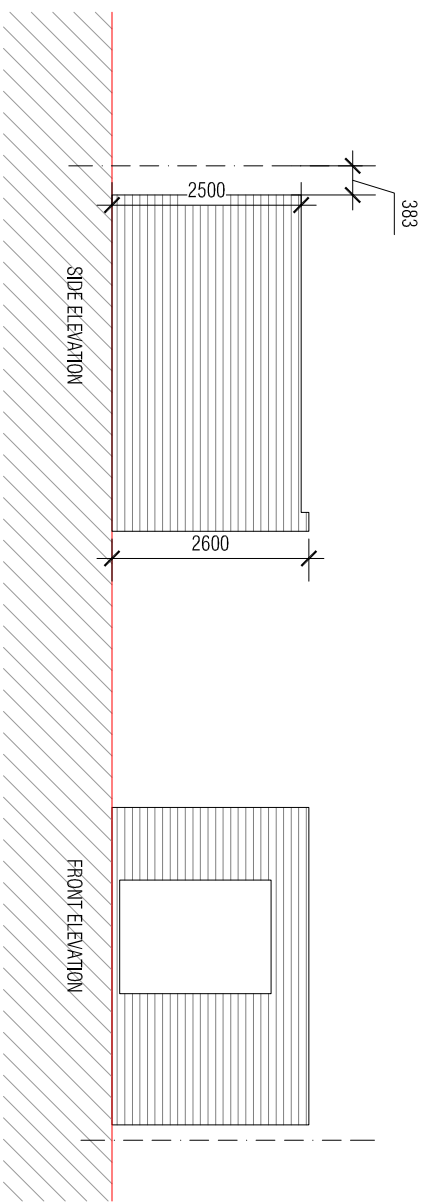


NO DIMENSIONS ARE TO BE SCALED FROM THIS DRAWING. ALL DIMENSIONS STATED MUST BE REPERED ON SITE. THE DRAWING IS TO BE USED AS A GUIDE ONLY. NO RESPONSIBILITY IS TO BE TAKEN FOR ANY ERRORS OR OMISSIONS. THE DRAWING IS TO BE USED AS A GUIDE ONLY. NO RESPONSIBILITY IS TO BE TAKEN FOR ANY ERRORS OR OMISSIONS. THE DRAWING IS TO BE USED AS A GUIDE ONLY. NO RESPONSIBILITY IS TO BE TAKEN FOR ANY ERRORS OR OMISSIONS.

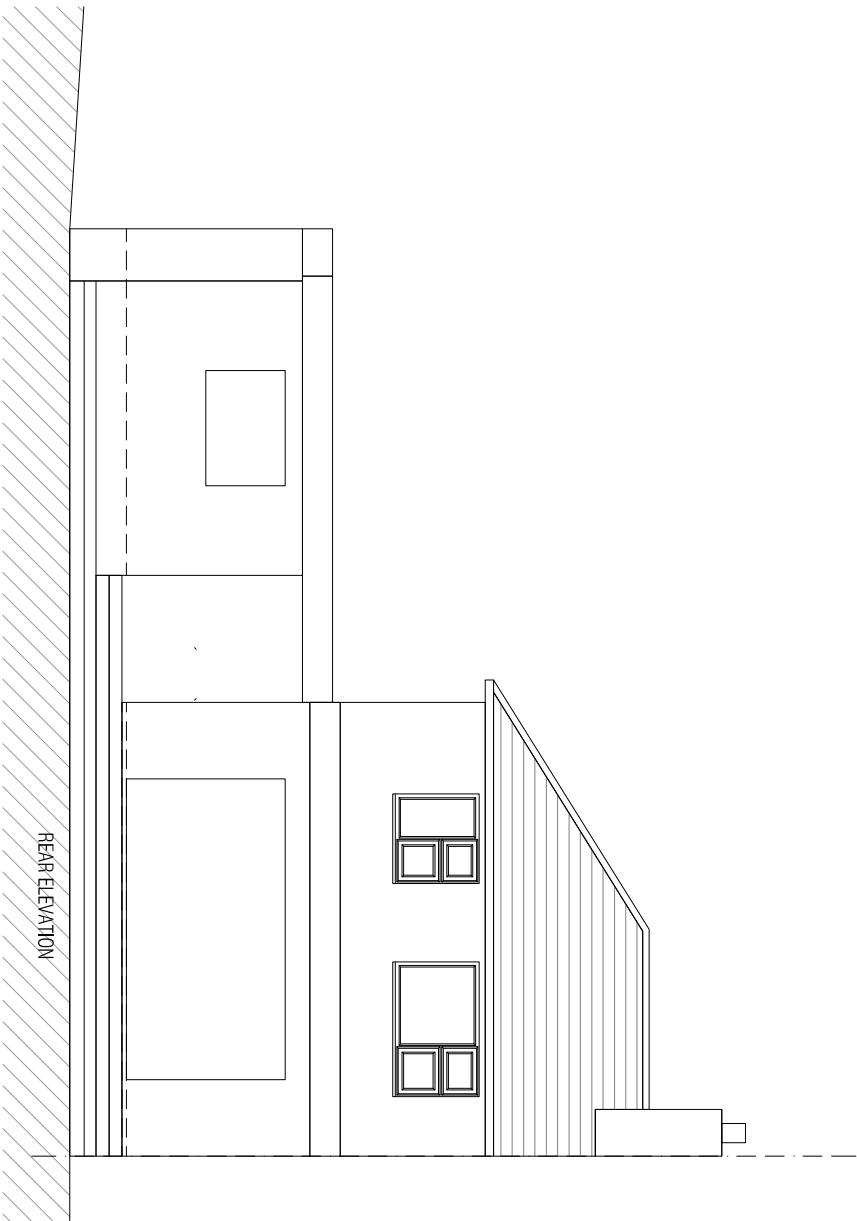

Scale 1:100 0 1 2.5 5 10m

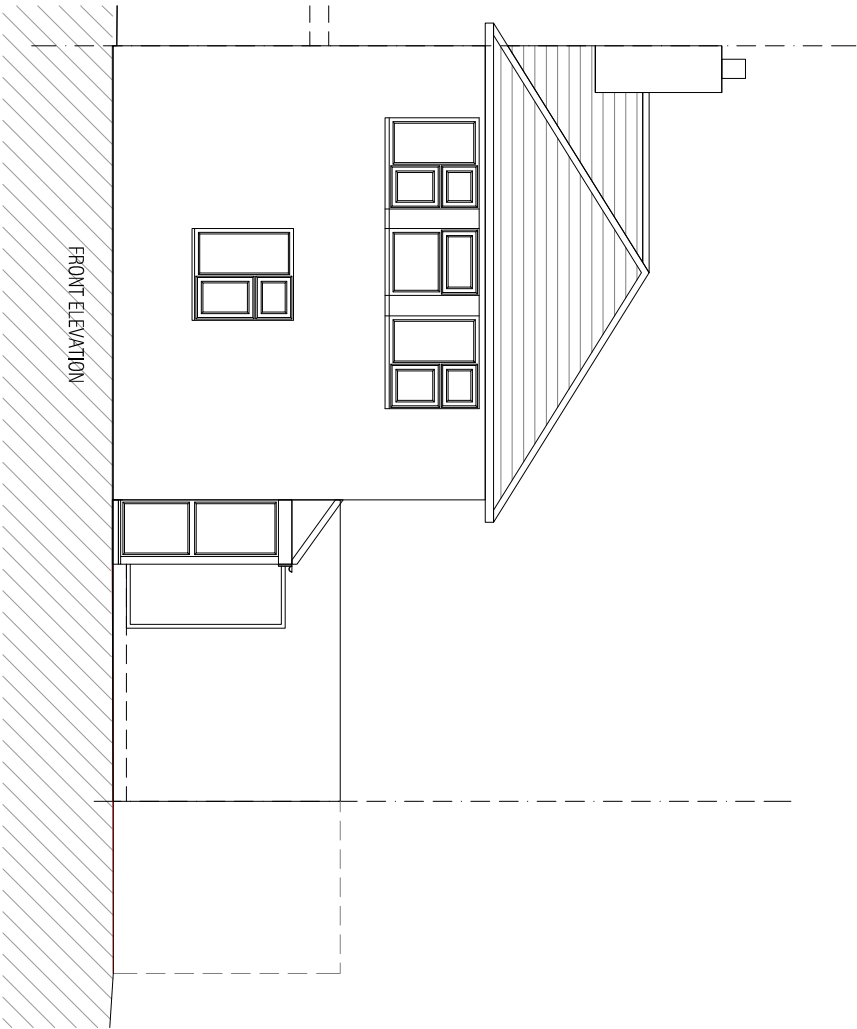

REV A STEPS UPDATED AS BUILT ON SITE 15-04-2025

Project:
31 THATCHERS END
HITCHIN SG4 0PD

Client:

Drawing Title:
EXISTING ELEVATIONS

Scale: 1:100 @A3
Date: AUGUST 2024
Project No: 24052
Drawing No: A 202
Revision: A