
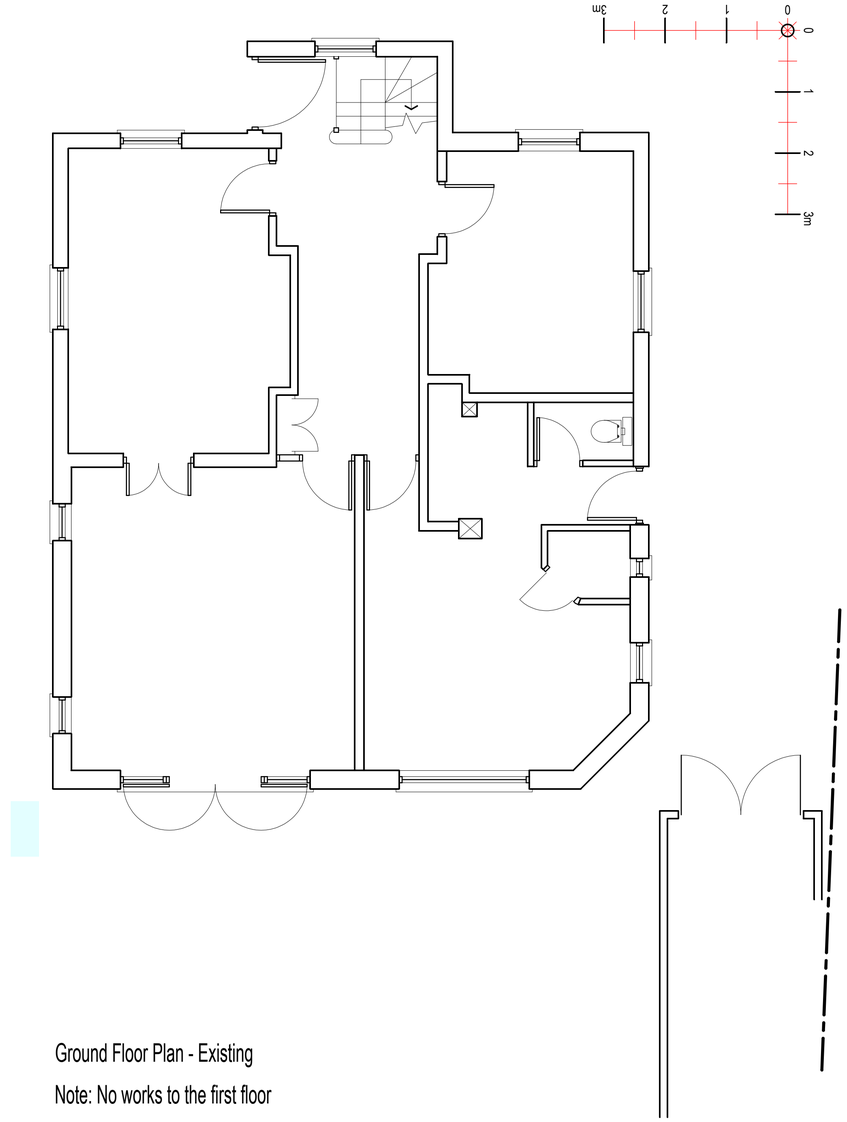


Ground Floor Plan - Existing


Note: No works to the first floor

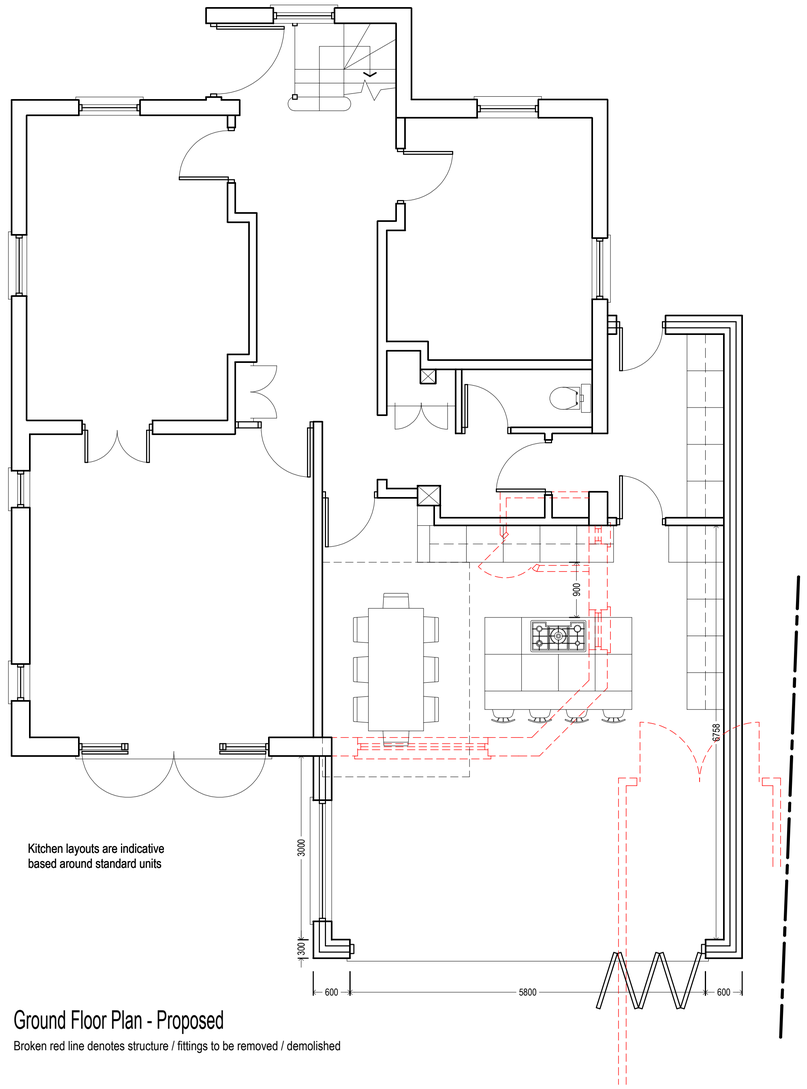

Kitchen layouts are indicative
based around standard units

Ground Floor Plan - Proposed

Broken red line denotes structure / fittings to be removed / demolished

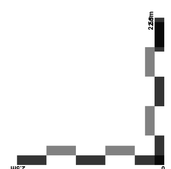

Title: Ground Floor Plan Existing + Proposed
Scale: 1:50
Drawing no: 62-05 Rev -
Date: Nov. 2017 Sheet Size: A1

Phil + Judith Wheeler
62 Stevenage Road Knebworth
Hertfordshire SG3 6NN