*General note: Minor relocation of windows throughout.

*General note: Window dimensions changed, equal opening lights added.

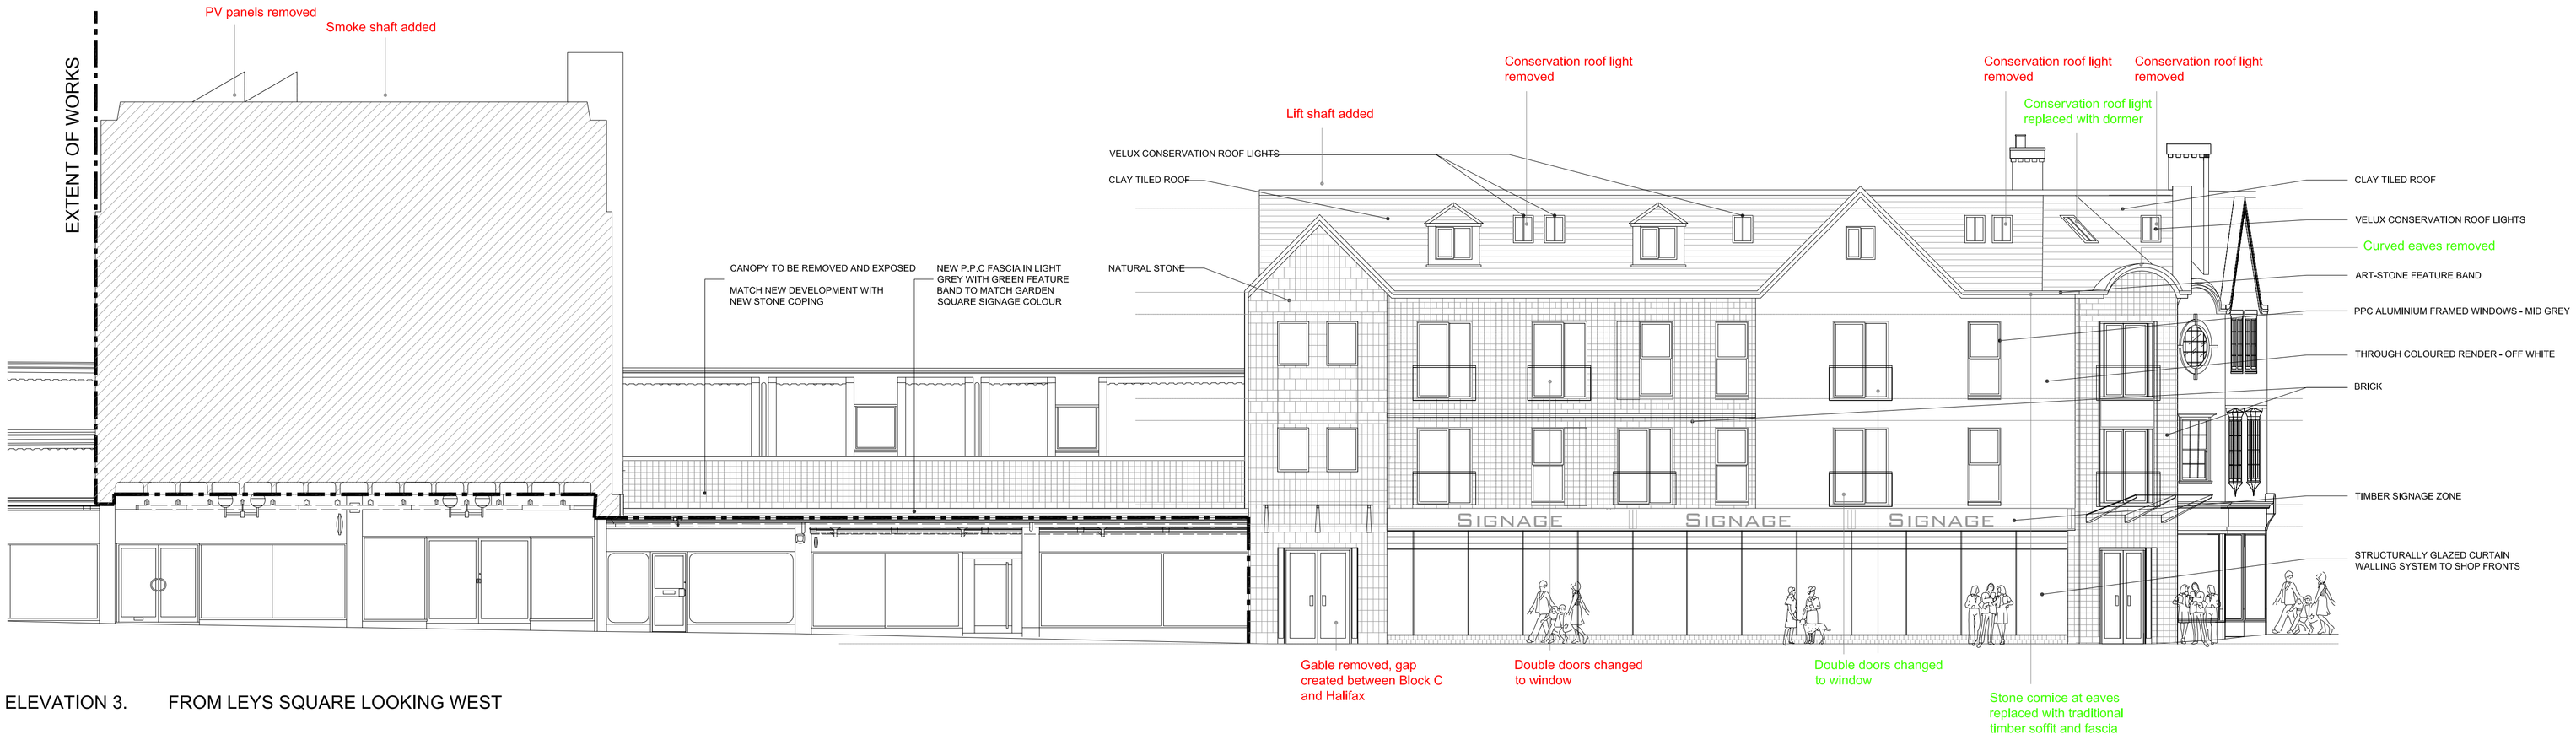

ELEVATION 3. FROM LEYS SQUARE LOOKING WEST



ELEVATION 4. FROM THE MALL

2015 NMA APPROVED CHANGES NOTED IN RED
2018 NMA REQUESTED CHANGES IN GREEN

NOTE: FINISHES TO BE AS NOTED OR EQUAL.

revision	date	drawn	description

status	Planning
date	08.05.2018
scale	1:100@a1
drawn	PD
checked	PD
project	Garden Square Letchworth
client	Sloane Projects Ltd
title	Proposed Elevations
job no.	SD1003
drawing no.	PL121
revision	

studio4design
architecture | project management | principal designer
100 Patrick Street, Derry City, BT48 7EL T. +442871 262184
© Executive Studio 4D Architects Ltd 2018