*General note: Minor relocation of windows throughout.

*General note: Window dimensions changed, equal opening lights added.

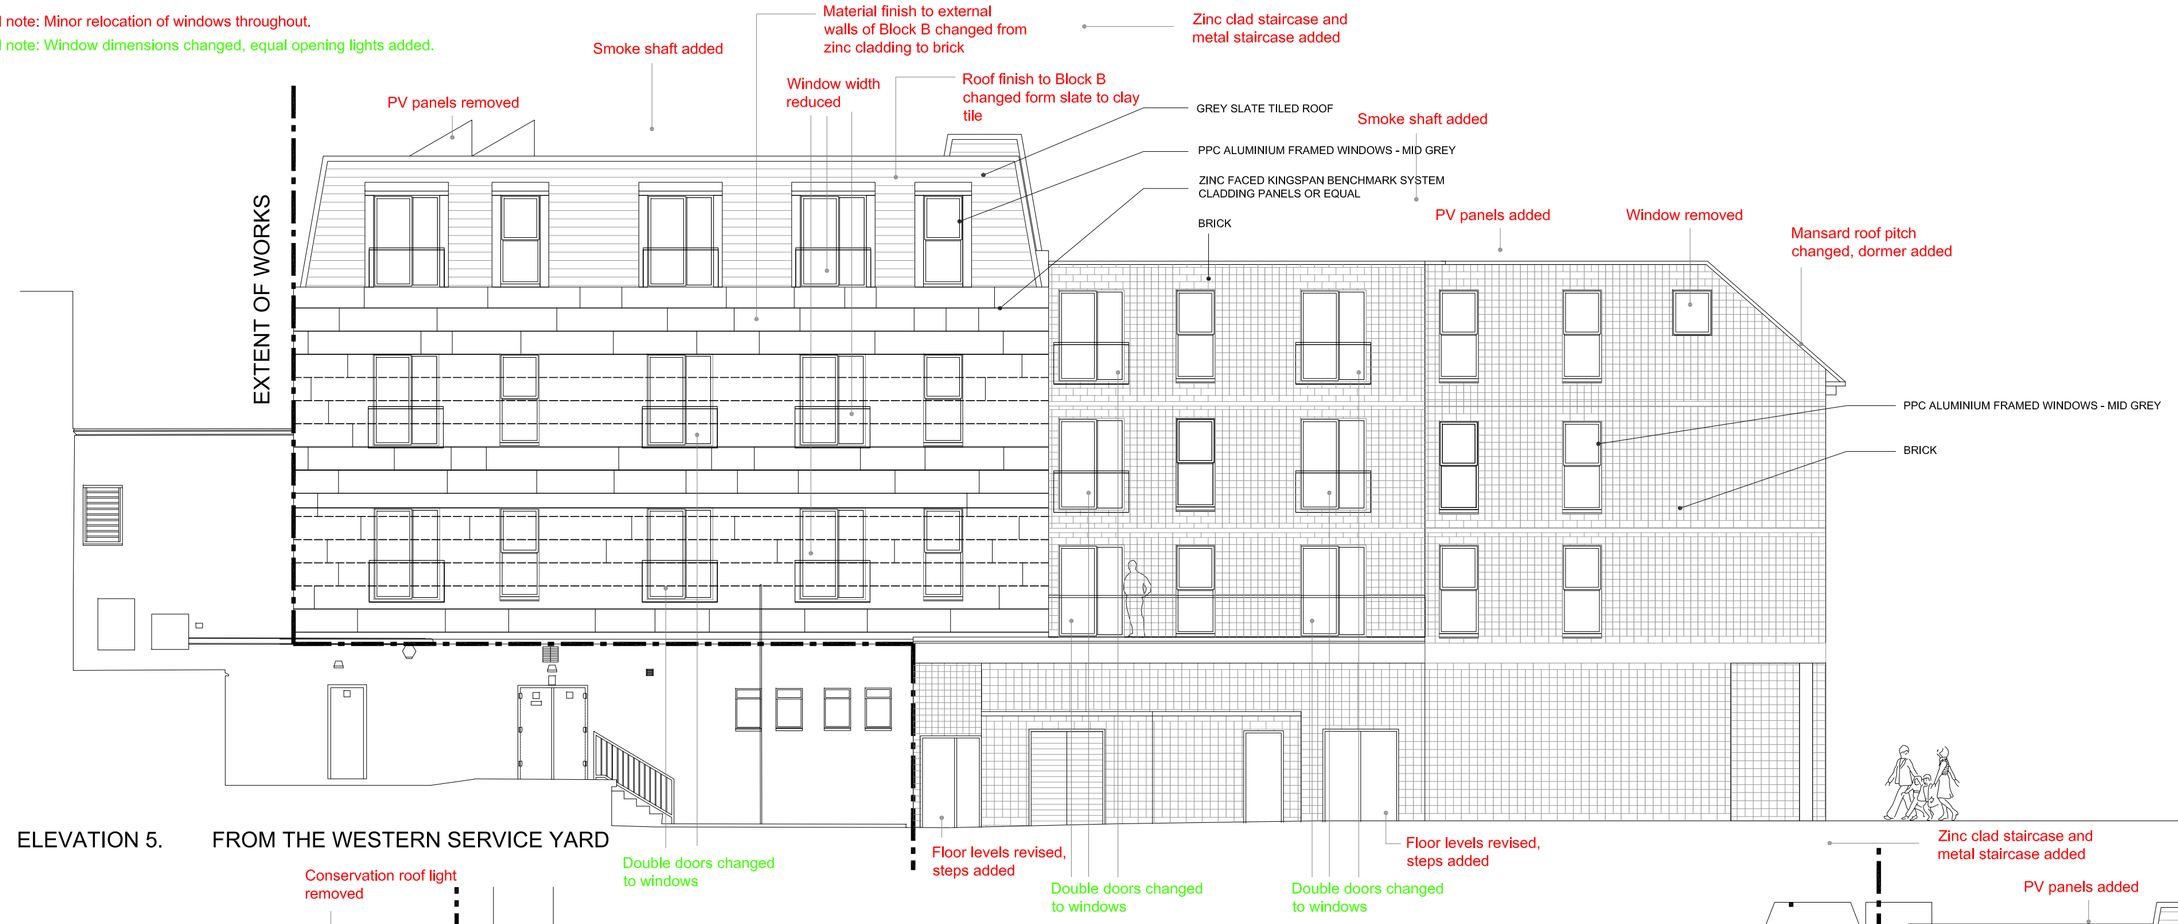

ELEVATION 5. FROM THE WESTERN SERVICE YARD

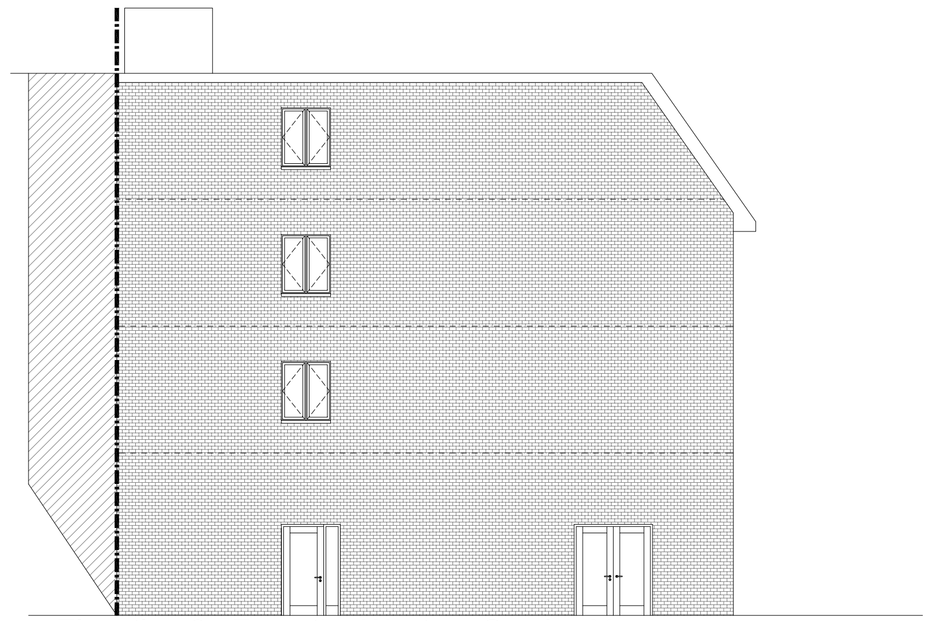

Elevation 8. From the Western Service Yard

SCALE 1:100

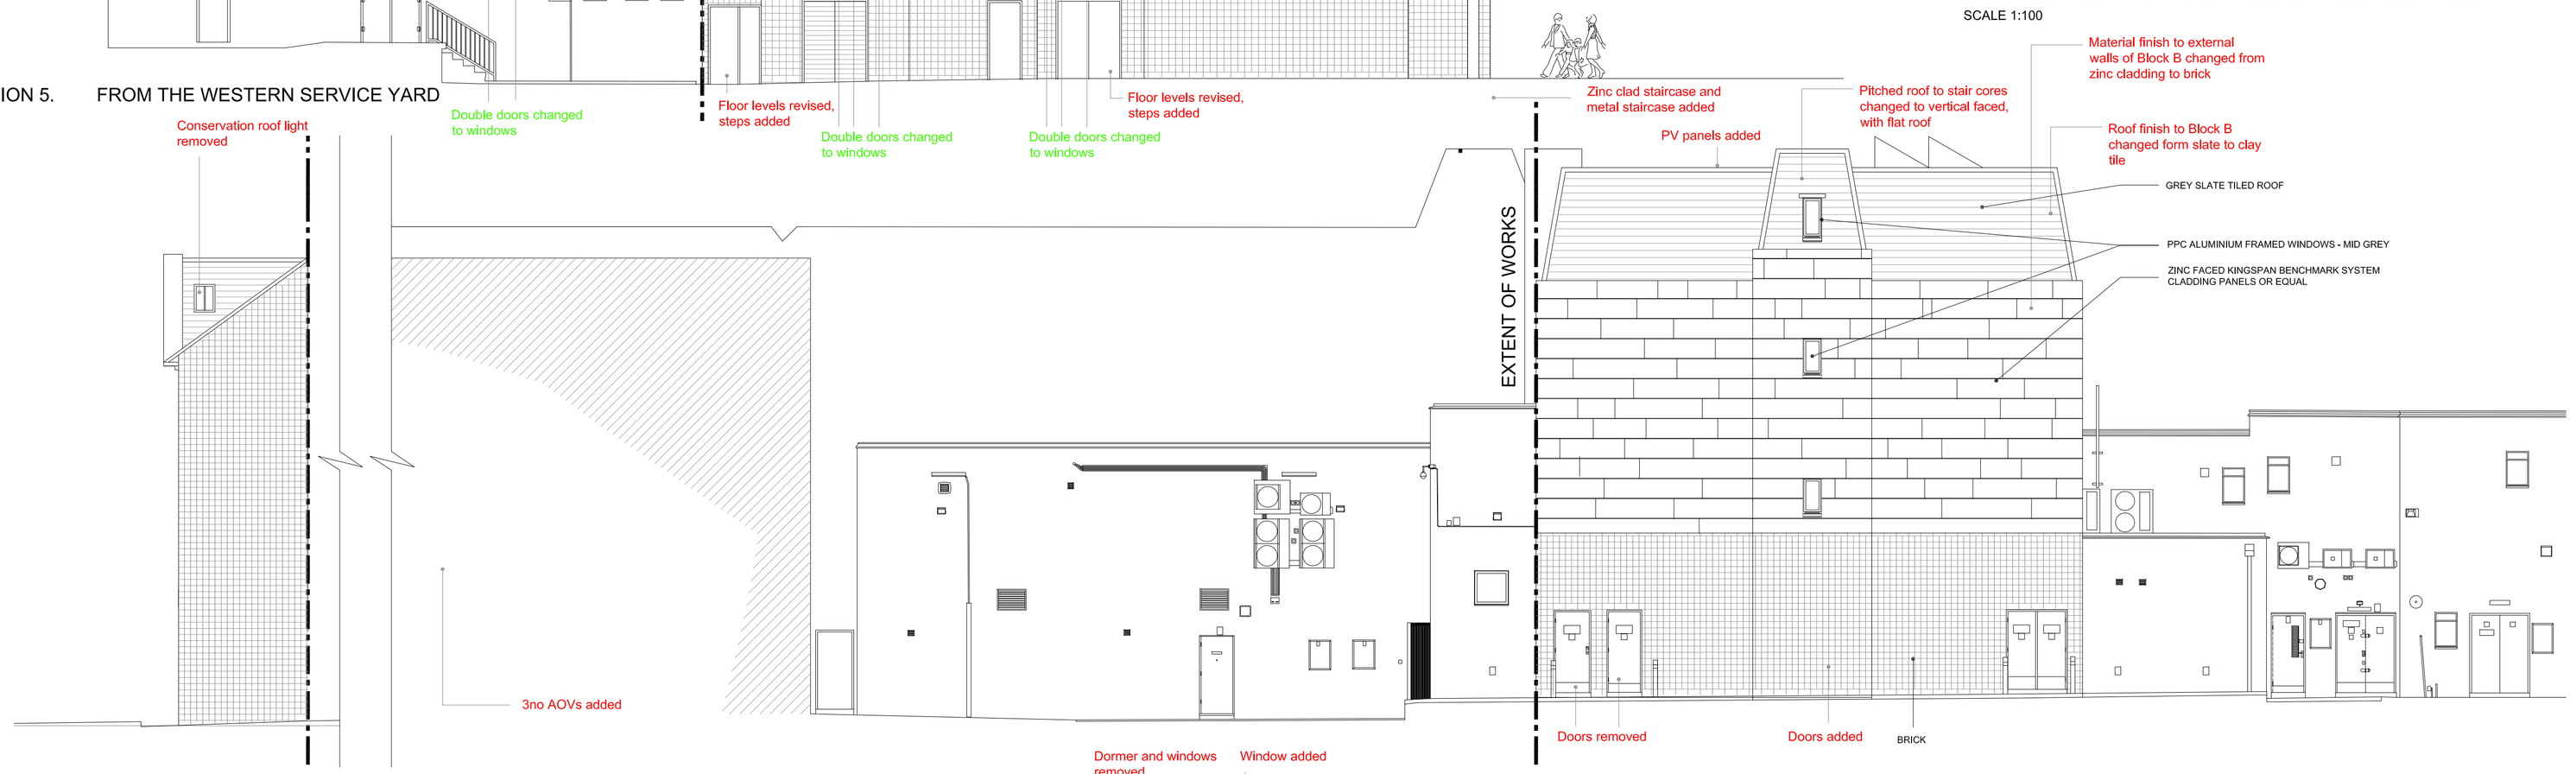

ELEVATION 6. FROM THE EASTERN SERVICE YARD



ELEVATION 7. FROM THE MALL ENTRANCE OFF LEYS SQUARE

2015 NMA APPROVED CHANGES NOTED IN RED
2018 NMA REQUESTED CHANGES IN GREEN

revision	date	drawn	description

NOTE: FINISHES TO BE AS NOTED OR EQUAL.

status	Planning	project	Garden Square Letchworth		
date	08.05.2018	client	Sloane Projects Ltd		
scale	1:100@a1	title	Proposed Elevations		
drawn	PD	job no.	SD1003		
checked	PD	drawing no.	PL122	revision	

studio4design

architecture | project management | principal designer

100 Patrick Street, Derry City, BT48 7EL T. +442871 262184

© Executive Studio 4D Architects Ltd 2018