Westbury
FARM

House No. 1

This barn conversion is predominantly single storey and provides 3 bedroom accommodation with the main bedroom suite located at first floor level. The dramatic entrance hall, with full height glazed screens, provides access to a large living room and the original oak timbers have been retained where possible. The generous kitchen/ [illegible]

APPROVED PLAN



Intended site of new doors

NORTH HERTFORDSHIRE DISTRICT COUNCIL
TOWN AND COUNTRY PLANNING ACTS
AS REFERRED TO IN
~~DECISION/~~CONSENT/APPROVAL/~~REFUSAL~~
Ref 03/01247/LBC
Date 12-9-03

24 JUL 2003
03/01247/LBC
PLANNING CONTROL

A Quality Development by
ENTERPRISE
HERITAGE
Conserving the Past · Creating the Future

House No. 1 is located on the south side of the development.

APPROVED PLAN



Scale 1:500

Westbury Farm Close,
Great Offley,
Nr. Hitchin
Hertfordshire

NORTH HERTFORDSHIRE DISTRICT COUNCIL
TOWN AND COUNTRY PLANNING ACTS
AS REFERRED TO IN
~~DECISION/~~CONSENT/APPROVAL/~~REFUSAL~~
Ref 03/01247/LBC
Date 12-9-03

24 JUL 2003
03/01247/LBC
PLANNING CONTROL