

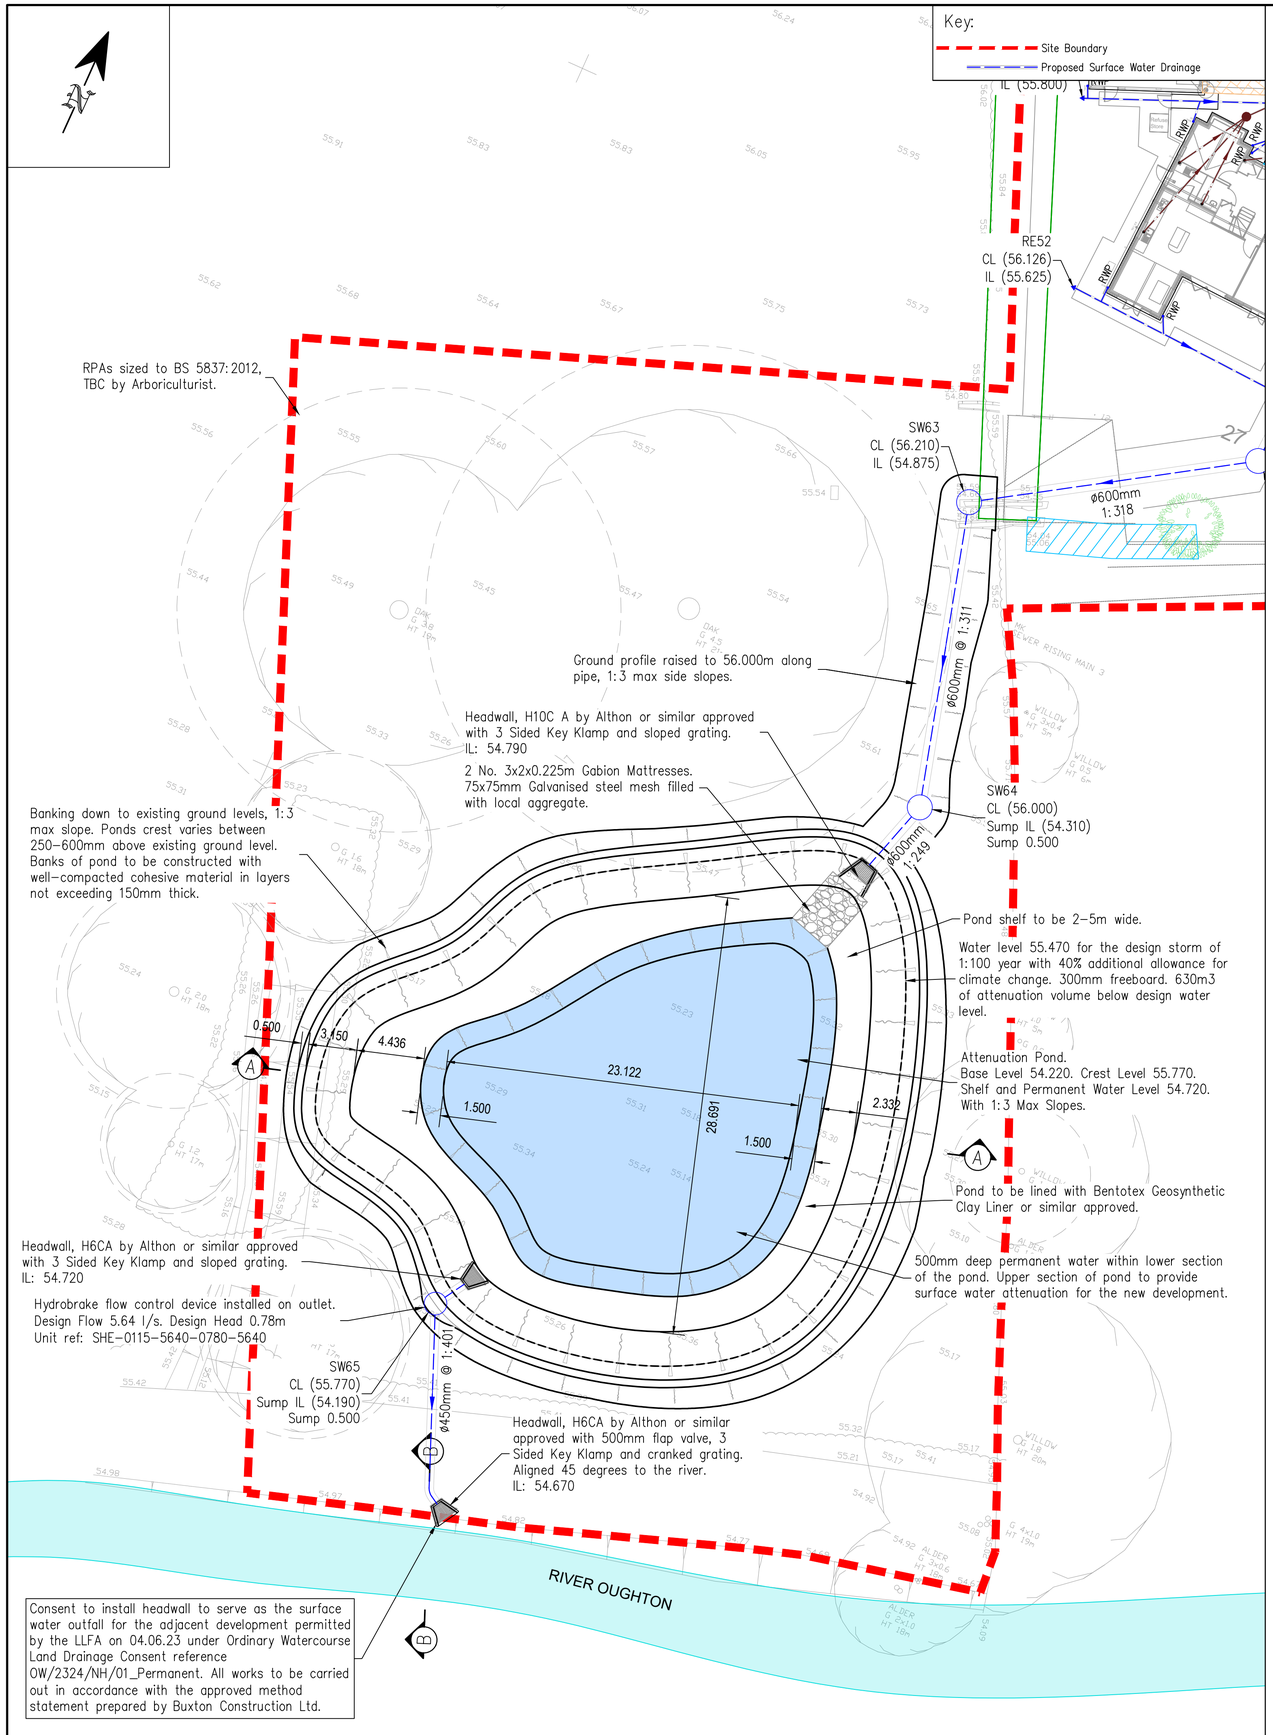


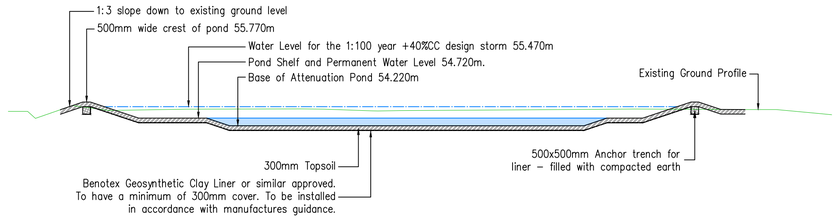

Attenuation Pond Section A–A
(1:200)

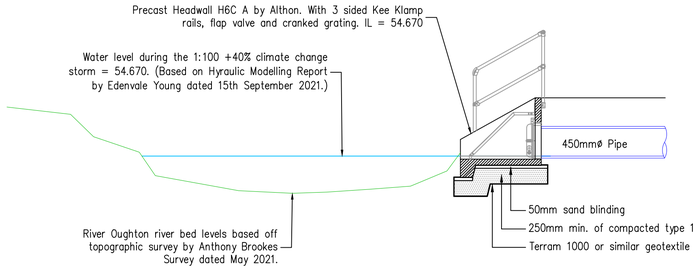

Outfall Headwall Section B–B
(1:50)

THIS IS A 'RECORD DRAWING'.
IT IS THE ISSUE OF A CONSTRUCTION DRAWING, WHICH INCLUDES THE INFORMATION THAT THE CONTRACTOR HAS SUPPLIED FORMALLY TO PTA TO SHOW THE CONTRACTOR'S "AS-BUILT" INFORMATION.
THIS INFORMATION HAS NOT BEEN VERIFIED BY PTA.
PTA HAVE RELIED UPON THE CONTRACTORS OBLIGATION TO CONSTRUCT GENERALLY IN ACCORDANCE WITH PTA'S DESIGN.

Notes:

1. Do not scale from this drawing.
2. In case of any discrepancies in drawings, details or bills, refer to engineers for clarification: unilateral decisions by the Contractor will not be accepted.
3. This drawing is to be read in conjunction with all related Architects, Consultants & Sub-Contractors drawings and specifications.
4. The Contractor is advised that all design drawings and information are to be read concurrently and any discrepancies or omissions reported directly to PTA's Civil Engineering Department.
5. This drawing is based upon the topographic survey by MKSurveys ref 26722–2 dated Jan. 2022 provided in digital format.

© Powell Tolner & Associates Ltd.
The contents of this drawing may not be reproduced in whole or in part without the prior written permission of Powell Tolner & Associates.

DRAWING STATUS
FOR CONSTRUCTION

REV	DESCRIPTION	BY	DATE	CHK'D
C04	Record Issue	TA	25.11.24	AH
C03	Headwall Rotated 45°	TA	07.07.23	AH
C02	Outfall Headwall Section Added	TA	05.05.23	AH
C01	Issued for Construction	TA	21.12.22	AH
P05	Site Boundary Updated	TA	03.08.22	AH
P04	Position of Outlet Headwalls Updated	TA	25.05.22	AH
P03	Manhole Numbers Updated	TA	13.05.22	AH
P02	Basin Shape and Depth Revised	TA	15.03.22	AH
P01	First Issue	TA	28.02.22	AH

PROJECT TITLE
Bedford Road, Ickleford
Hertfordshire

DRAWING TITLE
Attenuation Basin Layout and Section

DATE	Oct 2021	CHECKED DO	CHECKED ENG	PTA PROJ No
DRAWN	TA	TA	AH	9607
SCALE	1:200			REVISION
DRG SIZE	A1			C04

DRAWING No
00061-8103-C- SW - DR

Consulting Civil & Structural Engineers
pta
29 Red Lion Street
Chesham
Bucks
HP5 1EJ
Tel. 01494 772721
www.ptaconsult.co.uk