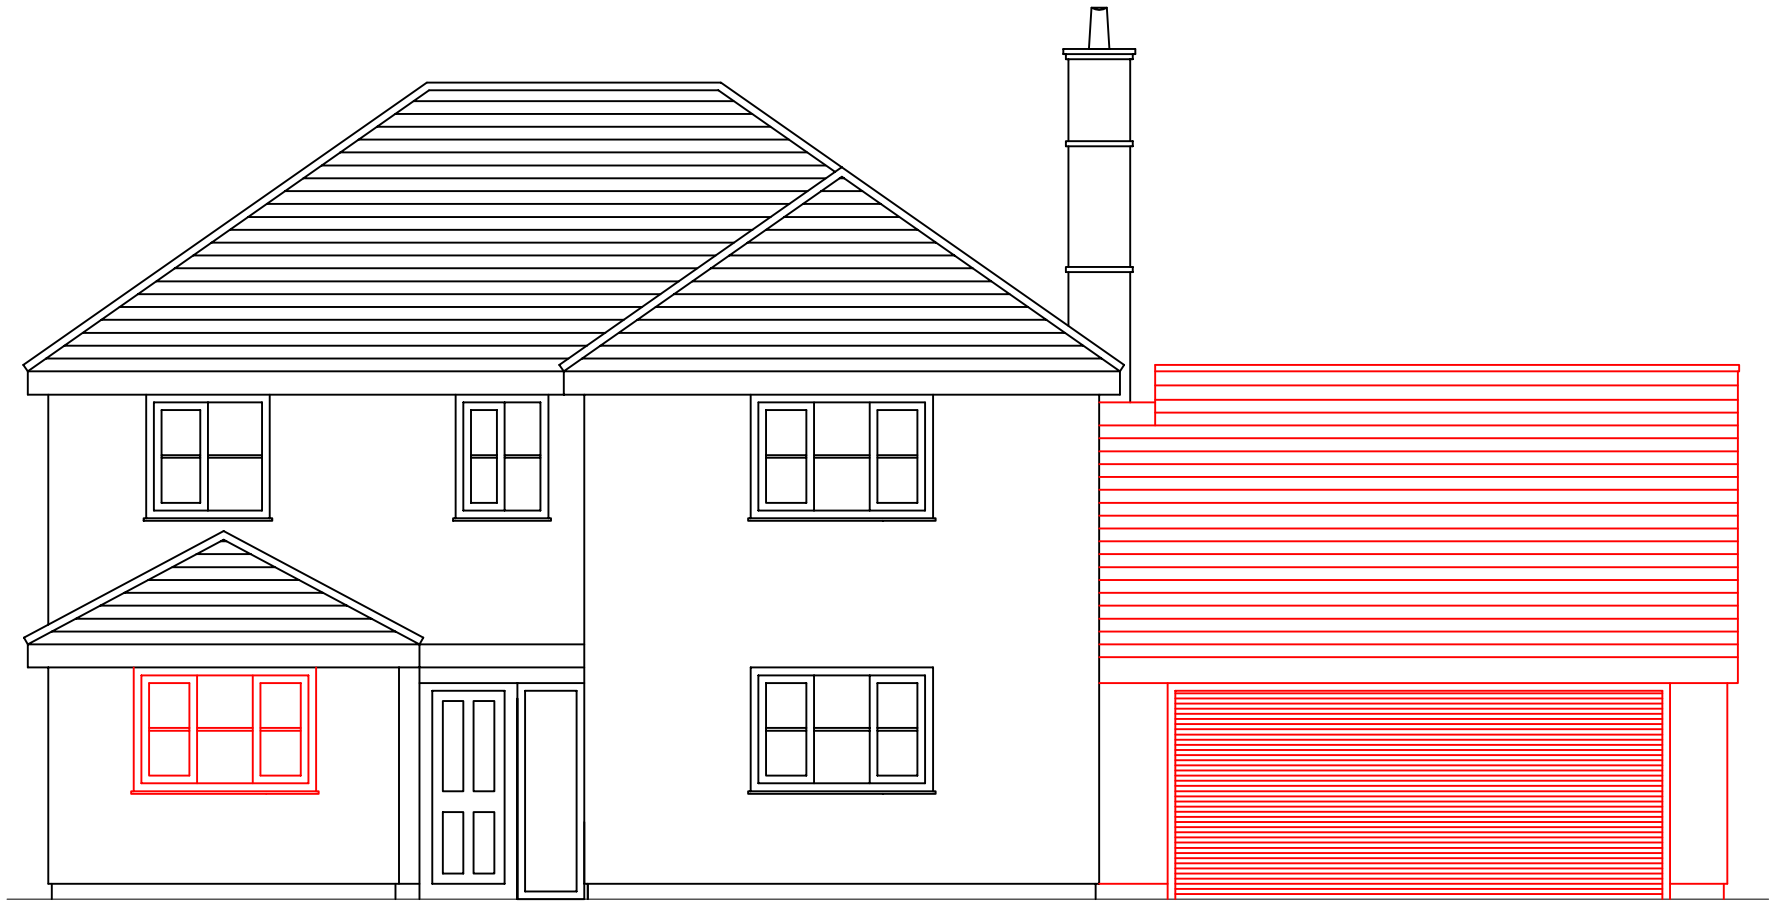

Proposed Front Elevation 1:75 Scale
(amendments shown in red)

All new materials to match existing



Front Elevation 1:50 Scale

1:2500	0		50m	100m	200m
1:1250	0		25m	50m	100m
1:500	0	5m	10m	20m	40m
1:200	0	2m	4m	8m	12m
1:100	0	1m	2m	4m	8m
1:50	0	0.5m	1m	2m	4m

NOTES

Rev	Amendments	By	Date

Mr & Mrs Dickinson
27A Heathfield
Royston
SG8 5BN

Drawn:	DJL	**Approved:**	
Scale:	1:75 & 1:50 @ A3	**Date:**	March 18

Title:

Proposed Front Elevation

Job: Heathfield, Royston

Drg No: HR/FE/103

Rev:

Issue Status:

PLANNING