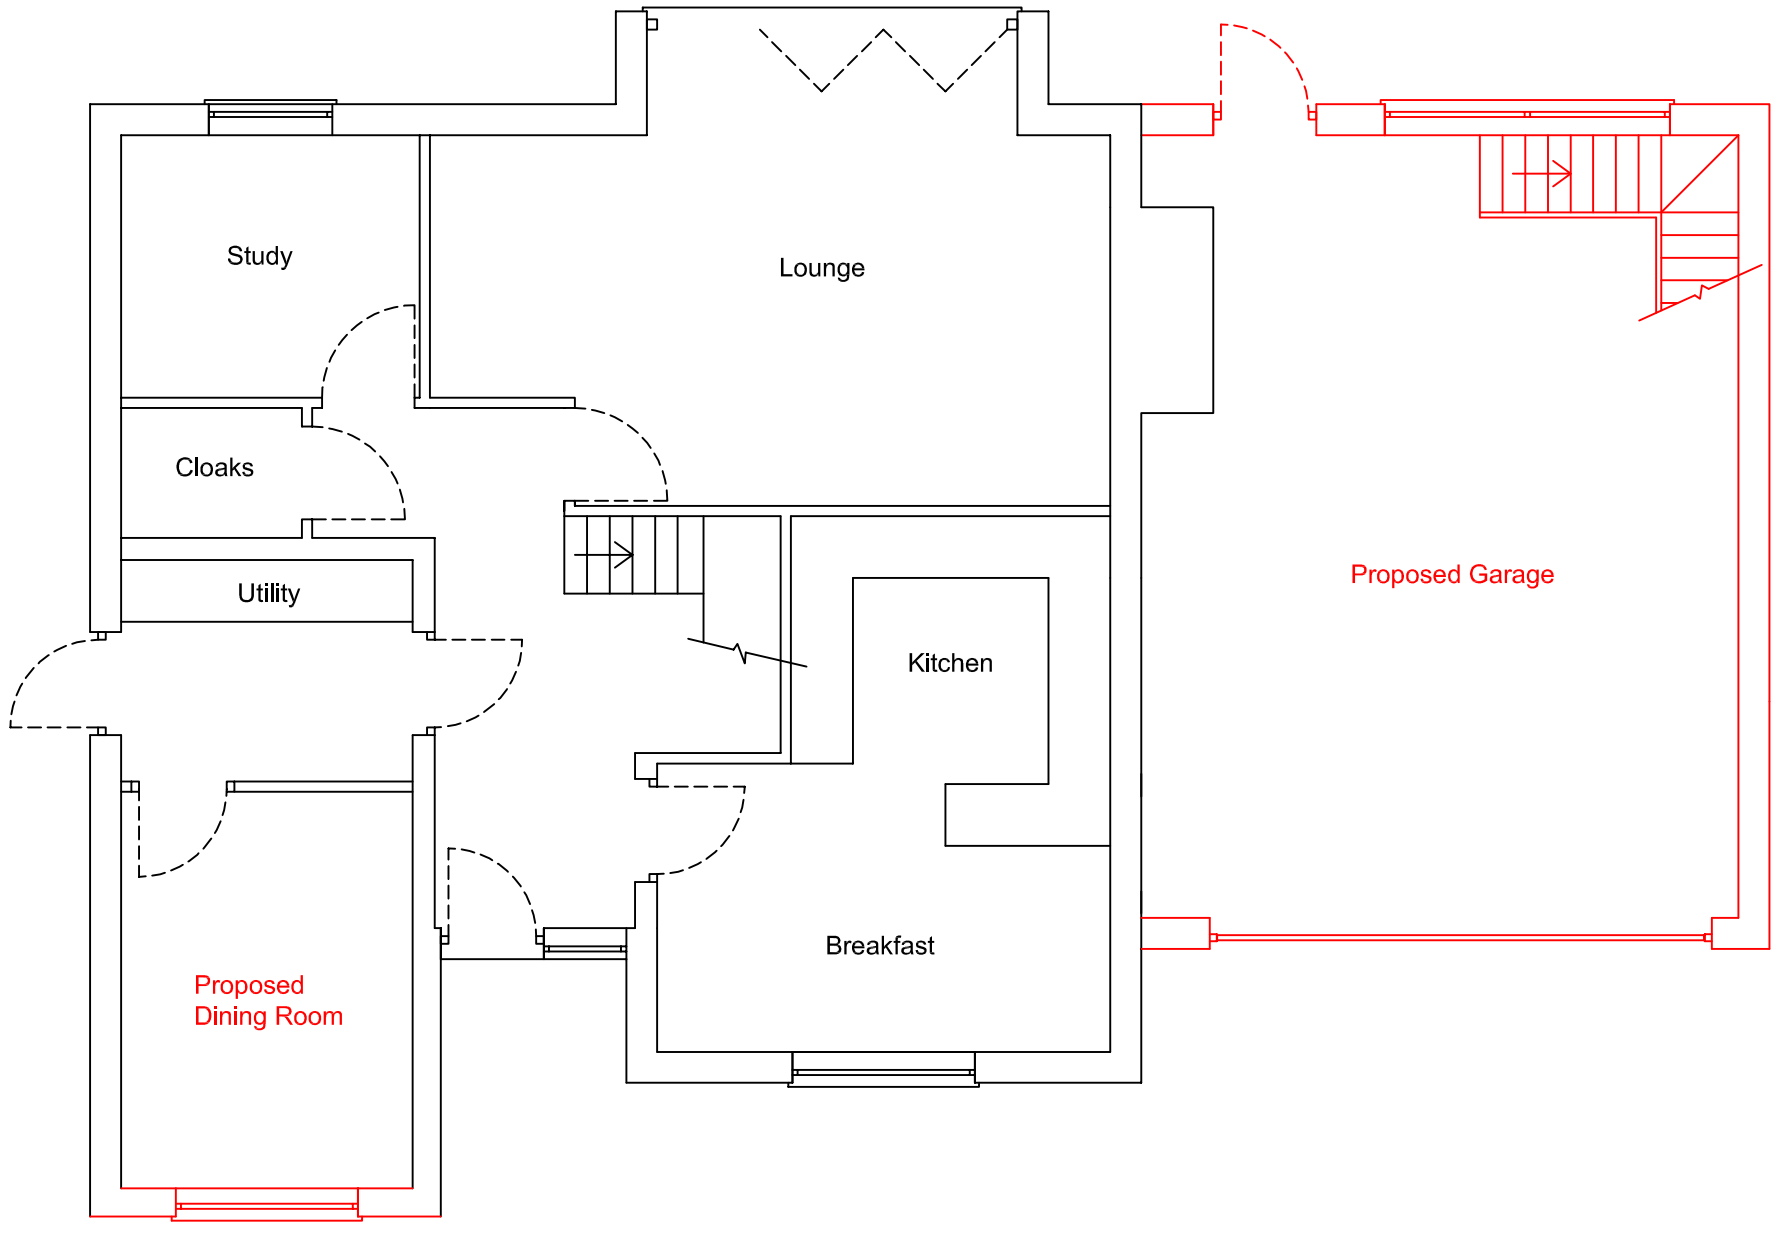


Proposed Ground Floor Plan
(amendments shown in red)

1:2500 0 | | 50m | 100m | 200m
1:1250 0 | 25m | 50m | 100m
1:500 0 | 5m | 10m | 20m | 40m
1:200 0 | 2m | 4m | 8m | 12m
1:100 0 | 1m | 2m | 4m | 8m
1:50 0 | 0.5m | 1m | 2m | 4m

**NOTES**

| Rev | Amendments | By | Date |
|---|---|---|---|

*Mr & Mrs Dickinson*
*27A Heathfield*
*Royston*
*SG8 5BN*

| | | | |
|---|---|---|---|
| **Drawn:** | DJL | **Approved:** | |
| **Scale:** | 1:75 @ A3 | **Date:** | March 18 |

**Title:**

Proposed Ground Floor Plan

**Job:** Heathfield, Royston

**Drg No:** HR/GF/101 **Rev:**

**Issue Status:**

**PLANNING**