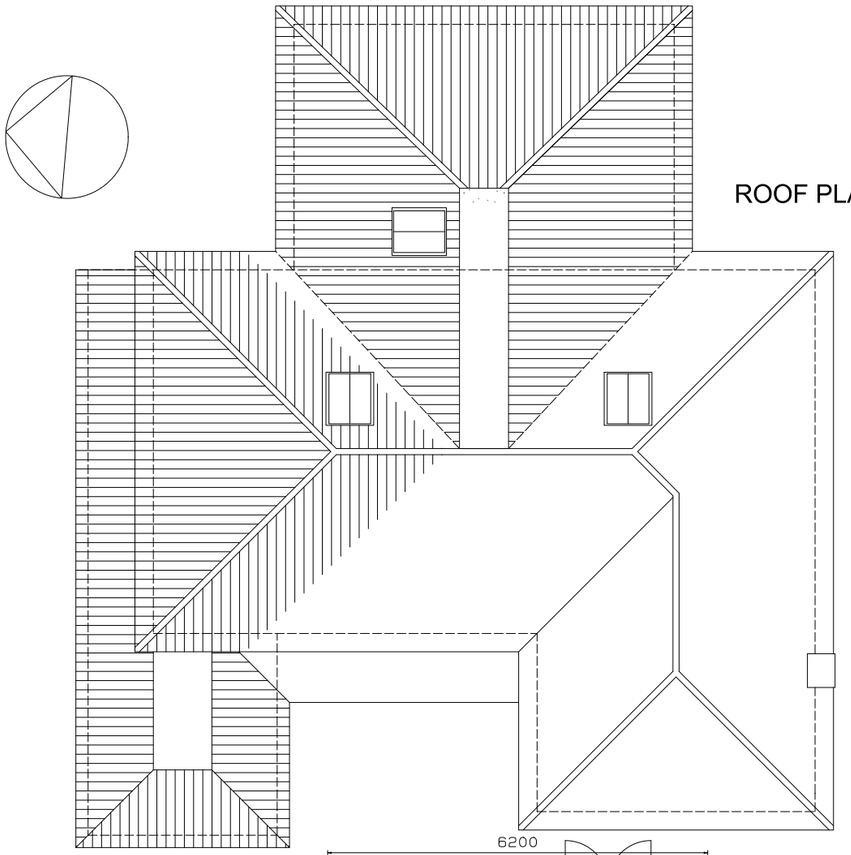

ROOF PLAN

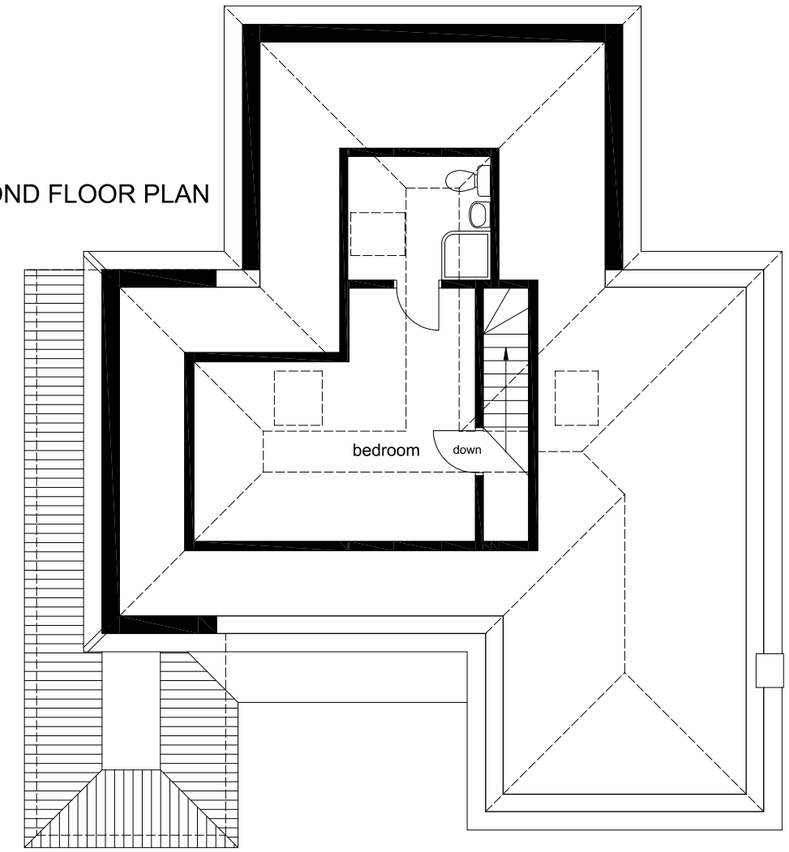

SECOND FLOOR PLAN

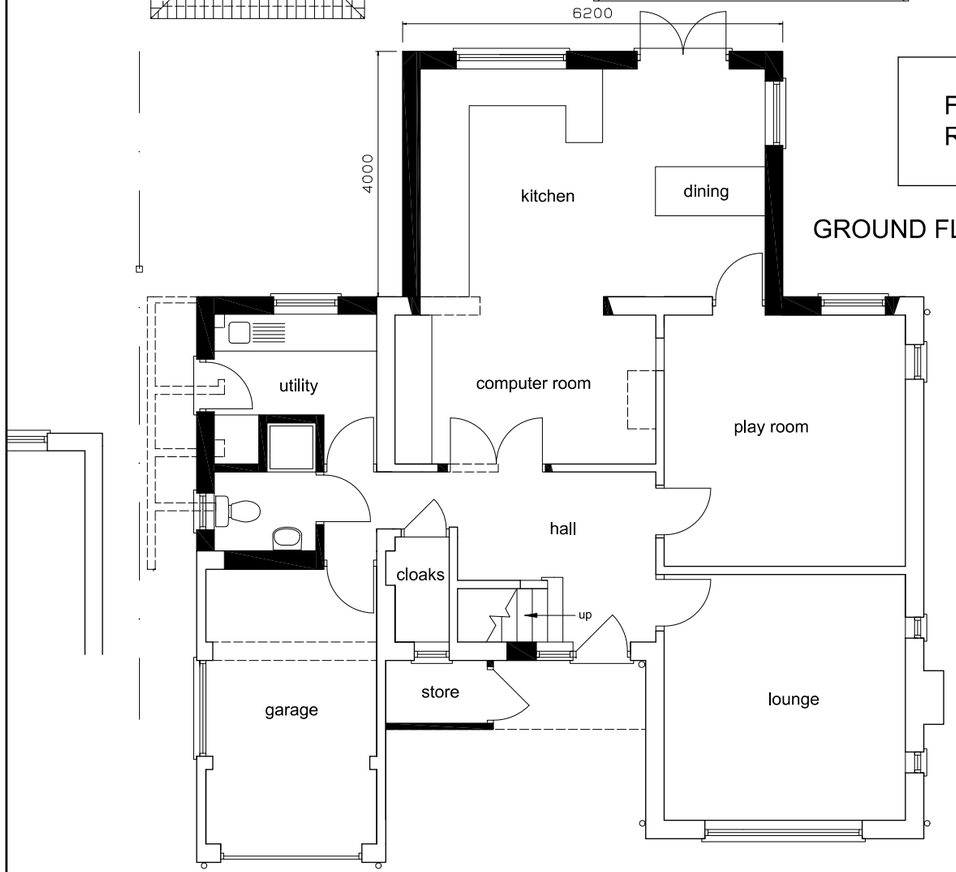

GROUND FLOOR PLAN

FOR DETAIL PLANS
REFER NCL/6, 7 & 8

FIRST FLOOR PLAN

Notes
1. DO NOT SCALE FROM THIS DRAWING
2. CHECK ALL DIMENSIONS ON SITE

NEW WALLS

WALLS REMOVED

WALLS EXISTING

0m. 3m.

ACTUAL SCALE

Revisions

A	SEP 16	BUILDING REGULATION REVISIONS ADDED
B	APR 18	AS BUILT AMENDMENTS

MORRIS & WEATHERALL
Chartered Architects

3 Maiden Street
Weston
Hitchin
Herts
SG4 7DG

tel: 01462 790401
fax: 01462 790726

Client

MRS NICHOL

Job title

PROPOSED EXTENSION
AND ALTERATIONS
AT
19 CLOISTERS ROAD
LETCHWORTH
HERTS.
SG6 3JR

Drawing title

PROPOSED PLANS

Scale	Date	Drawn
1:100	JUN 16	YBS

Drawing Number

NCL/3B